
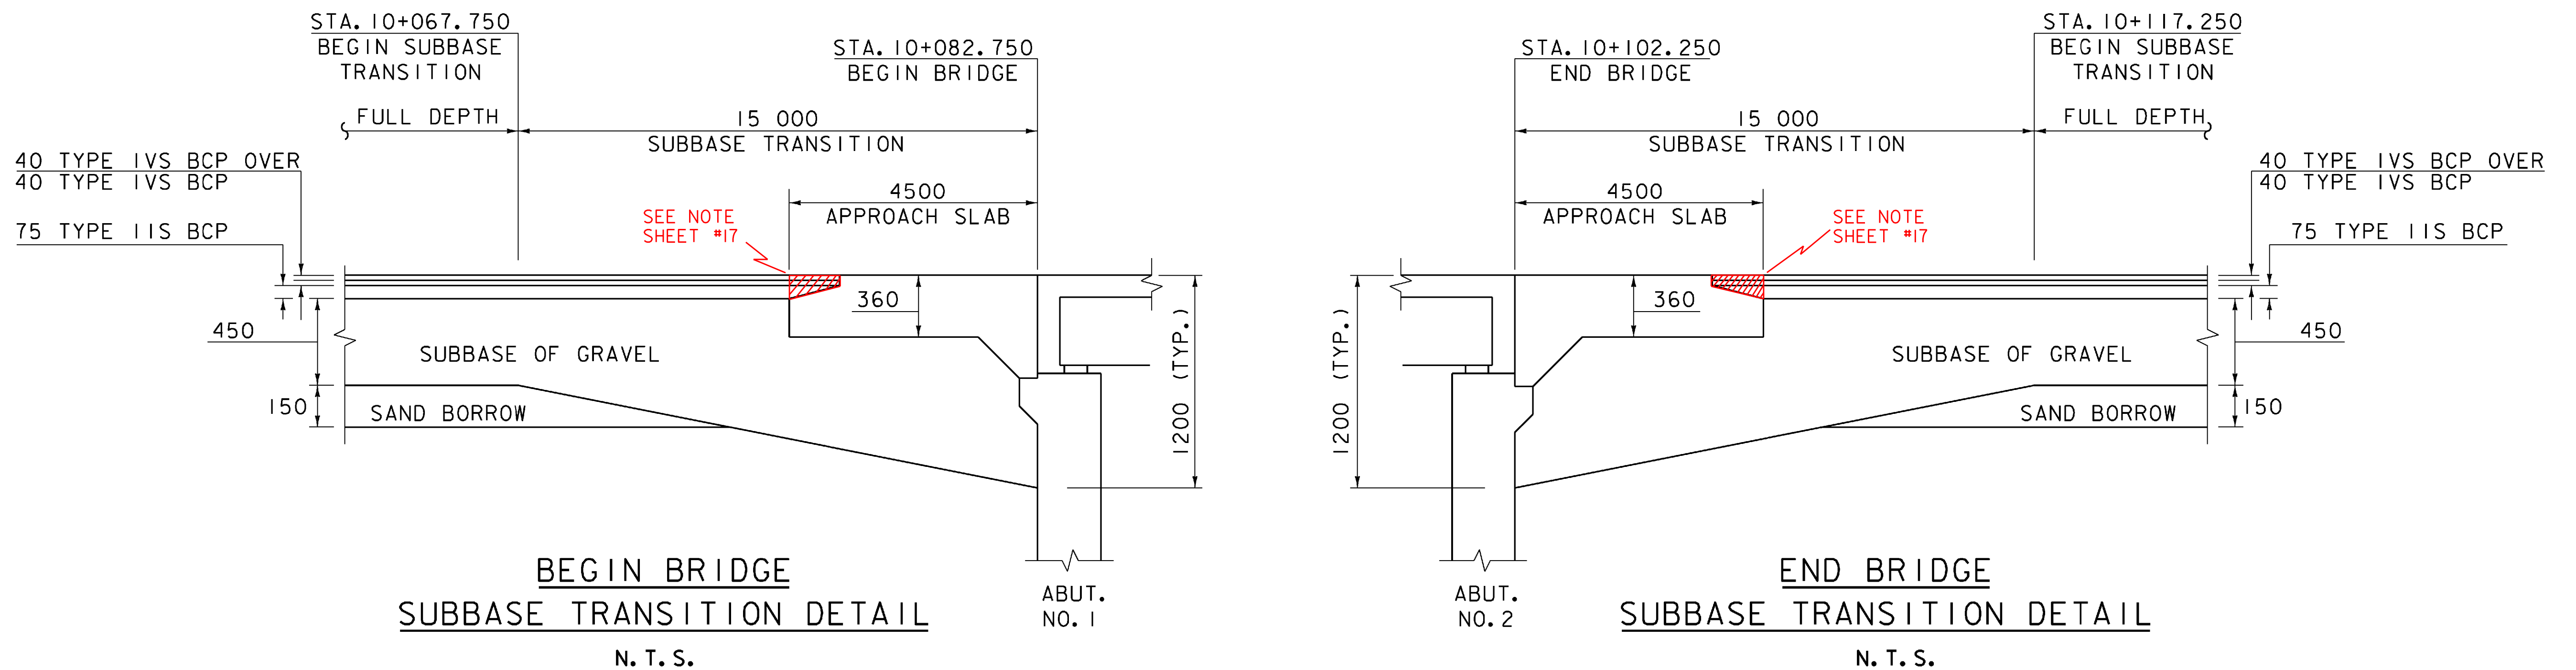


* BCP SHALL BE READ AS BITUMINOUS CONCRETE PAVEMENT AND SHALL BE PAID FOR UNDER ITEM 900.680 SPECIAL PROVISION (BITUMINOUS CONCRETE PAVEMENT, SMALL QUANTITY)

MATERIAL TRANSITION DETAIL

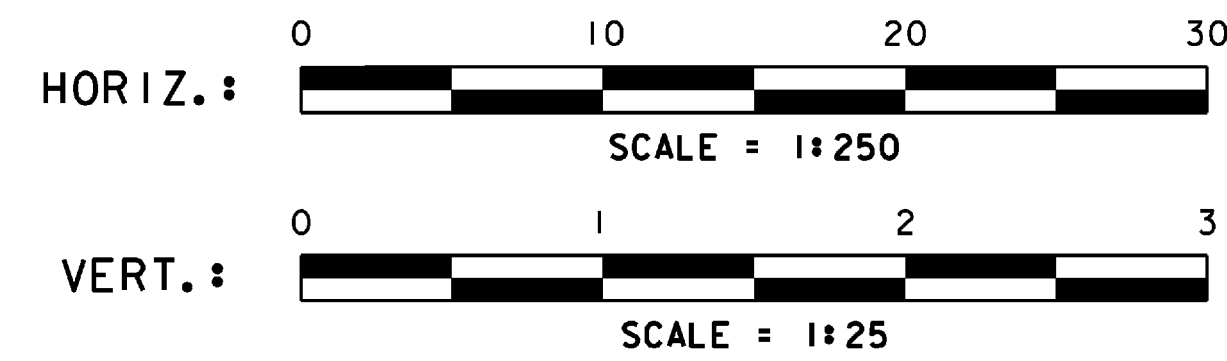

MATERIAL TRANSITION DETAILS

PROJECT NAME:	CRAFTSBURY
PROJECT NUMBER:	BRO 1449 (24)
FILE NAME:	96J310/str3/sj310xsl.dgn
PROJECT MANAGER:	R. R. WHITCOMB
DESIGNED BY:	G. ROY
sj310m+d.l	
PLOT DATE:	20-MAY-2009
DRAWN BY:	G. ROY
CHECKED BY:	W. LAMMER
SHEET	29 OF 47