


MAINLINE CROSS SECTIONS (1)

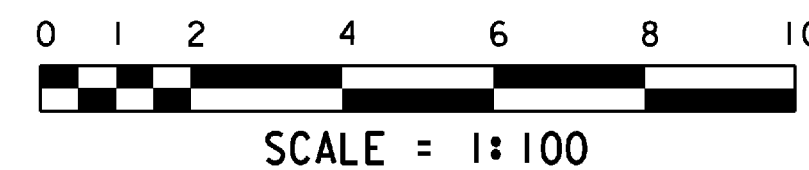

STA. 10+020 TO STA. 10+050

PROJECT NAME:	CRAFTSBURY	PLOT DATE:	04-JUN-2009
PROJECT NUMBER:	BRO 1449 (24)	DRAWN BY:	G. ROY
FILE NAME:	96J310\Structures\sj310m01.i	CHECKED BY:	W. LAMMER
PROJECT MANAGER:	R. R. WHITCOMB	DESIGNED BY:	G. ROY
			SHEET 30 OF 47