


MAINLINE CROSS SECTIONS (2)

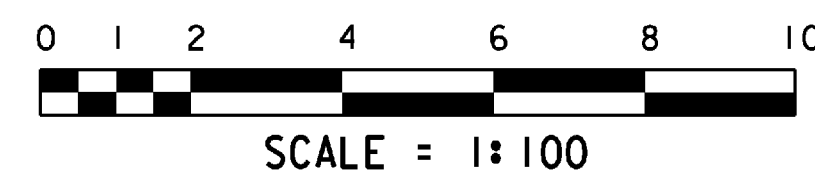

STA. 10+060 TO STA. 10+075

PROJECT NAME:	CRAFTSBURY	PLOT DATE:	04-JUN-2009
PROJECT NUMBER:	BRO 1449 (24)	DRAWN BY:	G. ROY
FILE NAME:	96J310\Structures\sj310m02.i	CHECKED BY:	W. LAMMER
PROJECT MANAGER:	R. R. WHITCOMB	DESIGNED BY:	G. ROY
			SHEET 31 OF 47