


MAINLINE CROSS SECTIONS (4)

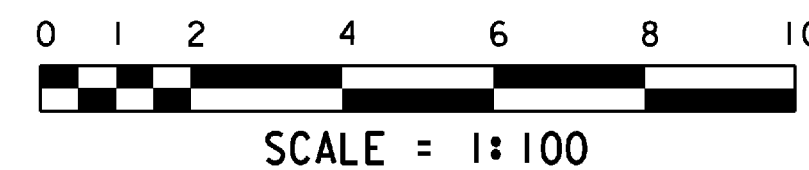

STA. 10+110 TO STA. 10+130

PROJECT NAME:	CRAFTSBURY	PLOT DATE:	04-JUN-2009
PROJECT NUMBER:	BRO 1449 (24)	DRAWN BY:	G. ROY
FILE NAME:	96J310\Structures\sj310m04.i	CHECKED BY:	W. LAMMER
PROJECT MANAGER:	R. R. WHITCOMB	DESIGNED BY:	G. ROY
			SHEET 33 OF 47