



STA. 50+030.0 LT & RT.  
 BEGIN UNCLASS. CHANNEL EXCAVATION  
 GEOTEXTILE UNDER STONE FILL  
 STONE FILL, TYPE III  
 GRUBBING MATERIAL

50+030

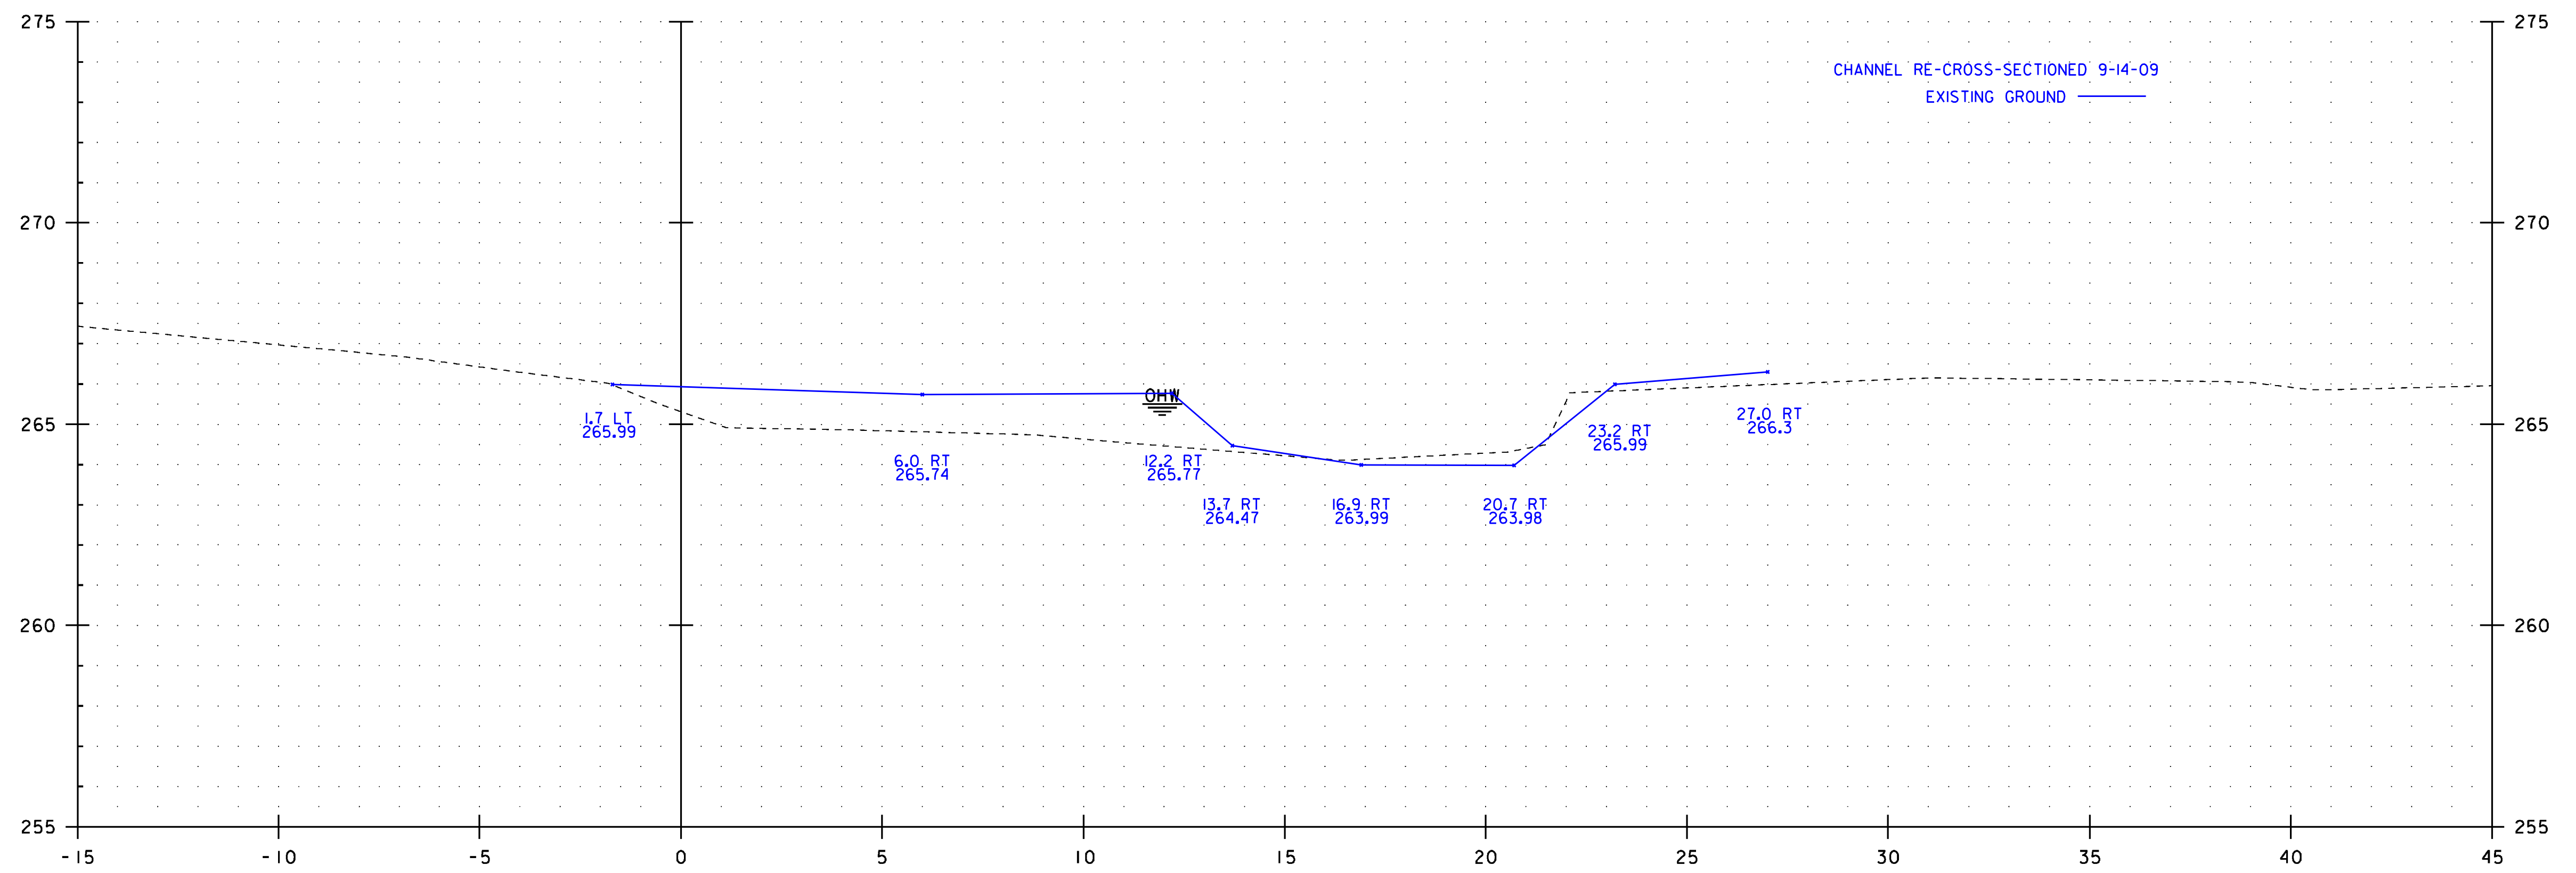

~~50+025~~  
 50+020

CHANNEL CROSS SECTIONS (1)

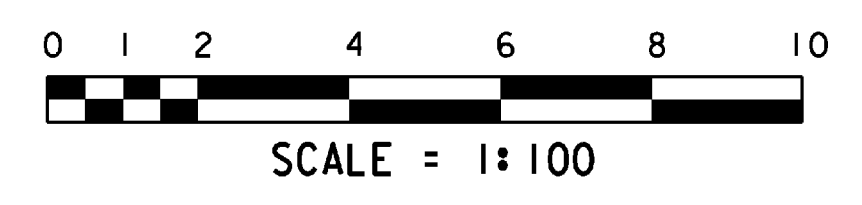

STA. 50+025 TO STA. 50+030

PROJECT NAME:	CRAFTSBURY	PLOT DATE:	20-MAY-2009
PROJECT NUMBER:	BRO 1449 (24)	DRAWN BY:	G. ROY
FILE NAME:	96J310\Structures\J310c01.I	CHECKED BY:	W. LAMMER
PROJECT MANAGER:	R. R. WHITCOMB	SHEET	35 OF 47
DESIGNED BY:	G. ROY		