


CHANNEL CROSS SECTIONS (2)

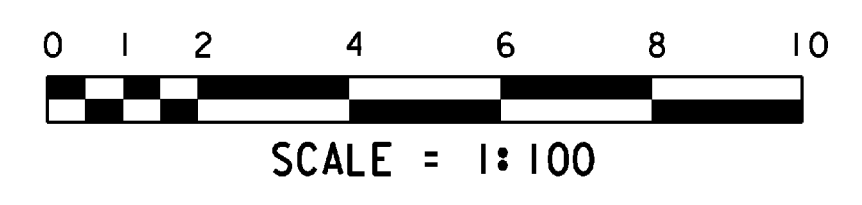

STA. 50+035 TO STA. 50+040

PROJECT NAME:	CRAFTSBURY	PLOT DATE:	20-MAY-2009
PROJECT NUMBER:	BRO 1449 (24)	DRAWN BY:	G. ROY
FILE NAME:	96J310\Structures\sj310c02.i	CHECKED BY:	W. LAMMER
PROJECT MANAGER:	R. R. WHITCOMB	SHEET	36 OF 47
DESIGNED BY:	G. ROY		