


CHANNEL CROSS SECTIONS (3)

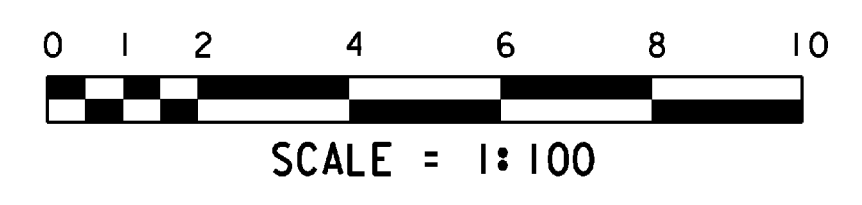

STA. 50+045 TO STA. 50+050

PROJECT NAME: CRAFTSBURY	
PROJECT NUMBER: BRO 1449 (24)	
FILE NAME: 96J310\Structures\sj310c03.i	PLOT DATE: 20-MAY-2009
PROJECT MANAGER: R. R. WHITCOMB	DRAWN BY: G. ROY
DESIGNED BY: G. ROY	CHECKED BY: W. LAMMER
	SHEET 37 OF 47