


CHANNEL CROSS SECTIONS (4)

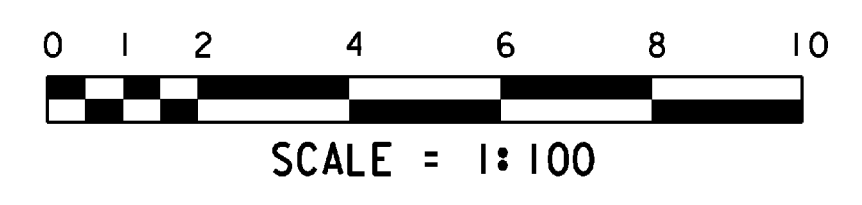

STA. 50+055 TO STA. 50+060

PROJECT NAME:	CRAFTSBURY	PLOT DATE:	04-JUN-2009
PROJECT NUMBER:	BRO 1449 (24)	DRAWN BY:	G. ROY
FILE NAME:	96J310\Structures\sj310c04.i	CHECKED BY:	W. LAMMER
DESIGNED BY:	G. ROY		
		SHEET	38 OF 47