


STA. 50+075.0 LT & RT.
 END UNCLASS. CHANNEL EXCAVATION
 GEOTEXTILE UNDER STONE FILL
 STONE FILL, TYPE III
 GRUBBING MATERIAL

CHANNEL CROSS SECTIONS (6)

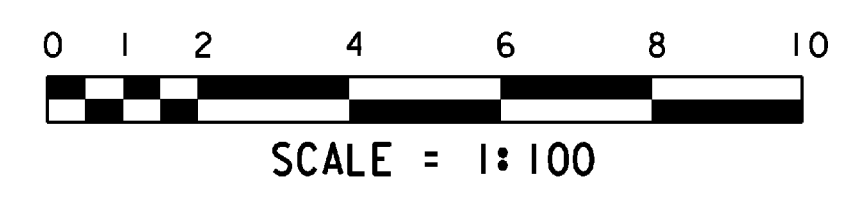

STA. 50+075 TO STA. 50+080

PROJECT NAME:	CRAFTSBURY
PROJECT NUMBER:	BRO 1449 (24)
FILE NAME:	96J310\Structures\sJ310c06.i
PROJECT MANAGER:	R. R. WHITCOMB
DESIGNED BY:	G. ROY
PLOT DATE:	20-MAY-2009
DRAWN BY:	G. ROY
CHECKED BY:	W. LAMMER
SHEET	40 OF 47