


SEE SHEET 2
FOR INDEX OF SHEETS

STATE OF VERMONT AGENCY OF TRANSPORTATION

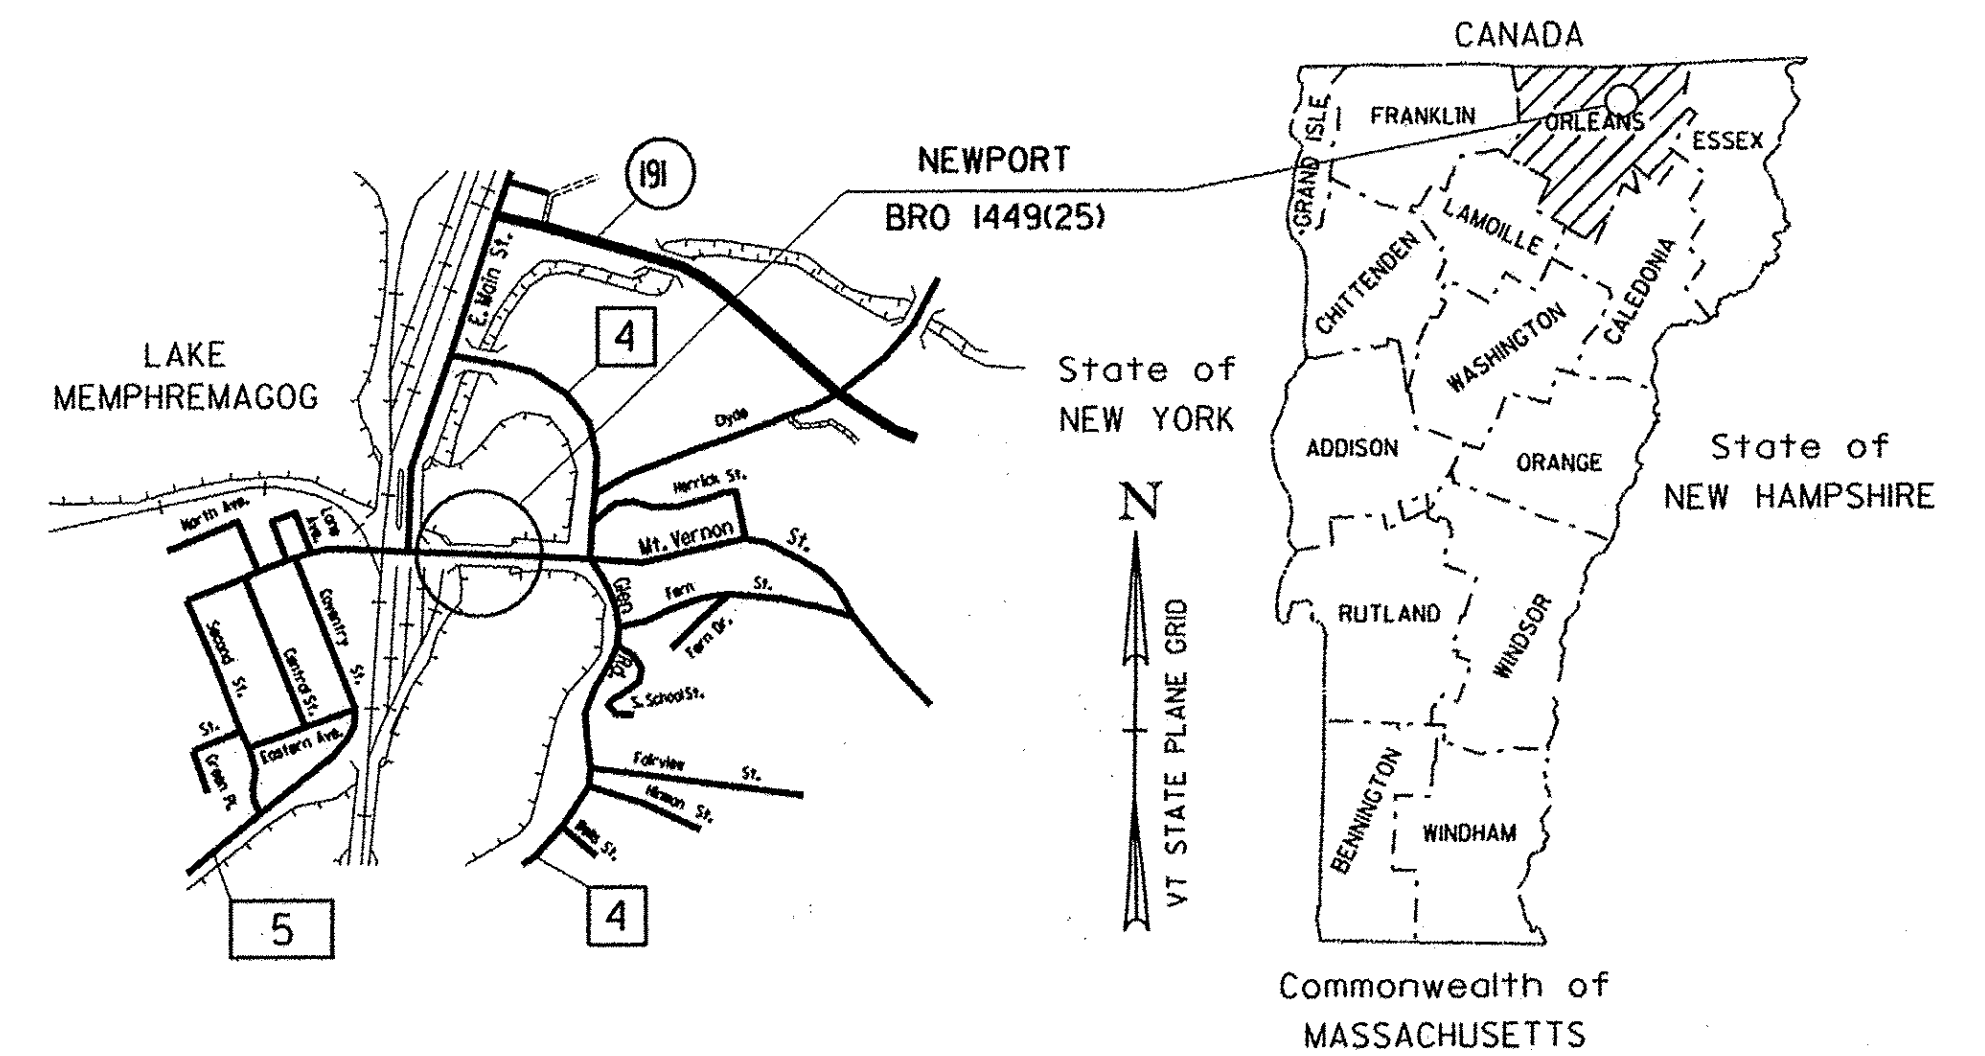


RECORD PLANS	
CONTRACTOR:	REED & REED, INC. - WOOLWICH, ME
RESIDENT ENGINEER:	CHRIS CRAIG
CONSTRUCTION BEGAN:	MARCH 5, 2012
CONSTRUCTION COMPLETE:	OCTOBER 8, 2013
RECORD PLANS BY:	CHRIS CRAIG & JENNA HYDE
I HEREBY CERTIFY THAT ALL THE CONSTRUCTION REQUIRED BY THIS SET OF DRAWINGS HAS BEEN ACCOMPLISHED AS INDICATED HEREIN.	
BY	RESIDENT ENGINEER
DATE <u>7-3-14</u>	
NOTE: Any further information concerning final quantities, amounts or other details relative to this project may be found at Central Files in the electronic archives.	

PROPOSED IMPROVEMENT

BRIDGE PROJECT NEWPORT CITY COUNTY OF ORLEANS

RAILROAD SQUARE, TH 11 (CLASS 2) MAJOR COLLECTOR, BRIDGE NO. 9

PROJECT LOCATION: BEGINNING APPROXIMATELY 0.05 MILES EAST OF THE INTERSECTION OF T.H. 11 (RAILROAD SQUARE) AND US ROUTE 5 (EAST MAIN STREET) AND PROCEEDING EASTERLY 0.102 MILES.
 PROJECT DESCRIPTION: REMOVAL OF EXISTING STRUCTURE, CONSTRUCTION OF NEW 3 SPAN CONTINUOUS COMPOSITE STEEL GIRDER SUPERSTRUCTURE, NEW ABUTMENTS AND PIERS, AND RELATED ROADWAY WORK.
 LENGTH OF STRUCTURE: 299.66 FEET = 0.06 MILES
 LENGTH OF ROADWAY: 237.84 FEET = 0.045 MILES
 LENGTH OF PROJECT: 537.50 FEET = 0.102 MILES

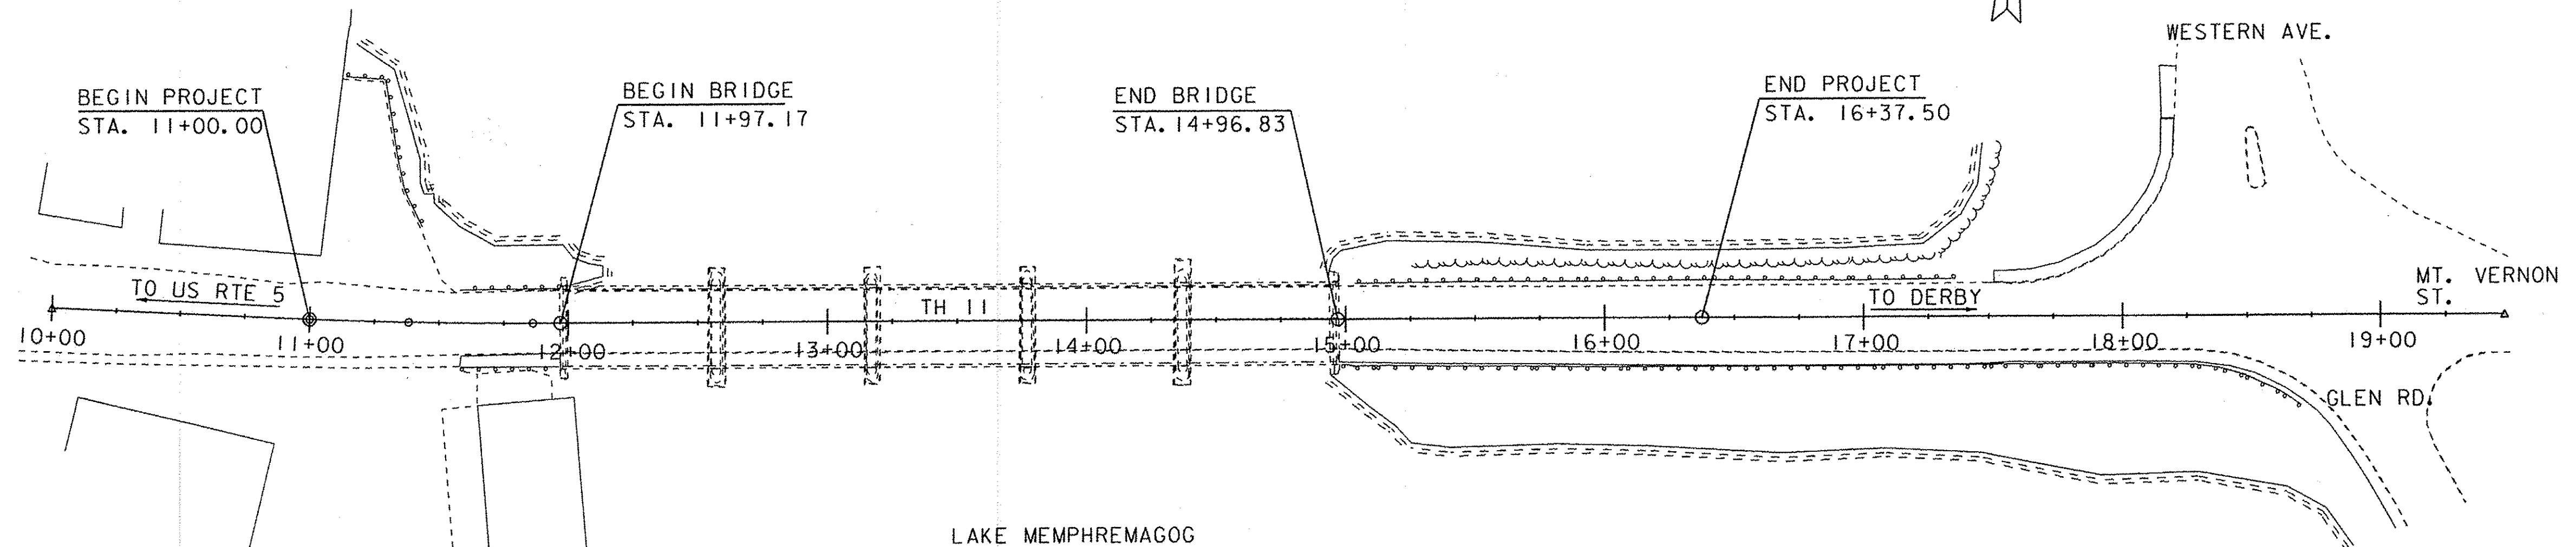

QUALITY ASSURANCE PROGRAM: LEVEL 2

CONVENTIONAL SYMBOLS	
COUNTY LINE	
TOWN LINE	
LIMITS OF ACCESS	
POINT OF ACCESS	
FENCE LINE	
STONE WALL	
TRAVELED WAY	
GUARD RAIL	
RAILROAD	
SURVEY LINE	
CULVERT	
POWER POLE	
TELEPHONE POLE	
TREES	
CONTROL OF ACCESS	
PROPERTY LINE	
R.O.W. TAKING LINE	
SLOPE RIGHTS	
TOP OF CUT	
TOE OF SLOPE	

SURVEYED BY :	R. GILMAN
SURVEYED DATE :	12/07/2000
DATUM	
VERTICAL	NAVD 88
HORIZONTAL	NAD 83 (96)

SCALE 1" = 40'-0"
40 0 40

THESE PLANS ARE SUBJECT TO SUCH ENGINEERING CHANGES AS MAY BE REQUIRED BY THE FEDERAL HIGHWAY ADMINISTRATION OR THE DIRECTOR OF PROGRAM DEVELOPMENT.
 CONSTRUCTION IS TO BE CARRIED ON IN ACCORDANCE WITH THESE PLANS AND THE STANDARD SPECIFICATIONS FOR CONSTRUCTION DATED 2006, AS APPROVED BY THE FEDERAL HIGHWAY ADMINISTRATION ON JUNE 15, 2006 FOR USE ON THIS PROJECT, INCLUDING ALL SUBSEQUENT REVISIONS AND SUCH REVISED SPECIFICATIONS AND SPECIAL PROVISIONS AS ARE INCORPORATED IN THESE PLANS.

DIRECTOR OF PROGRAM DEVELOPMENT	
APPROVED	DATE <u>11-15-11</u>
PROJECT MANAGER : C. CARLSON	
PROJECT NAME :	NEWPORT CITY
PROJECT NUMBER :	BRO 1449 (25)
SHEET 1	OF 75 SHEETS