

REMOVAL AND DISPOSAL OF GUARDRAIL

15+50.00 RT - 18+69.06 RT
15+50.00 LT - 17+35.34 LT

CAST-IN-PLACE CONCRETE CURB, TYPE B

15+50.00 RT - 17+75.00 RT
17+50.25 LT - 17+75.00 LT

PORTLAND CEMENT CONCRETE SIDEWALK, 5 INCH

15+50.00 RT - 17+75.00 RT
17+50.25 LT - 17+75.00 LT

SPECIAL PROVISION (BOX BEAM GUARDRAIL, PAINTED)

15+50.00 RT - 18+77.80 RT
15+50.00 LT - 17+56.13 LT

SIDEWALK RAMP, TYPE 6

17+52.40 LT
17+52.40 RT

PRECAST REINFORCED CONCRETE PIPE DI WITH CAST IRON GRATE

16+21.33 RT

PULL BOX

16+53.00 RT

DETECTABLE WARNING SURFACE



17+52.40 LT
17+52.40 RT

SPECIAL PROVISION (DUCT BANK) (13 CONDUIT)

15+50.00 RT - 16+53.43 RT
ELECTRICAL CONDUIT (2") (PVC)

16+48.87 RT - 18+53.04 RT
~~ELECTRICAL CONDUIT (5") (PVC)~~
~~16+54.91 RT - 16+59.78 RT~~

MATCH LINE STA. 15+50.00
MATCH LINE STA. 15+50.00

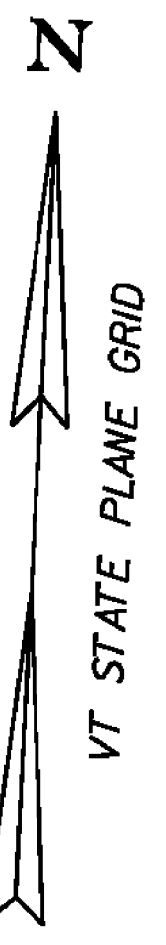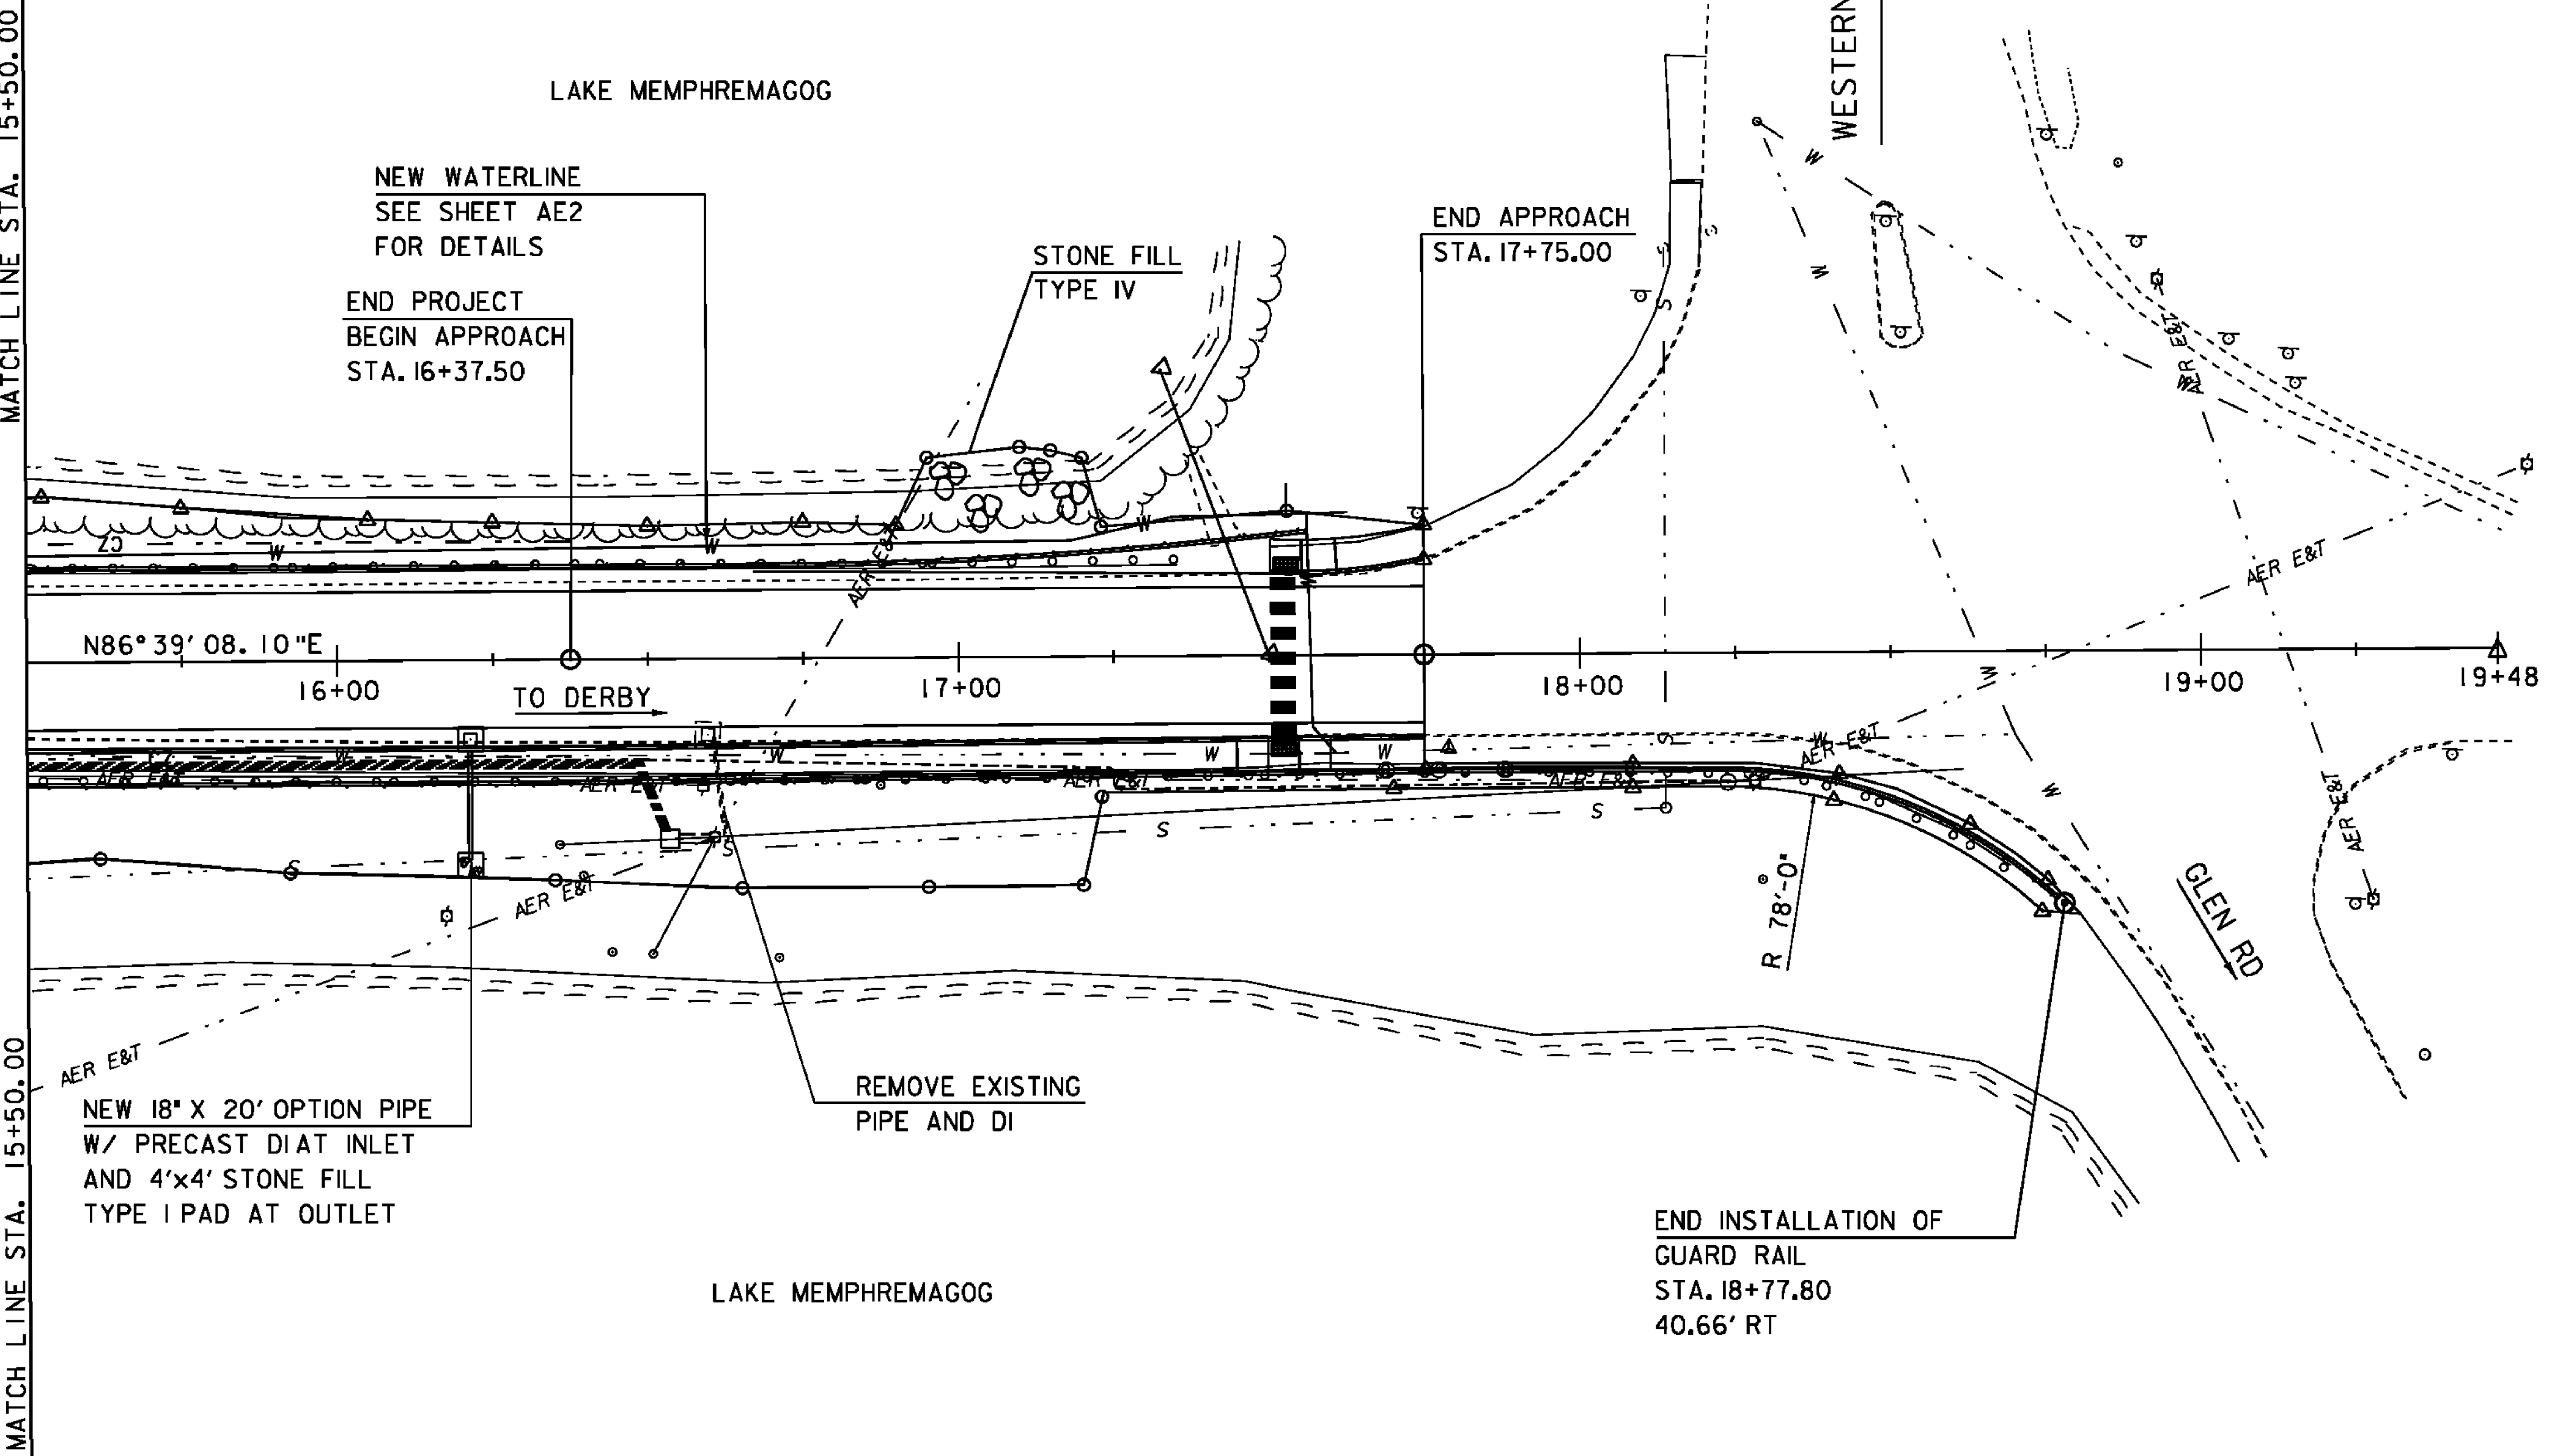

SCALE 1" = 20'-0"
20 0 20

PROJECT NAME: NEWPORT CITY	PLOT DATE: 02-DEC-2011
PROJECT NUMBER: BRO 1449(25)	DRAWN BY: C. MOONEY
FILE NAME: 96j314\str\s96j314bdr.dgn	DESIGNED BY: D. PETERSON
PROJECT LEADER: C. CARLSON	CHECKED BY: C. CARLSON
PLAN SHEET 2	SHEET 11 OF 75