


INTEGRAL ABUTMENT NO. 1 PLAN
SCALE 1/2"=1'-0"

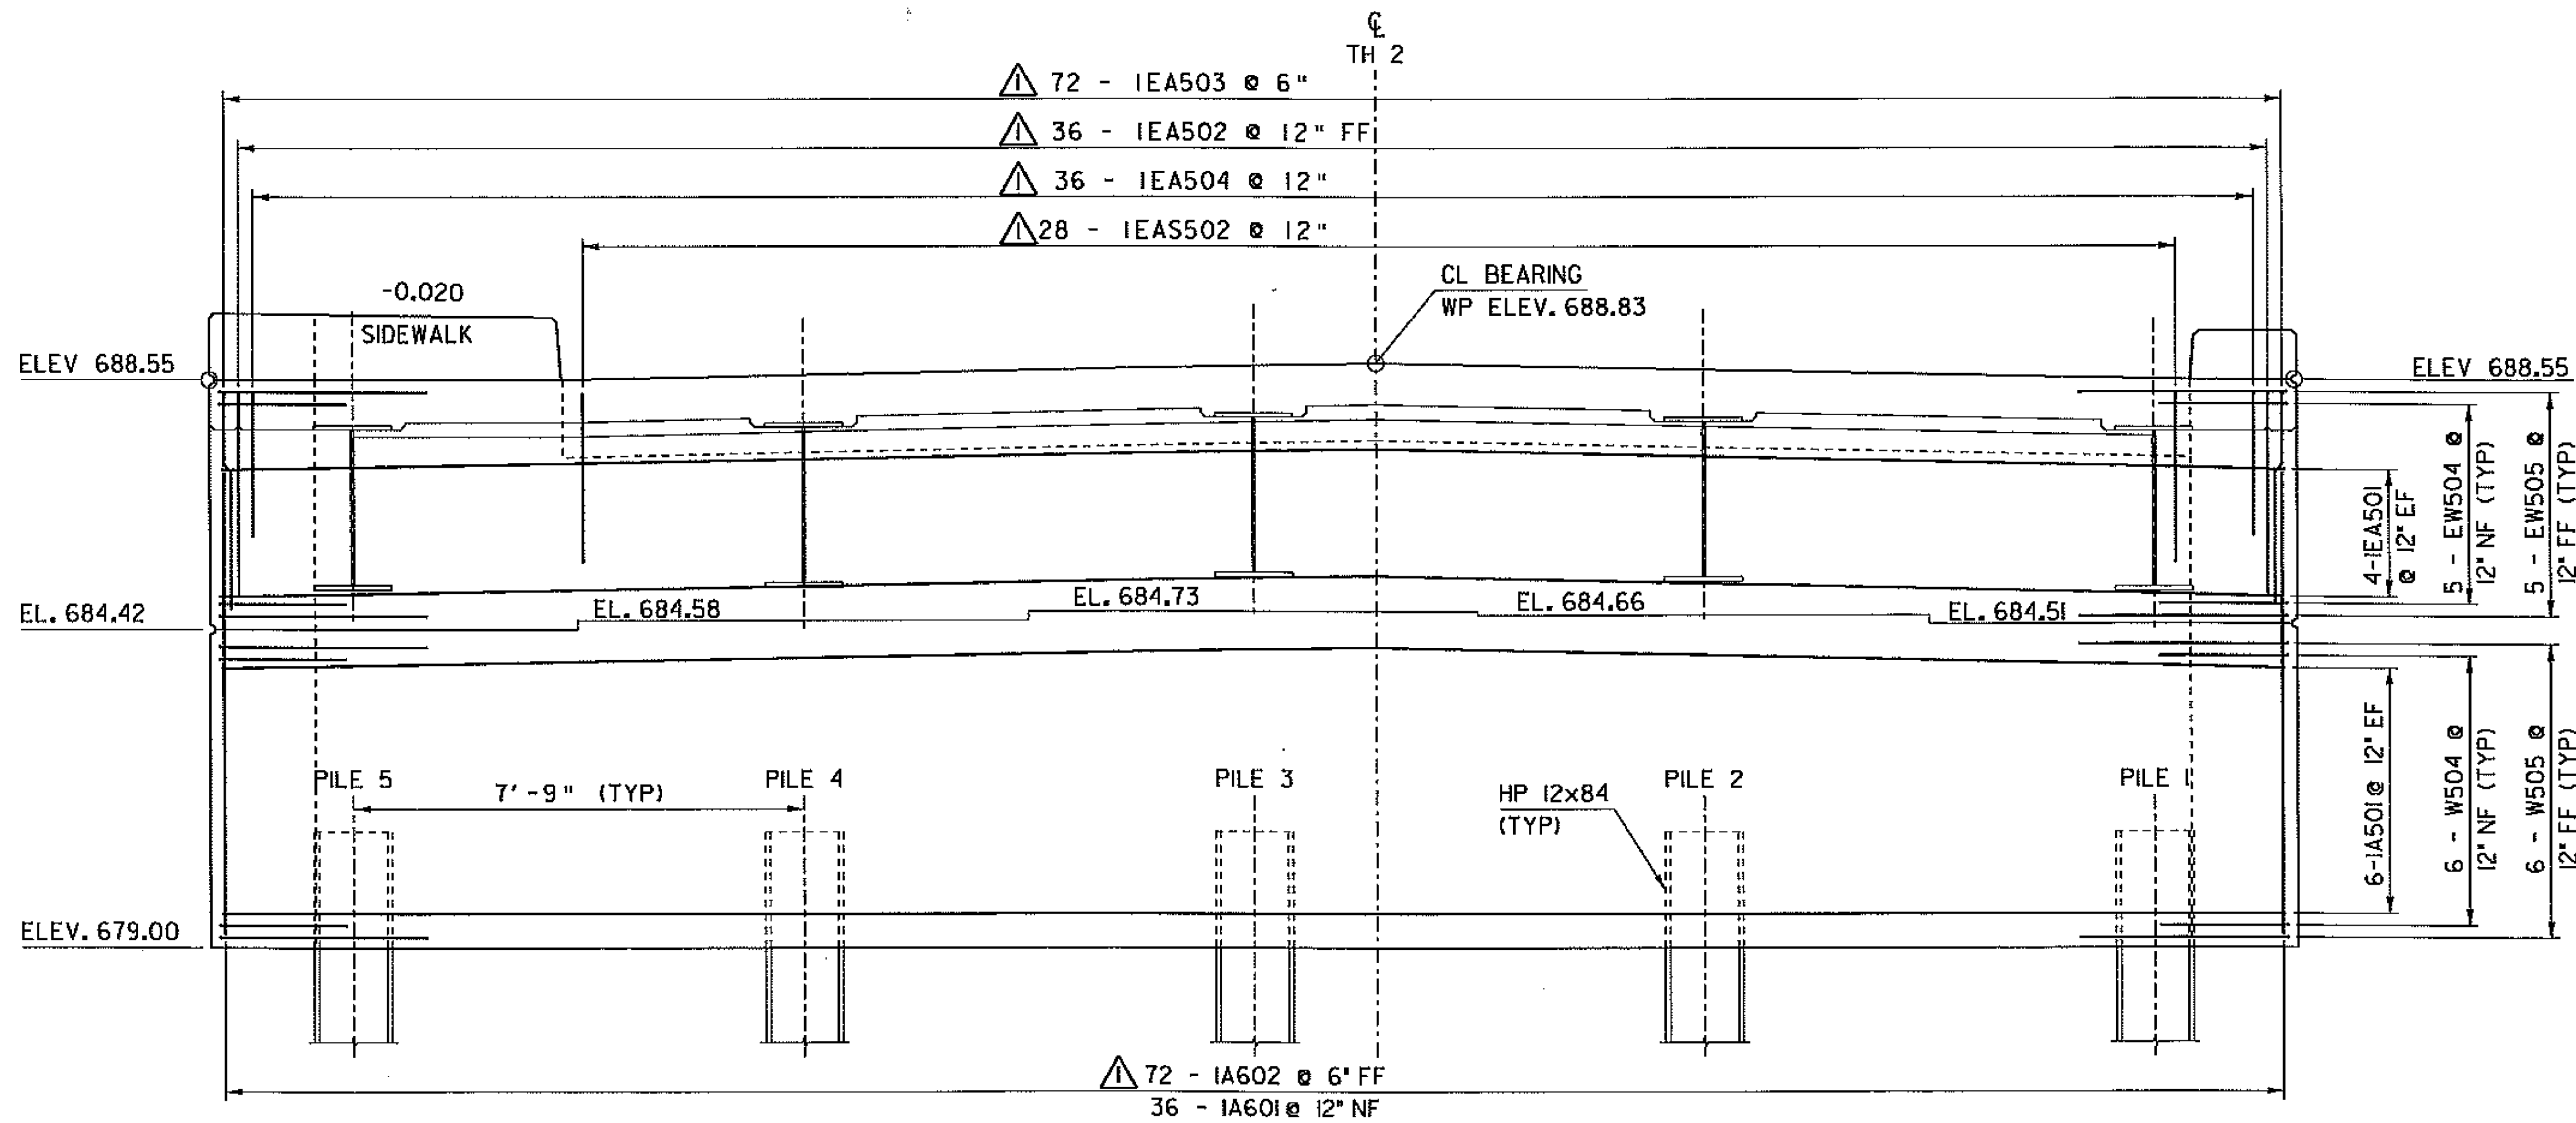

INTEGRAL ABUTMENT NO. 1 ELEVATION
SCALE 1/2"=1'-0"

NOTE:
 NF = NEAR FACE
 FF = FAR FACE
 EF = EACH FACE
 ▲ = CUT TO FIT IN FIELD
 3" CLEAR, UNLESS OTHERWISE SPECIFIED ON THE PLANS.
 2'-2" BAR LAP UNLESS OTHERWISE SPECIFIED ON THE PLANS.

PROJECT NAME:	NEWPORT CITY
PROJECT NUMBER:	BRO 1449(25)
FILE NAME:	s96j234sub.dgn
PROJECT LEADER:	C. CARLSON
DESIGNED BY:	D. PETERSON
ABUTMENT I PLAN AND ELEVATION	
PLOT DATE:	08-MAR-2012
DRAWN BY:	C. MOONEY
CHECKED BY:	D. PETERSON
SHEET	42 OF 75

REV.	DESCRIPTION	DATE	REVISION BY
▲	UPDATED REINFORCING SIZE/QUANTITY	3/7/2012	DRP