


INTEGRAL ABUTMENT NO. 2 PLAN
 SCALE 1/2"=1'-0"

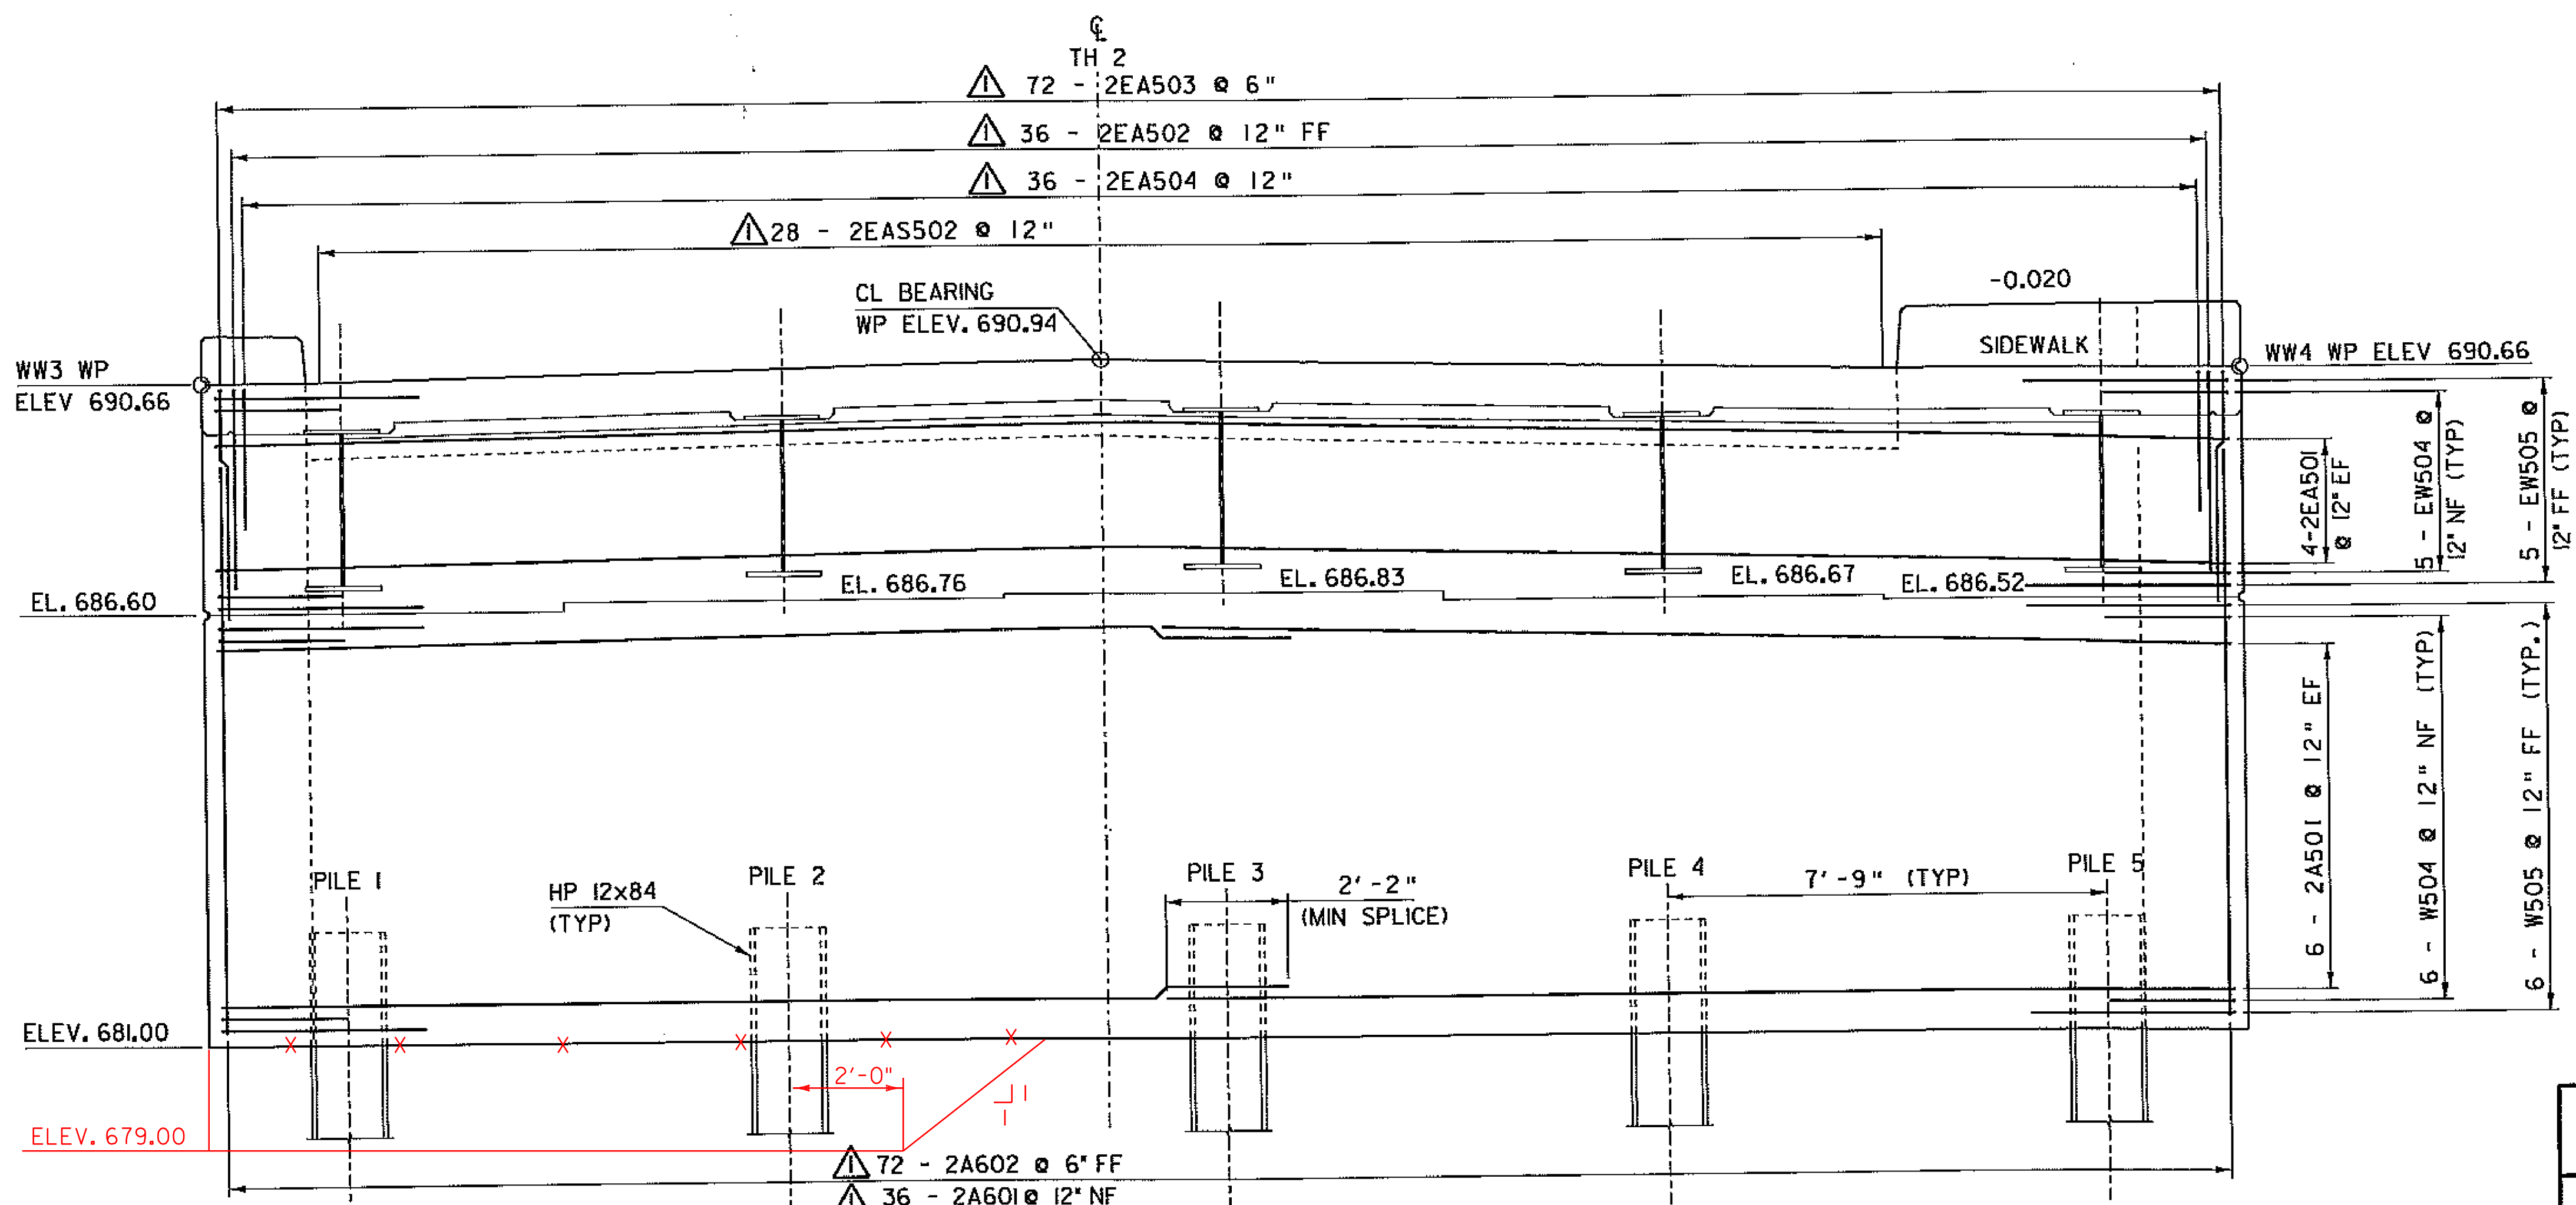

INTEGRAL ABUTMENT NO. 2 ELEVATION
 SCALE 1/2"=1'-0"

NOTE:
 NF = NEAR FACE
 FF = FAR FACE
 EF = EACH FACE
 ▲ = CUT TO FIT IN FIELD
 3" CLEAR, UNLESS OTHERWISE
 SPECIFIED ON THE PLANS.
 2'-2" BAR LAP UNLESS OTHERWISE
 SPECIFIED ON THE PLANS.

REV.	DESCRIPTION	DATE	REVISION BY
▲	UPDATED REINFORCING SIZE/QUANTITY	3/7/2012	DRP

PROJECT NAME: NEWPORT CITY
 PROJECT NUMBER: BRO 1449(25)
 FILE NAME: s96j234sub.dgn PLOT DATE: 08-MAR-2012
 PROJECT LEADER: C. CARLSON DRAWN BY: C. MOONEY
 DESIGNED BY: D. PETERSON CHECKED BY: D. PETERSON
 ABUTMENT 2 PLAN AND ELEVATION SHEET 43 OF 75