



BEGIN BRIDGE APPROACH DETAIL
N. T. S.

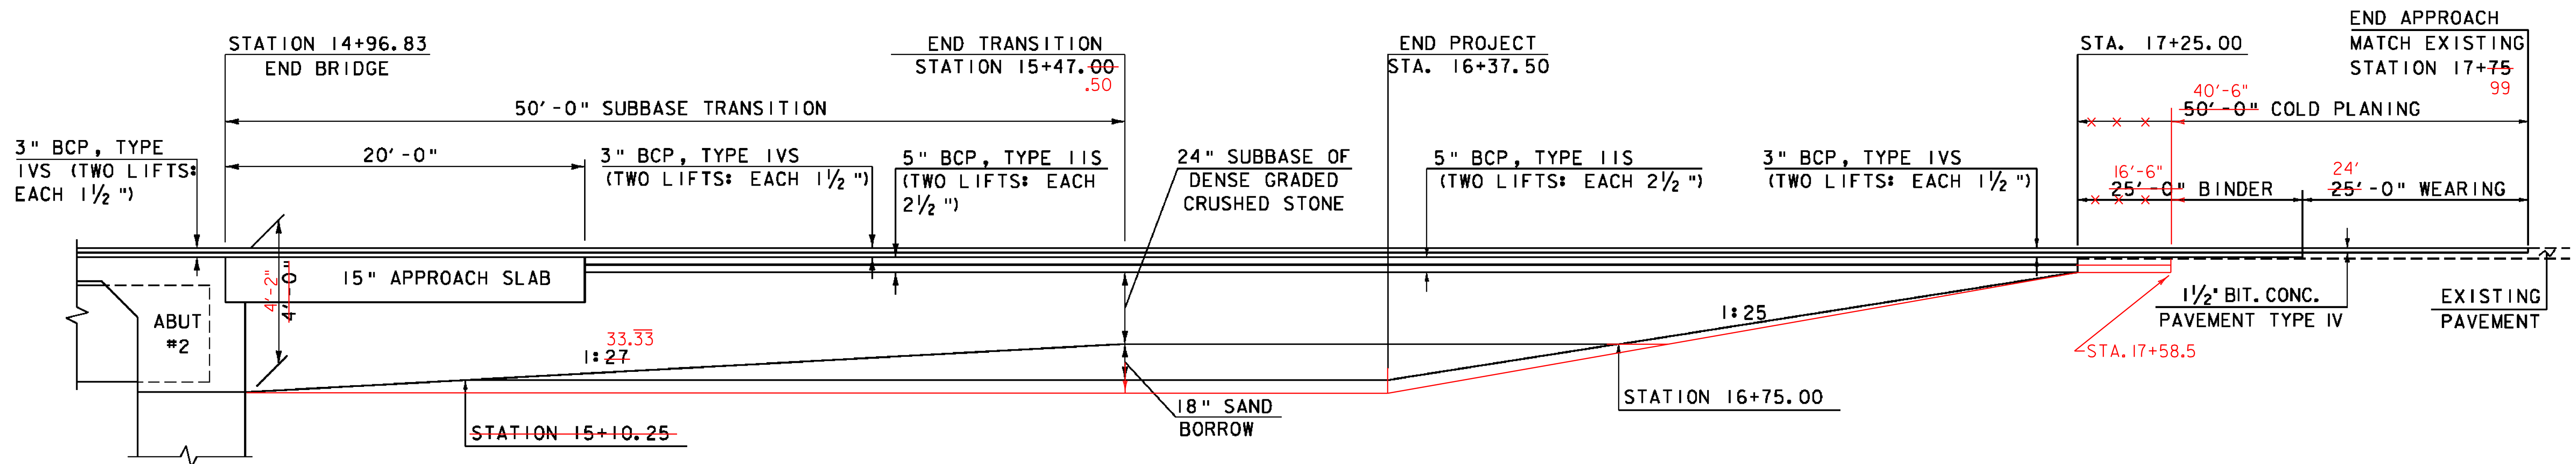

END BRIDGE APPROACH DETAIL
N. T. S.

NOTE:
BCP SHALL BE READ AS BITUMINOUS CONCRETE PAVEMENT AND SHALL BE PAID FOR UNDER ITEM 900.680 "SPECIAL PROVISION (BITUMINOUS CONCRETE PAVEMENT, SMALL QUANTITY)".

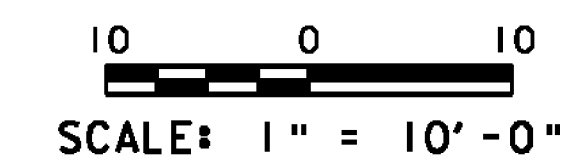

PROJECT NAME: NEWPORT CITY

PROJECT NUMBER: BRO 1449(25)

FILE NAME: 96j314/str3/sj314xs.dgn

PROJECT LEADER: C. CARLSON

DESIGNED BY: C. CARLSON

MATERIAL TRANSITION DIAGRAM

PLOT DATE: 22-NOV-2011

DRAWN BY: C. MOONEY

CHECKED BY: C. CARLSON

SHEET 48 OF 75