
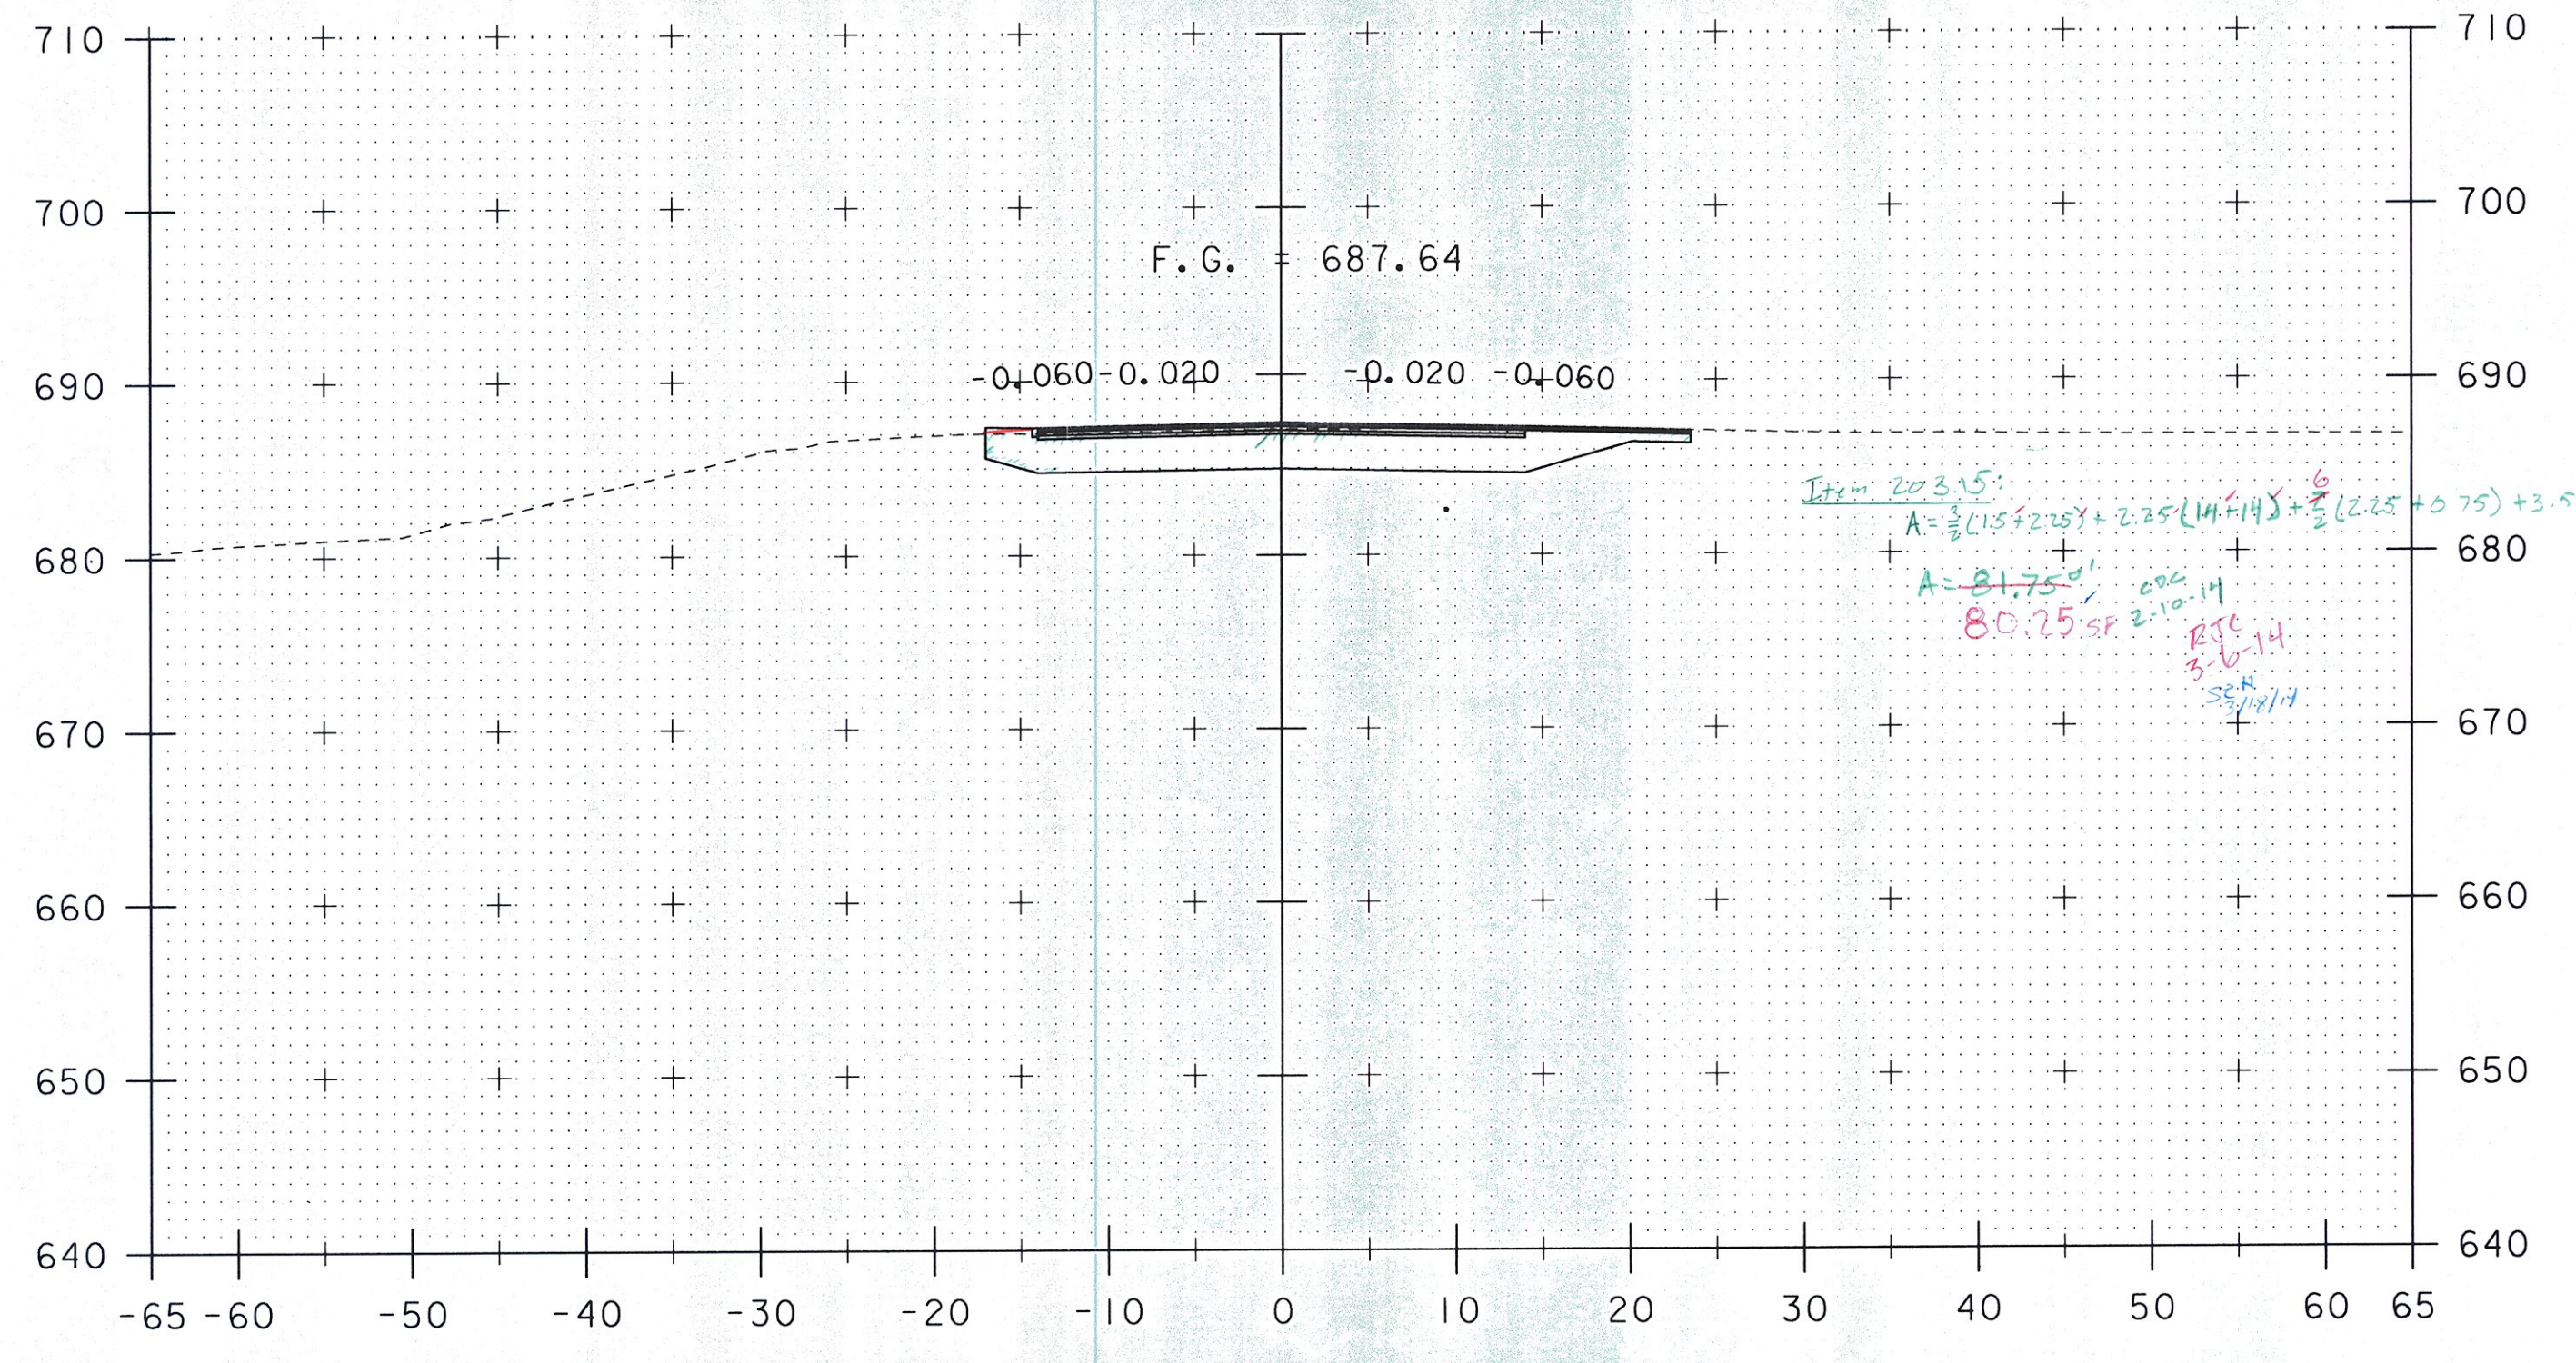


11+25

11+75

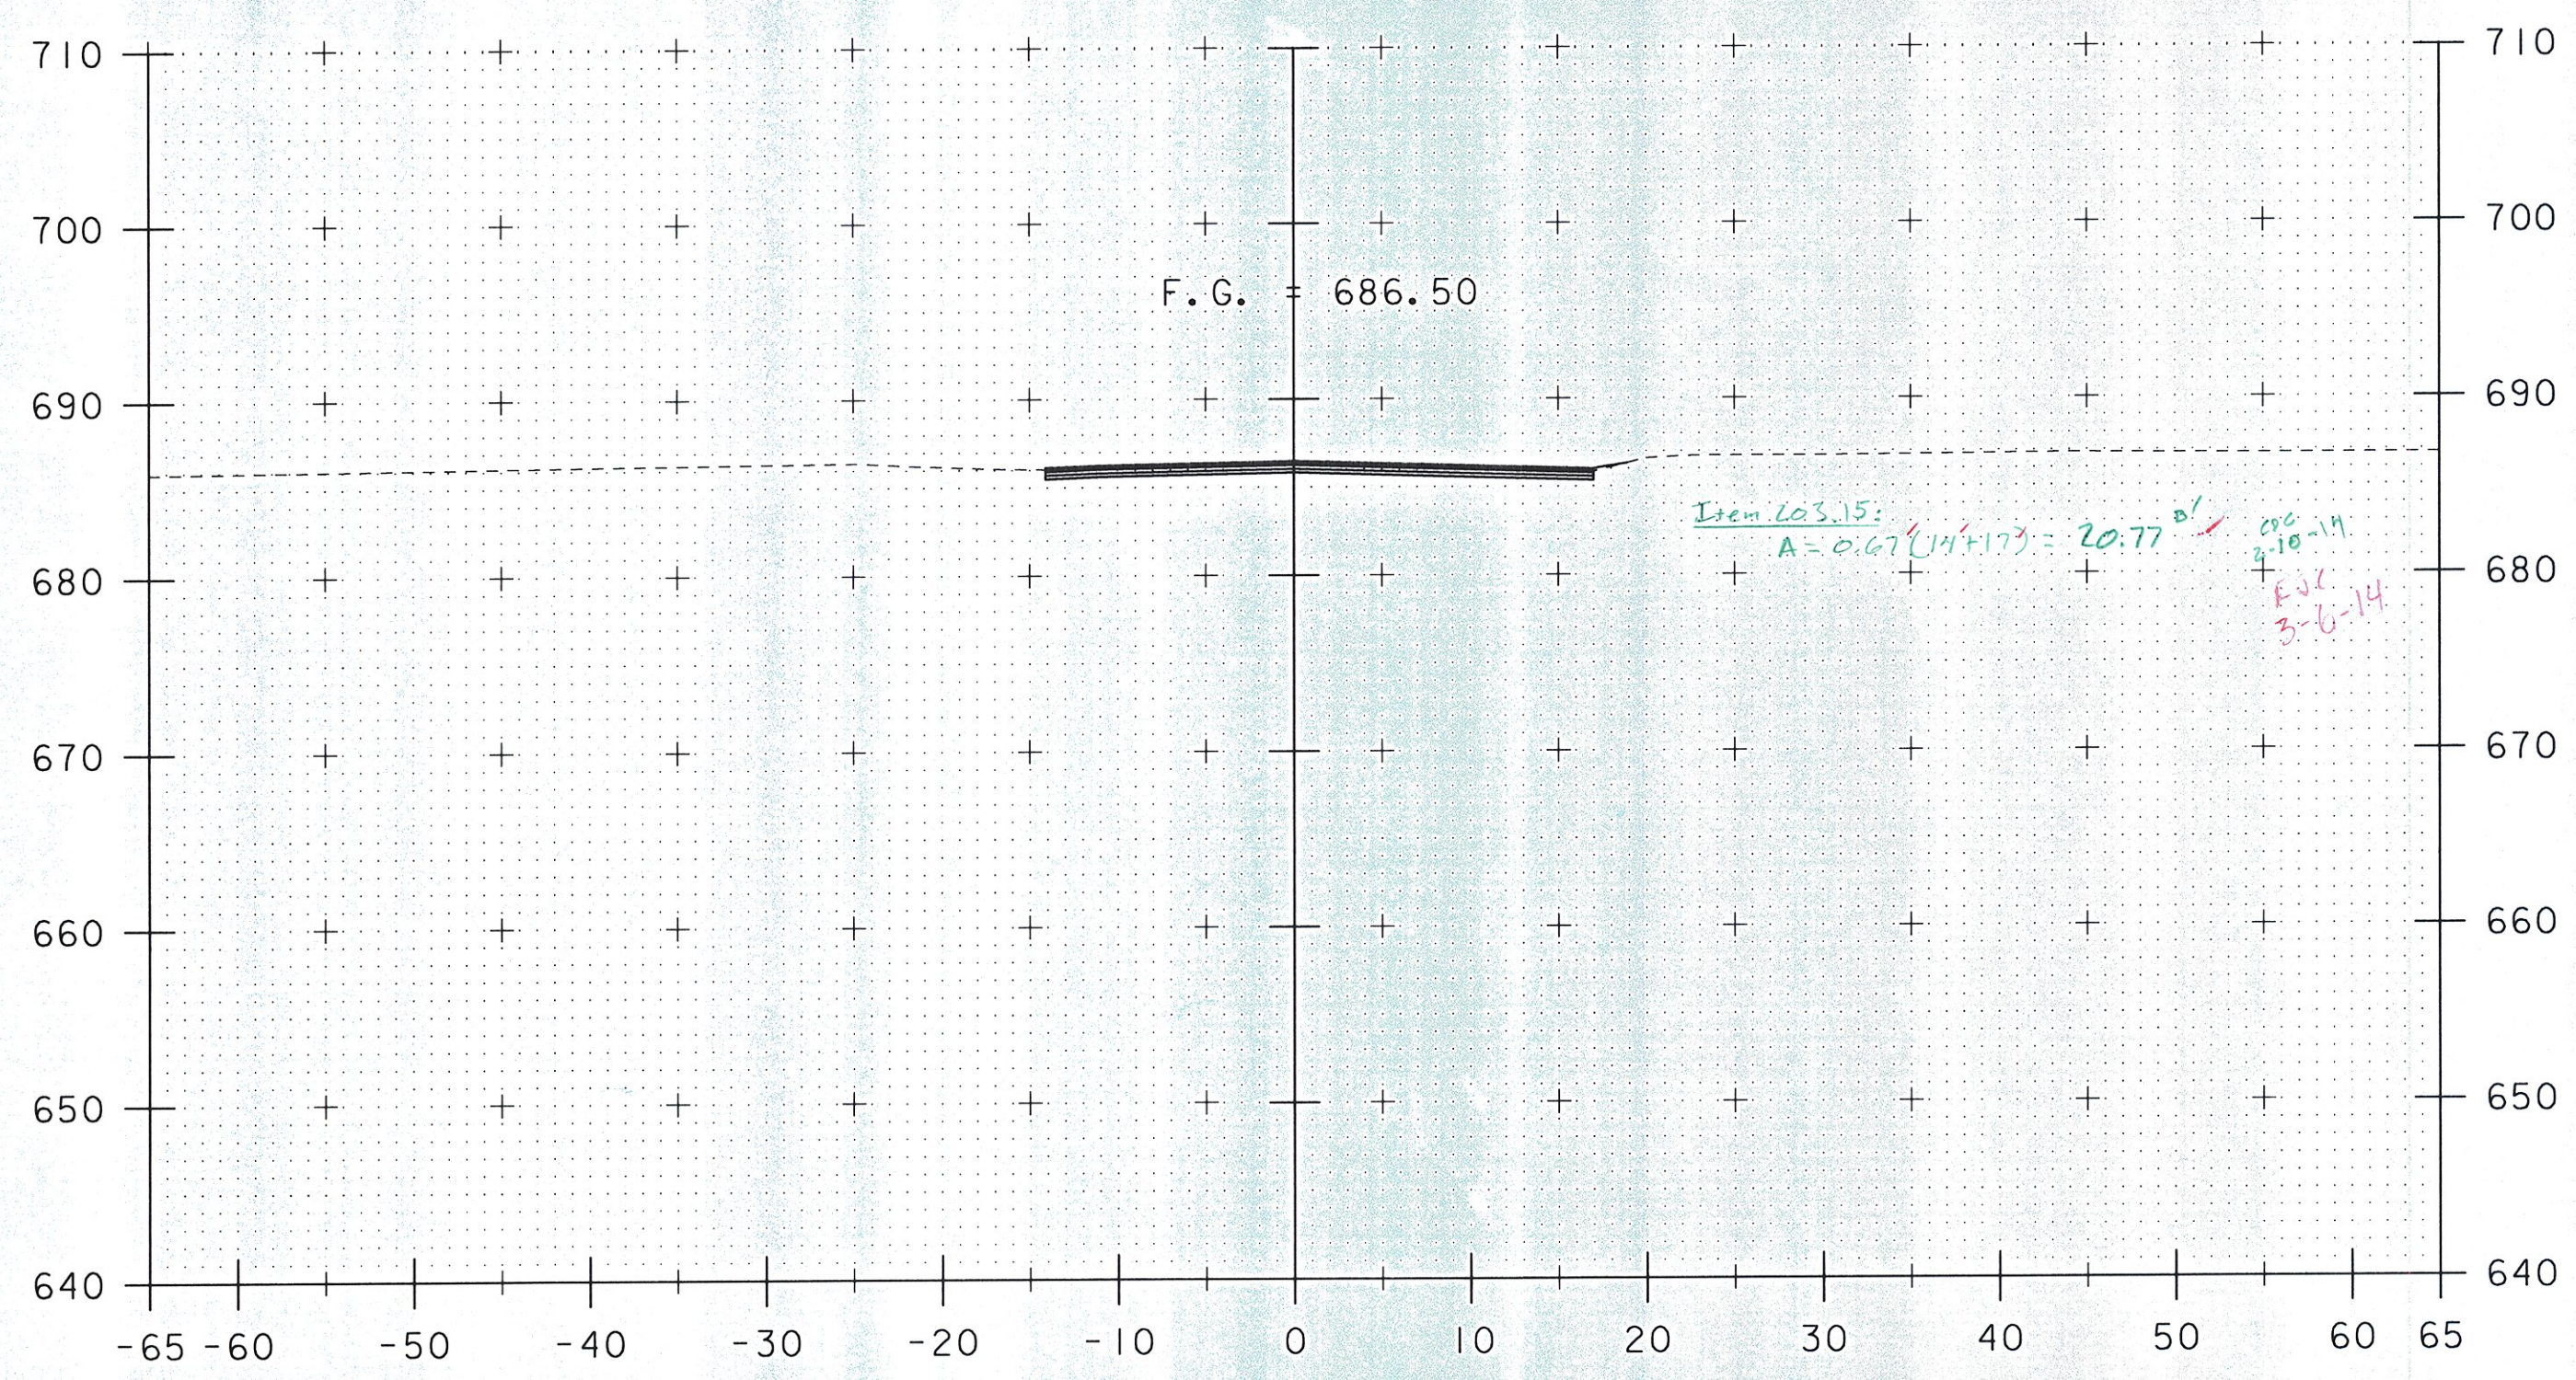

11+00 Beg. Item 203.15

11+50

STA. 11+00.00
END APPROACH
BEGIN PROJECT

STA. 10+50.00
BEGIN APPROACH
MATCH EXISTING

STA. 11+00 TO STA. 11+75

PROJECT NAME:	NEWPORT CITY	PLOT DATE:	02-DEC-2011
PROJECT NUMBER:	BRO 1449(25)	DRAWN BY:	C. MOONEY
FILE NAME:	96J314/STR/96J314xsl.dgn	CHECKED BY:	C. CARLSON
PROJECT LEADER:	C. CARLSON	SHEET	49 OF 75
DESIGNED BY:	D. PETERSON	MAINLINE SECTION I	