




13+00

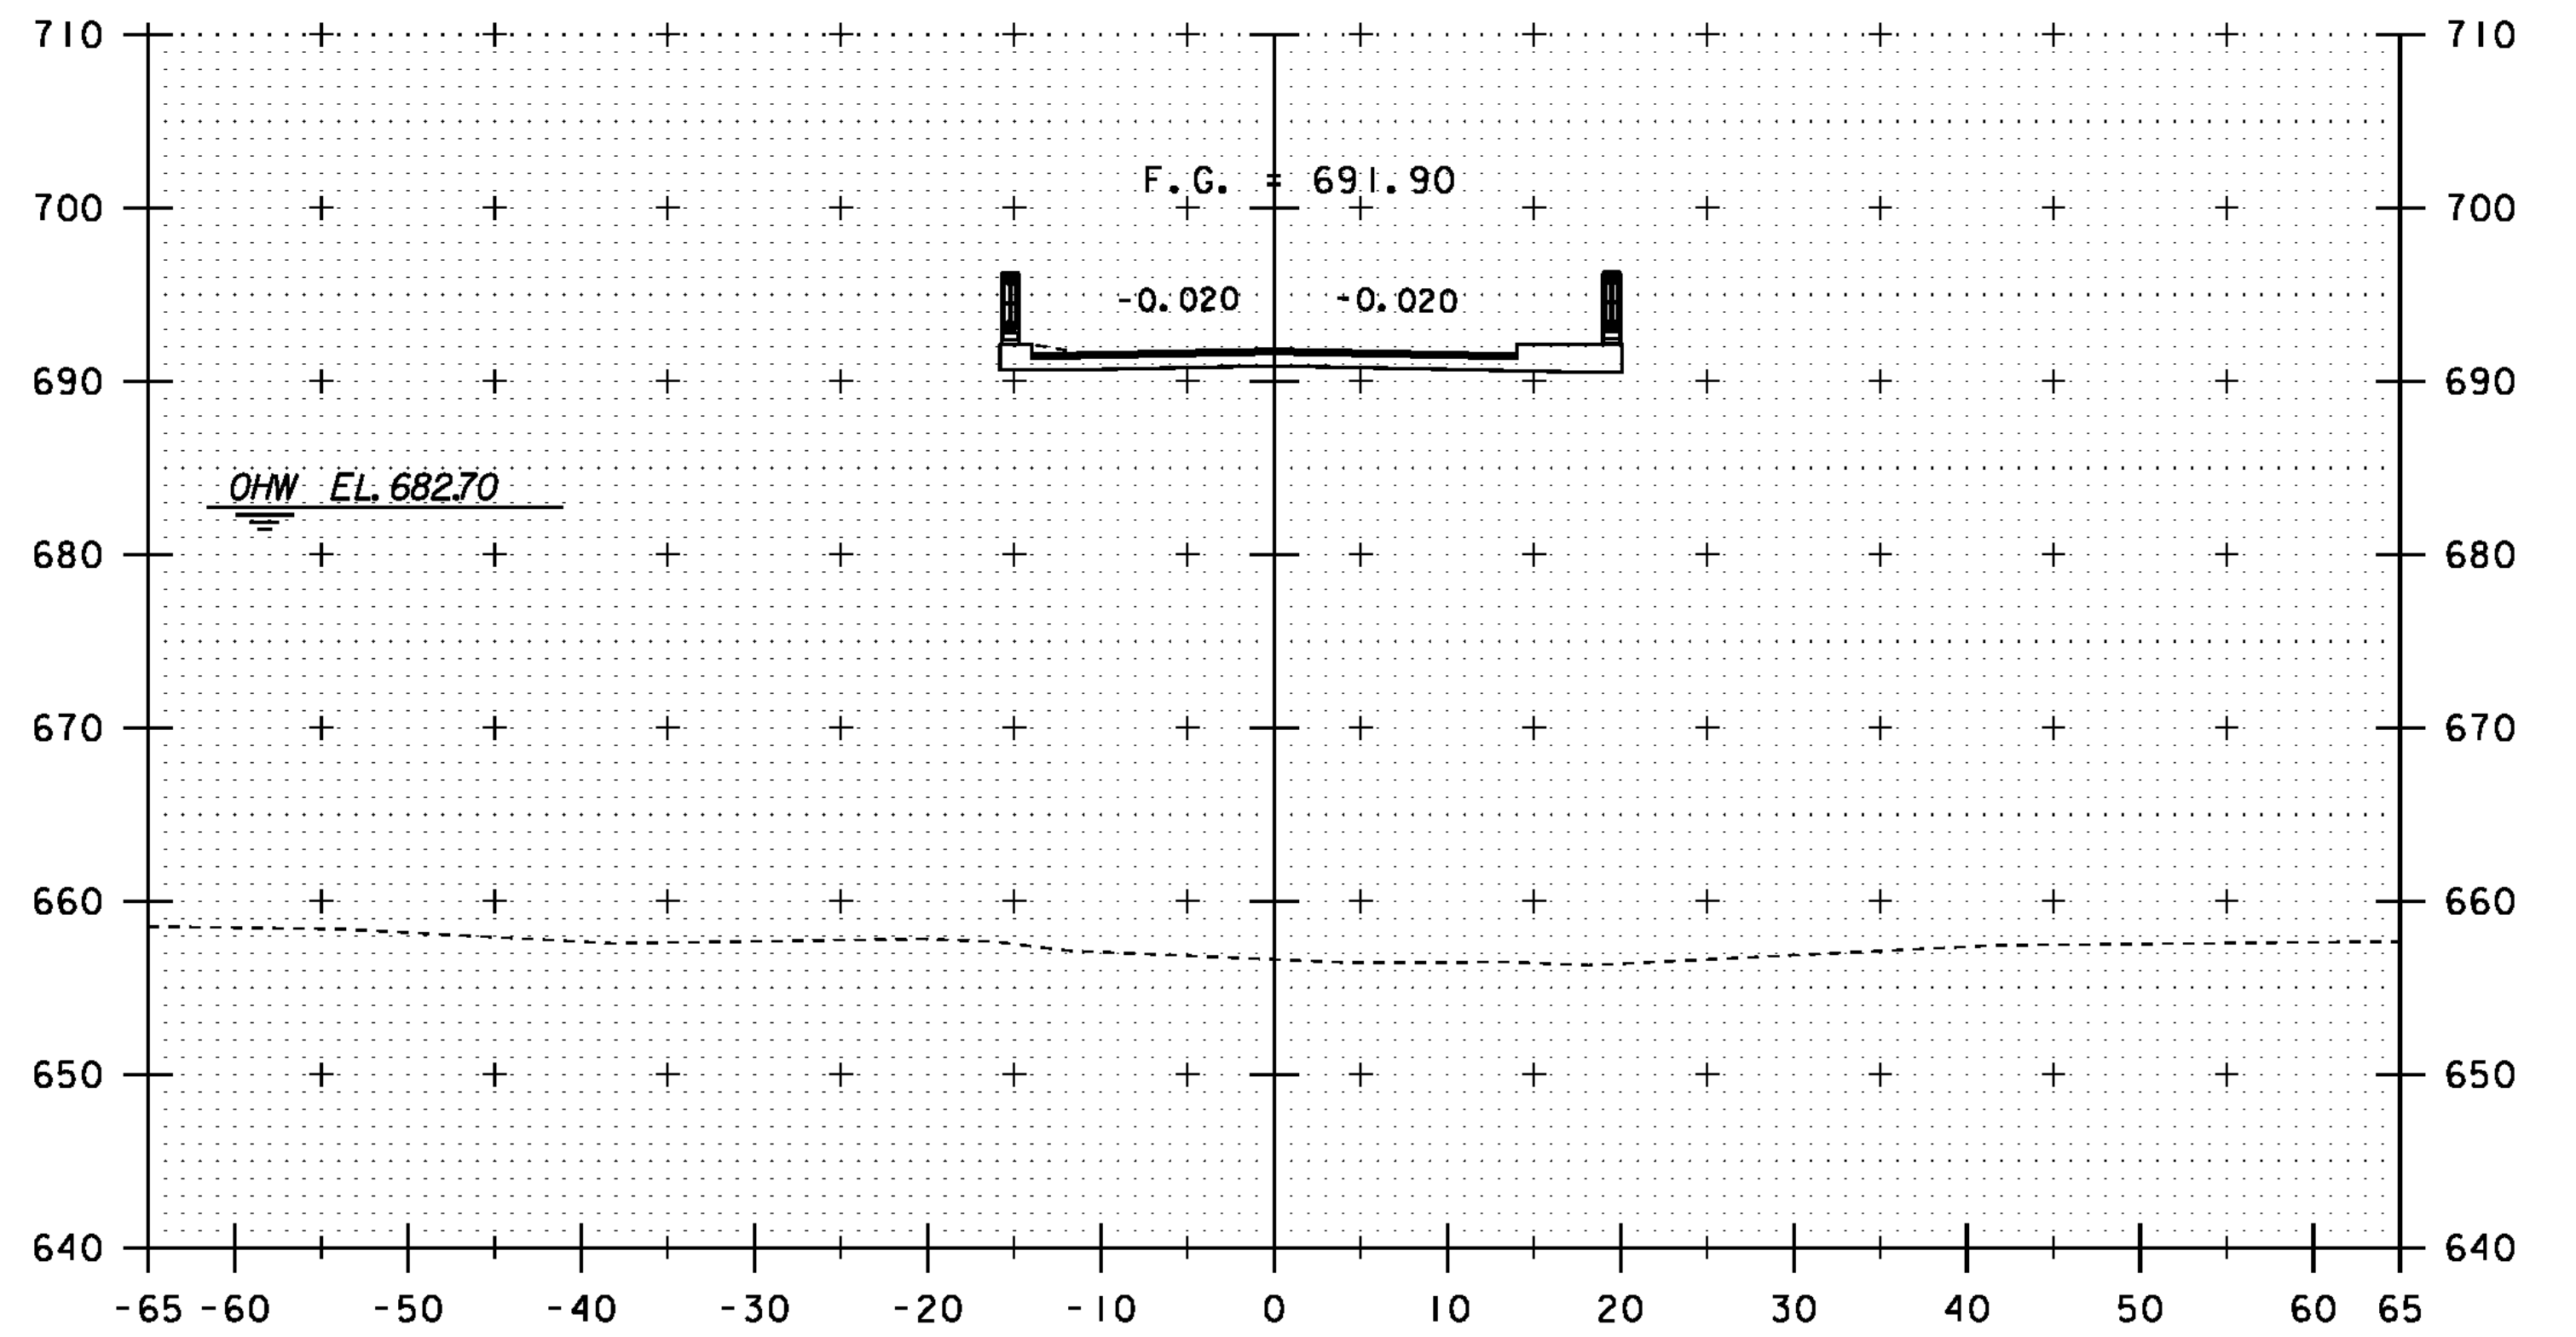

13+50

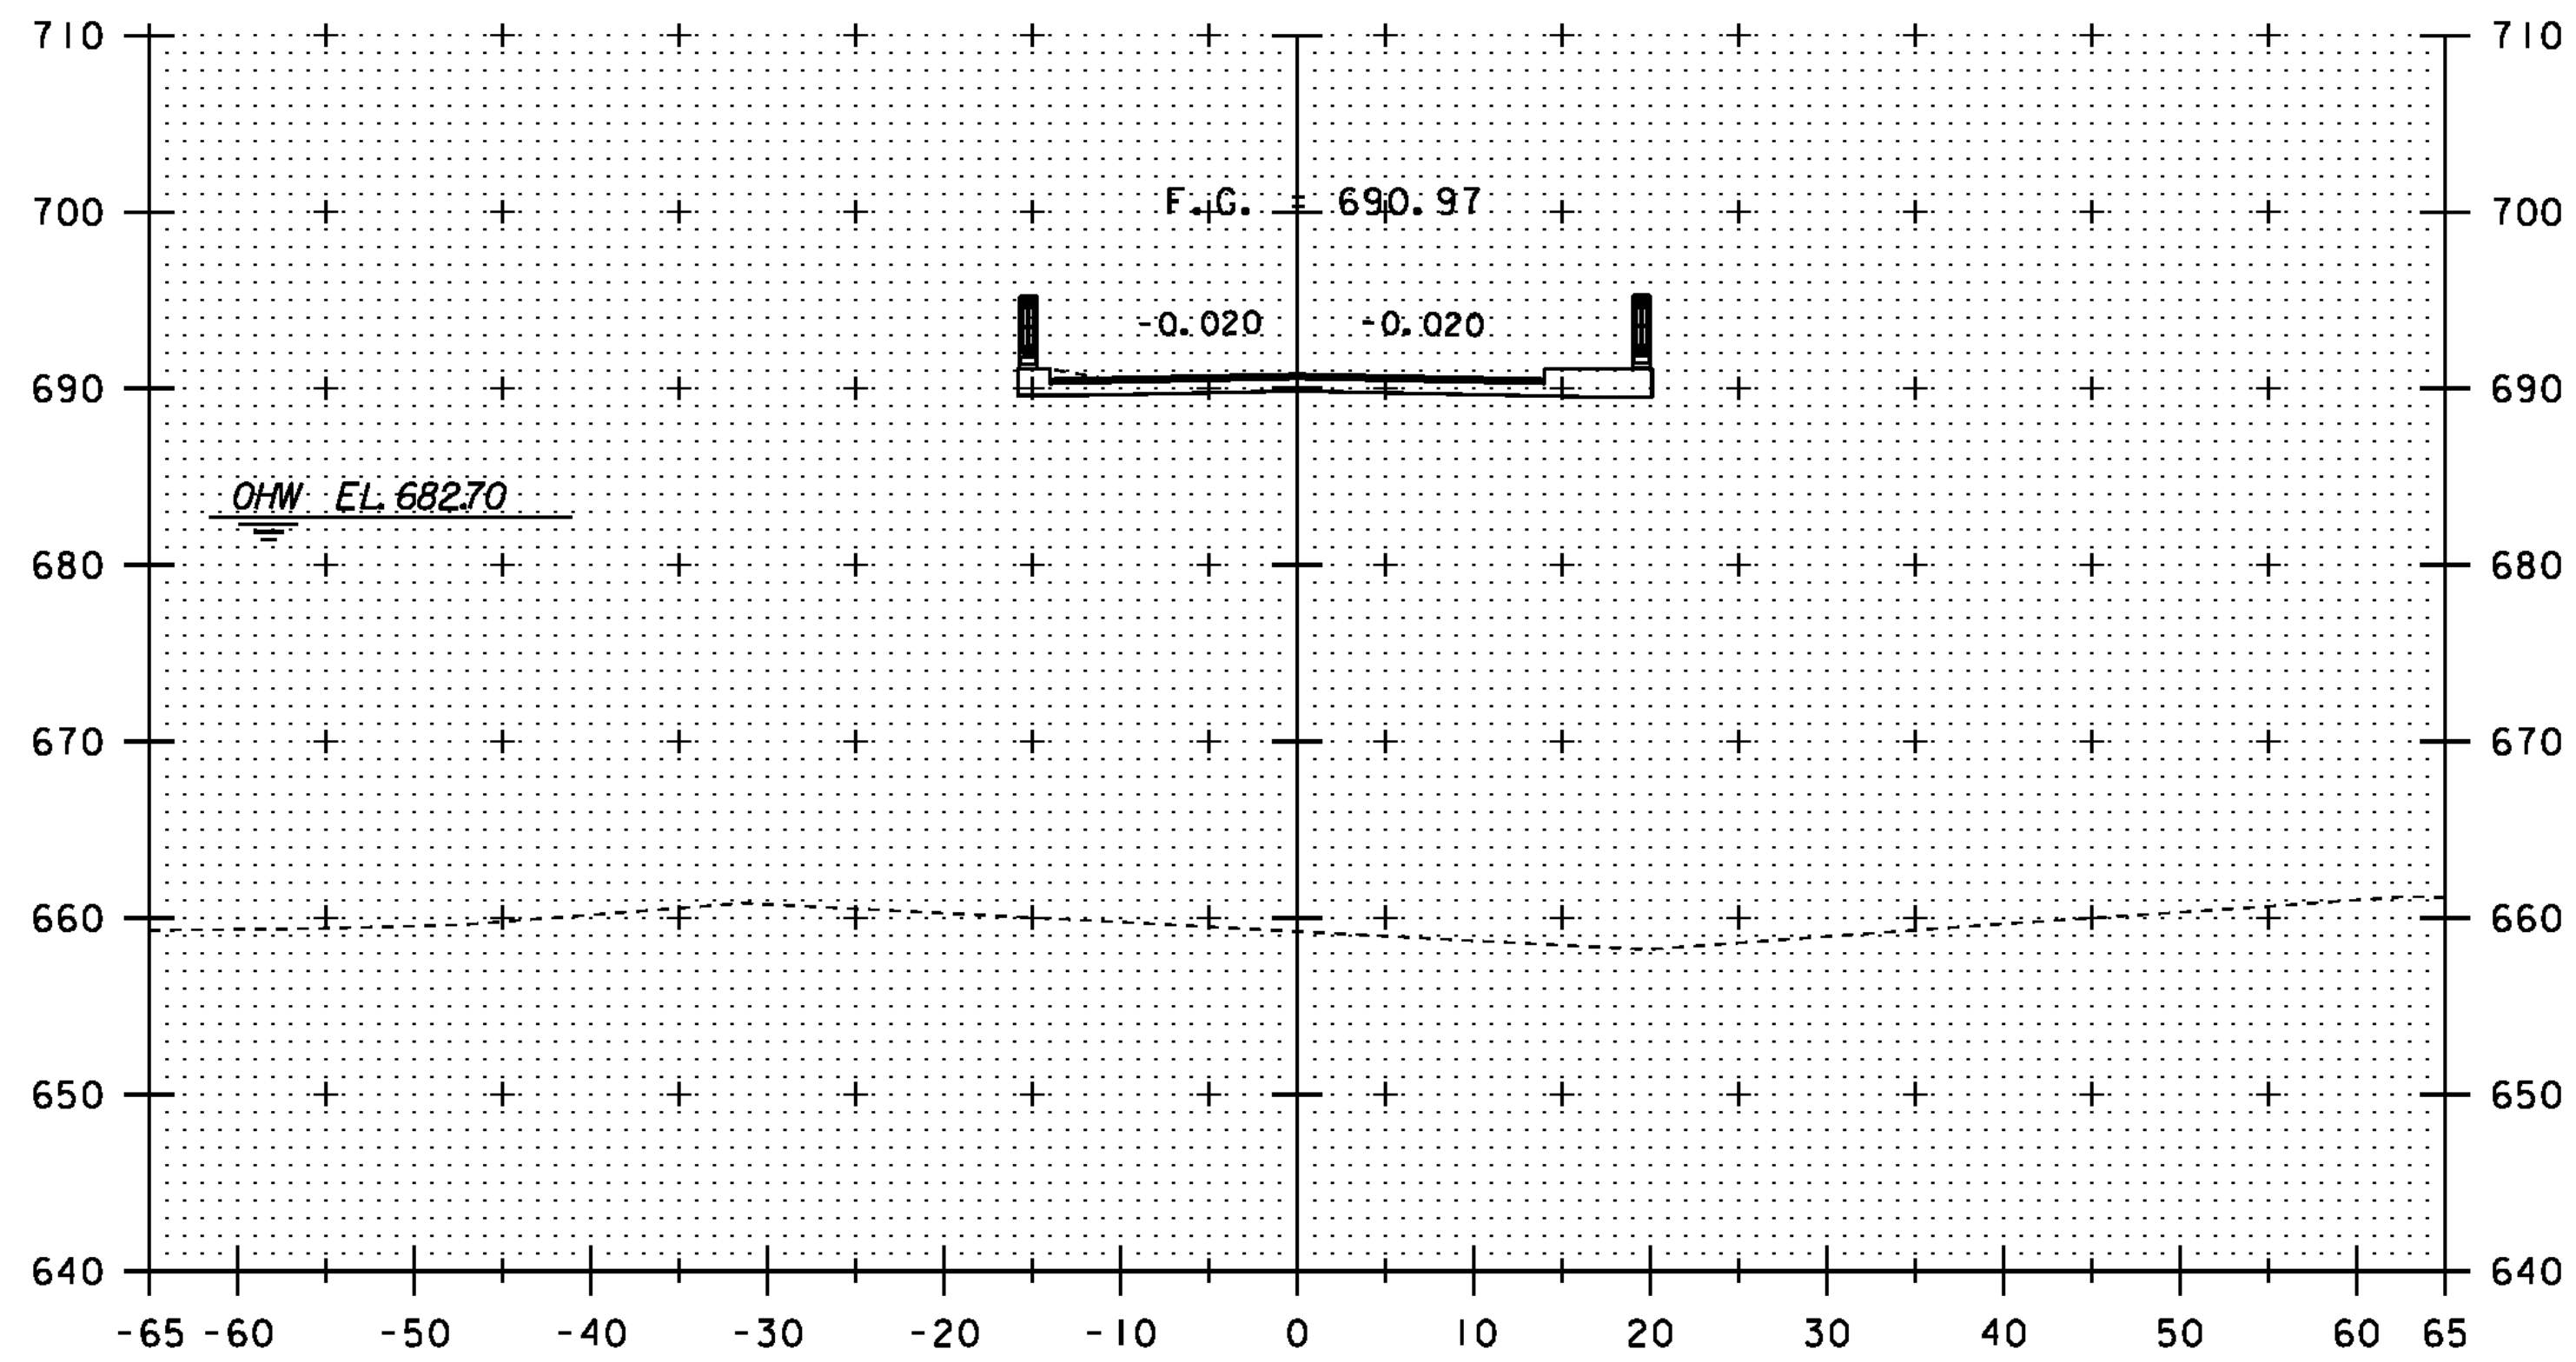

12+75

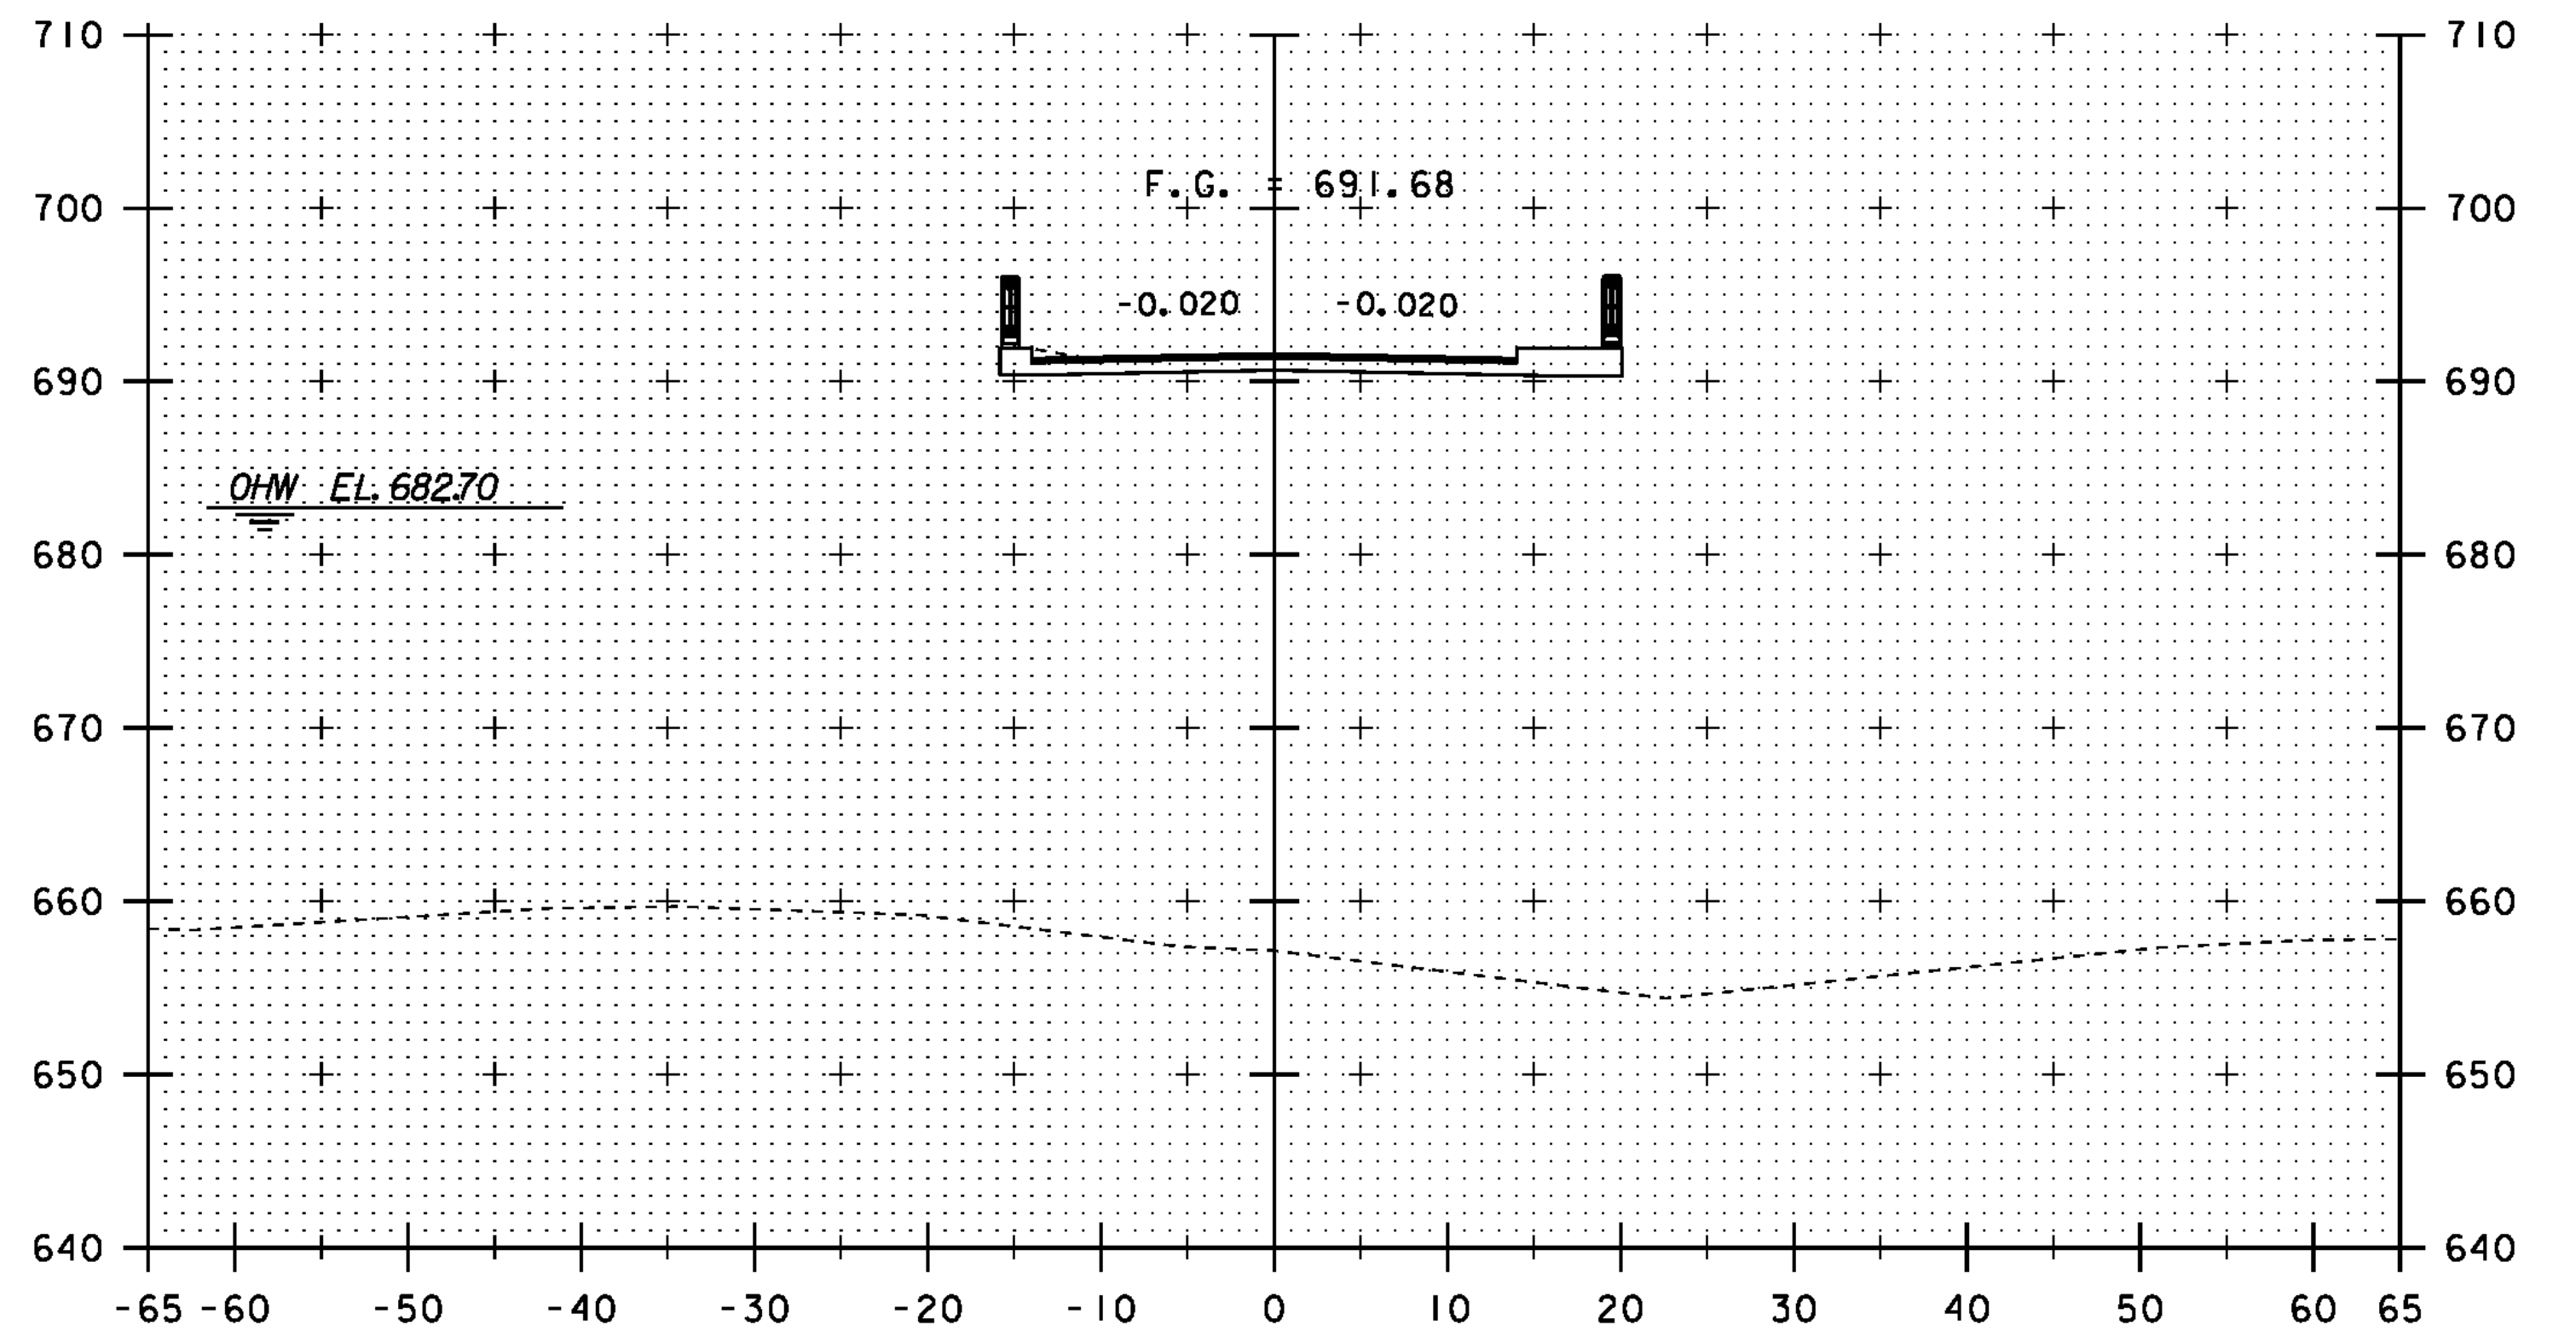

13+25

STA. 12+75 TO STA. 13+50

PROJECT NAME:	NEWPORT CITY	PLOT DATE:	22-NOV-2011
PROJECT NUMBER:	BRO 1449(25)	DRAWN BY:	C. MOONEY
FILE NAME:	96J314/STR/96J314xsl.dgn	CHECKED BY:	C. CARLSON
PROJECT LEADER:	C. CARLSON	DESIGNED BY:	D. PETERSON
DESIGNED BY:	D. PETERSON	MAINLINE SECTION 3	SHEET 51 OF 75