




14+00

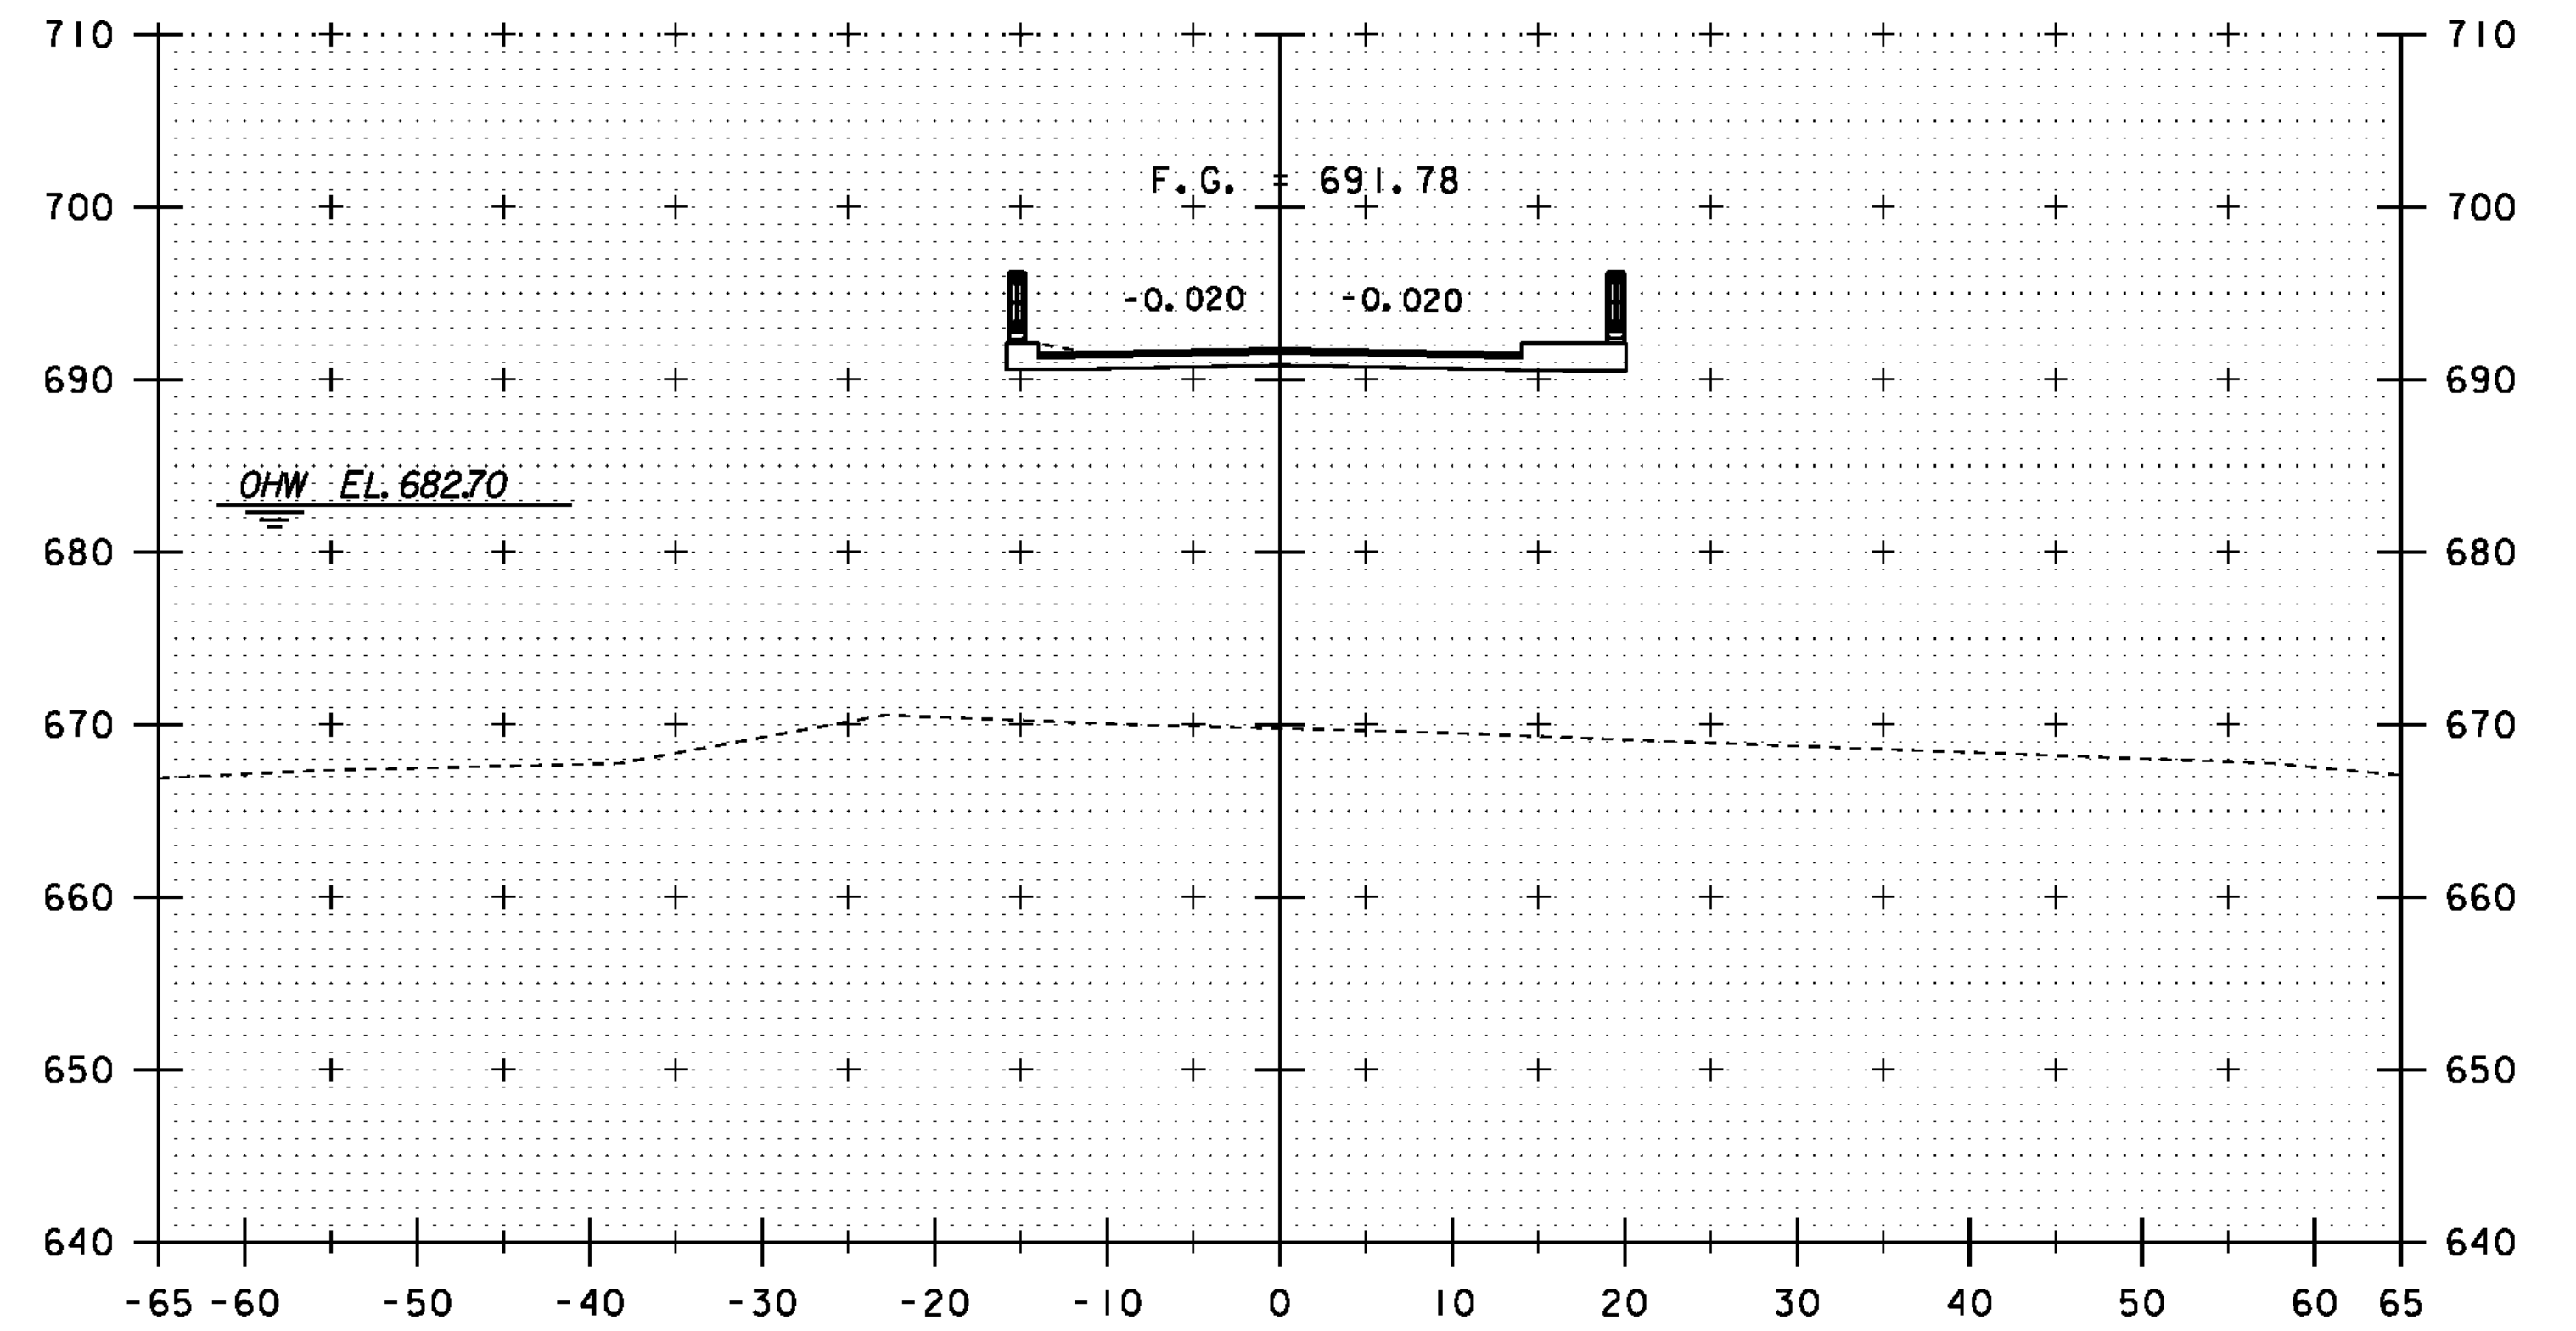

14+50

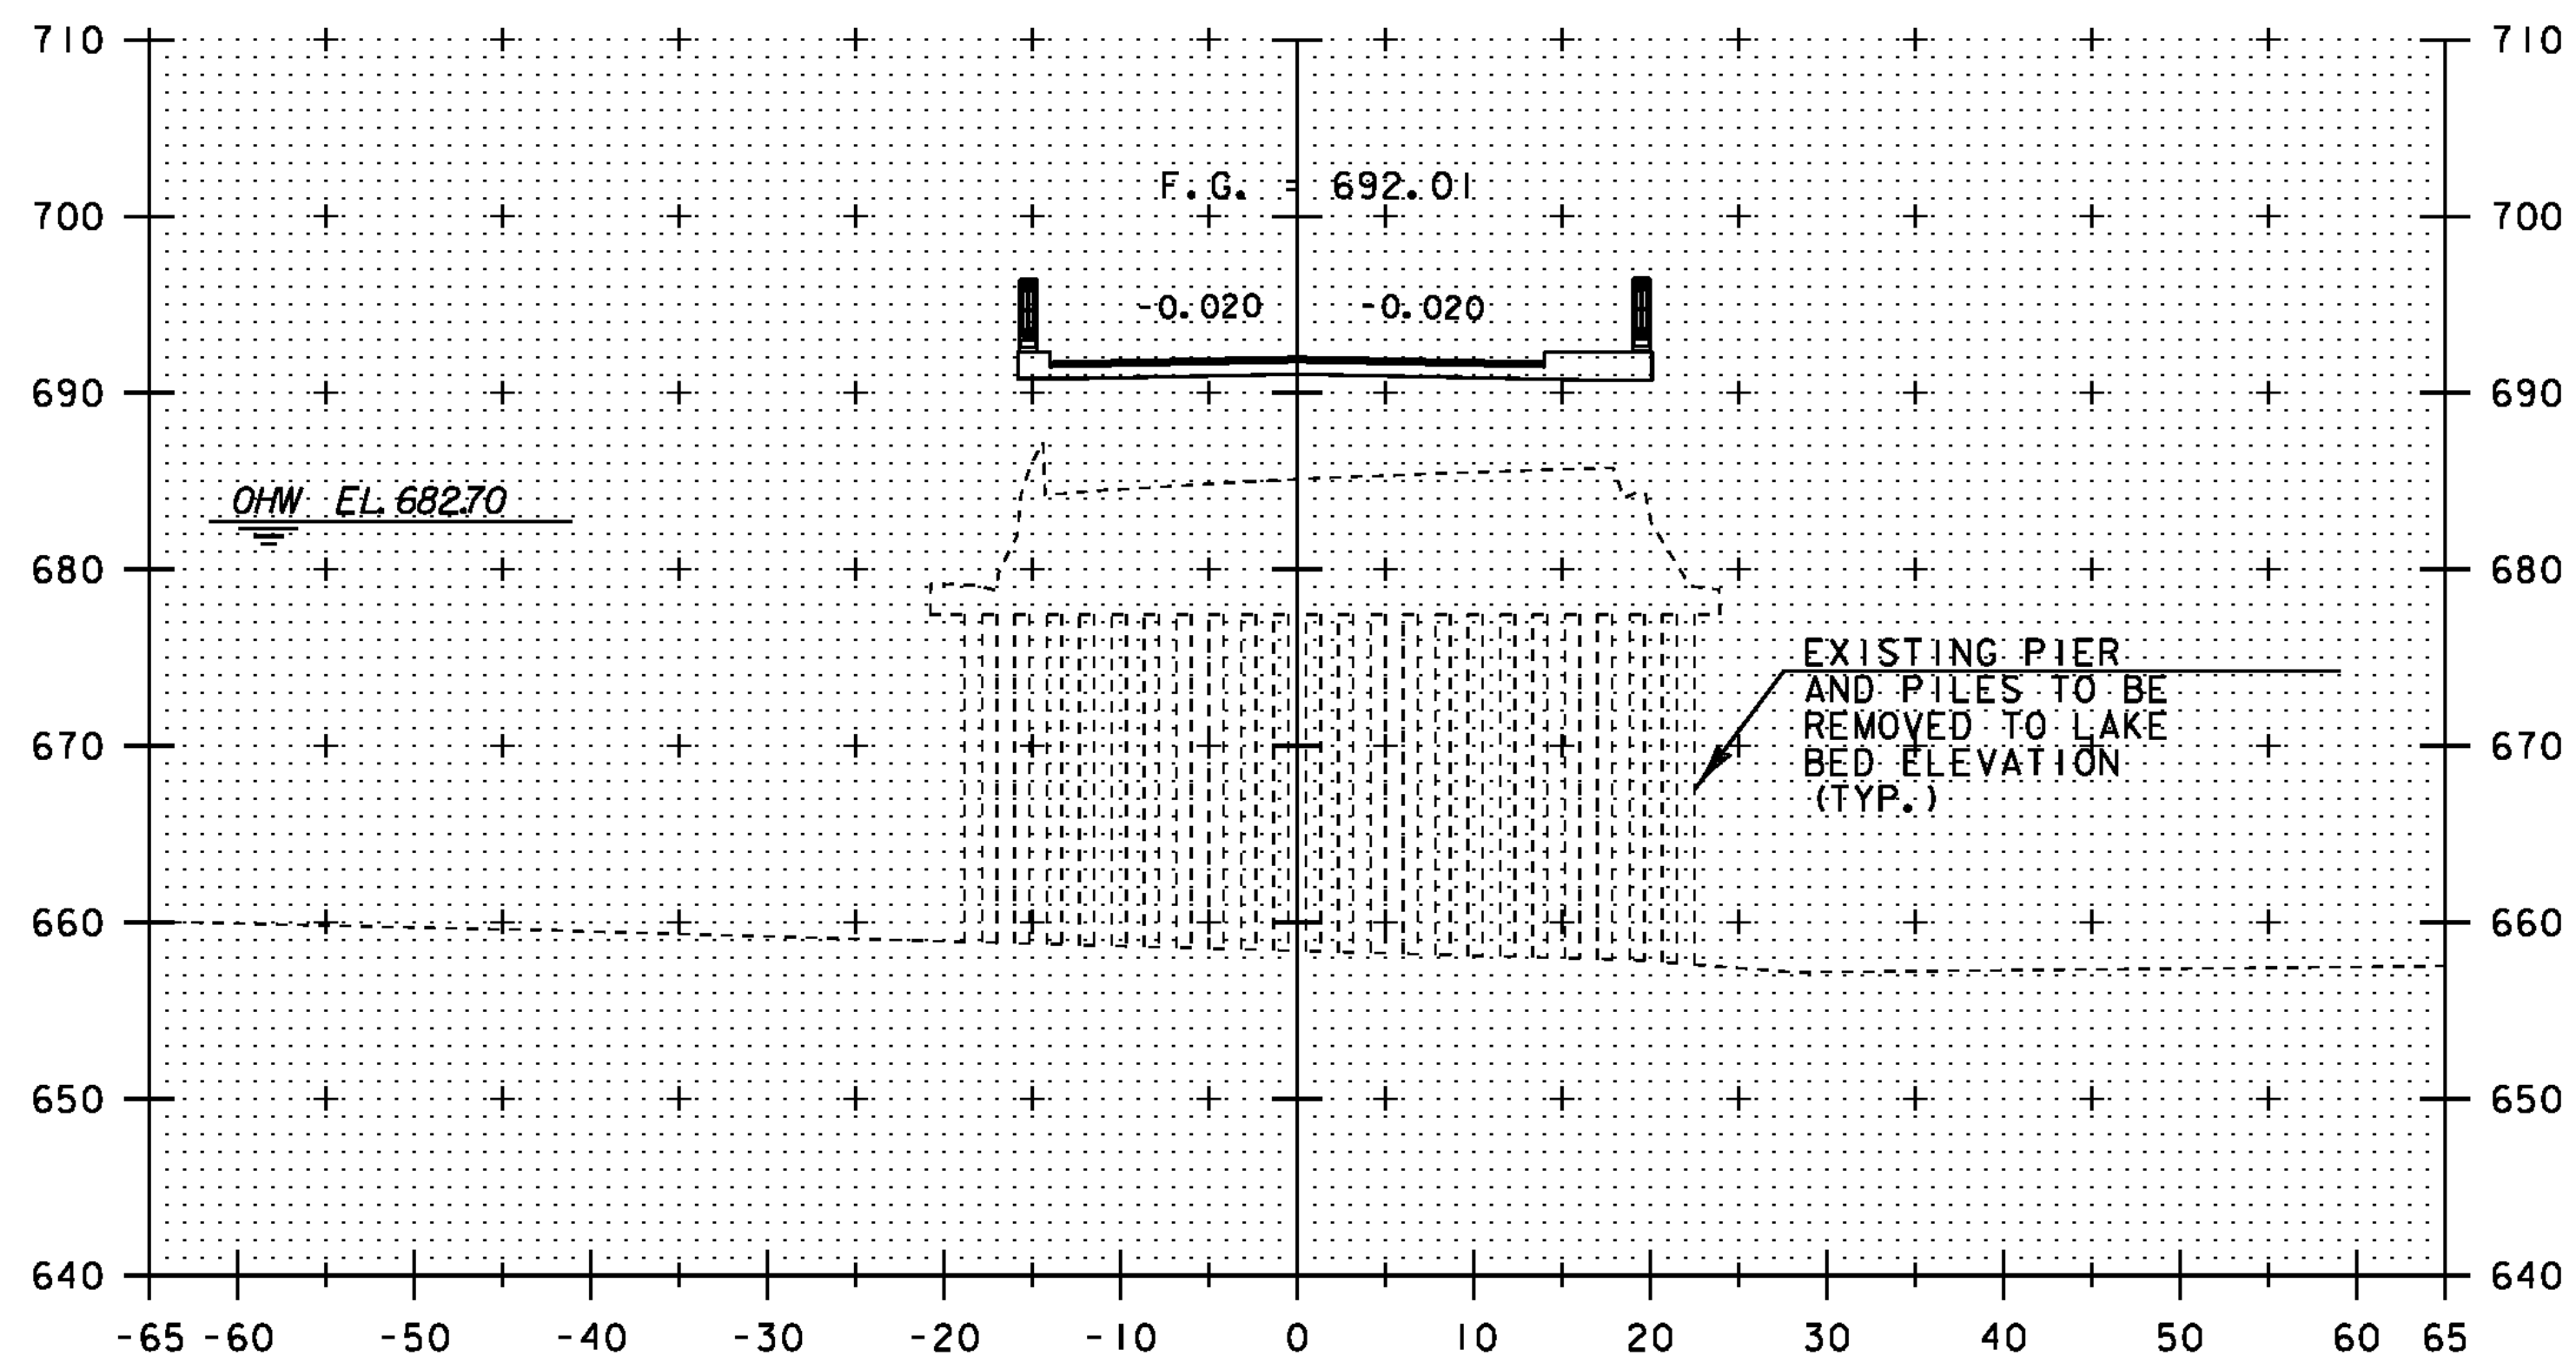

13+75

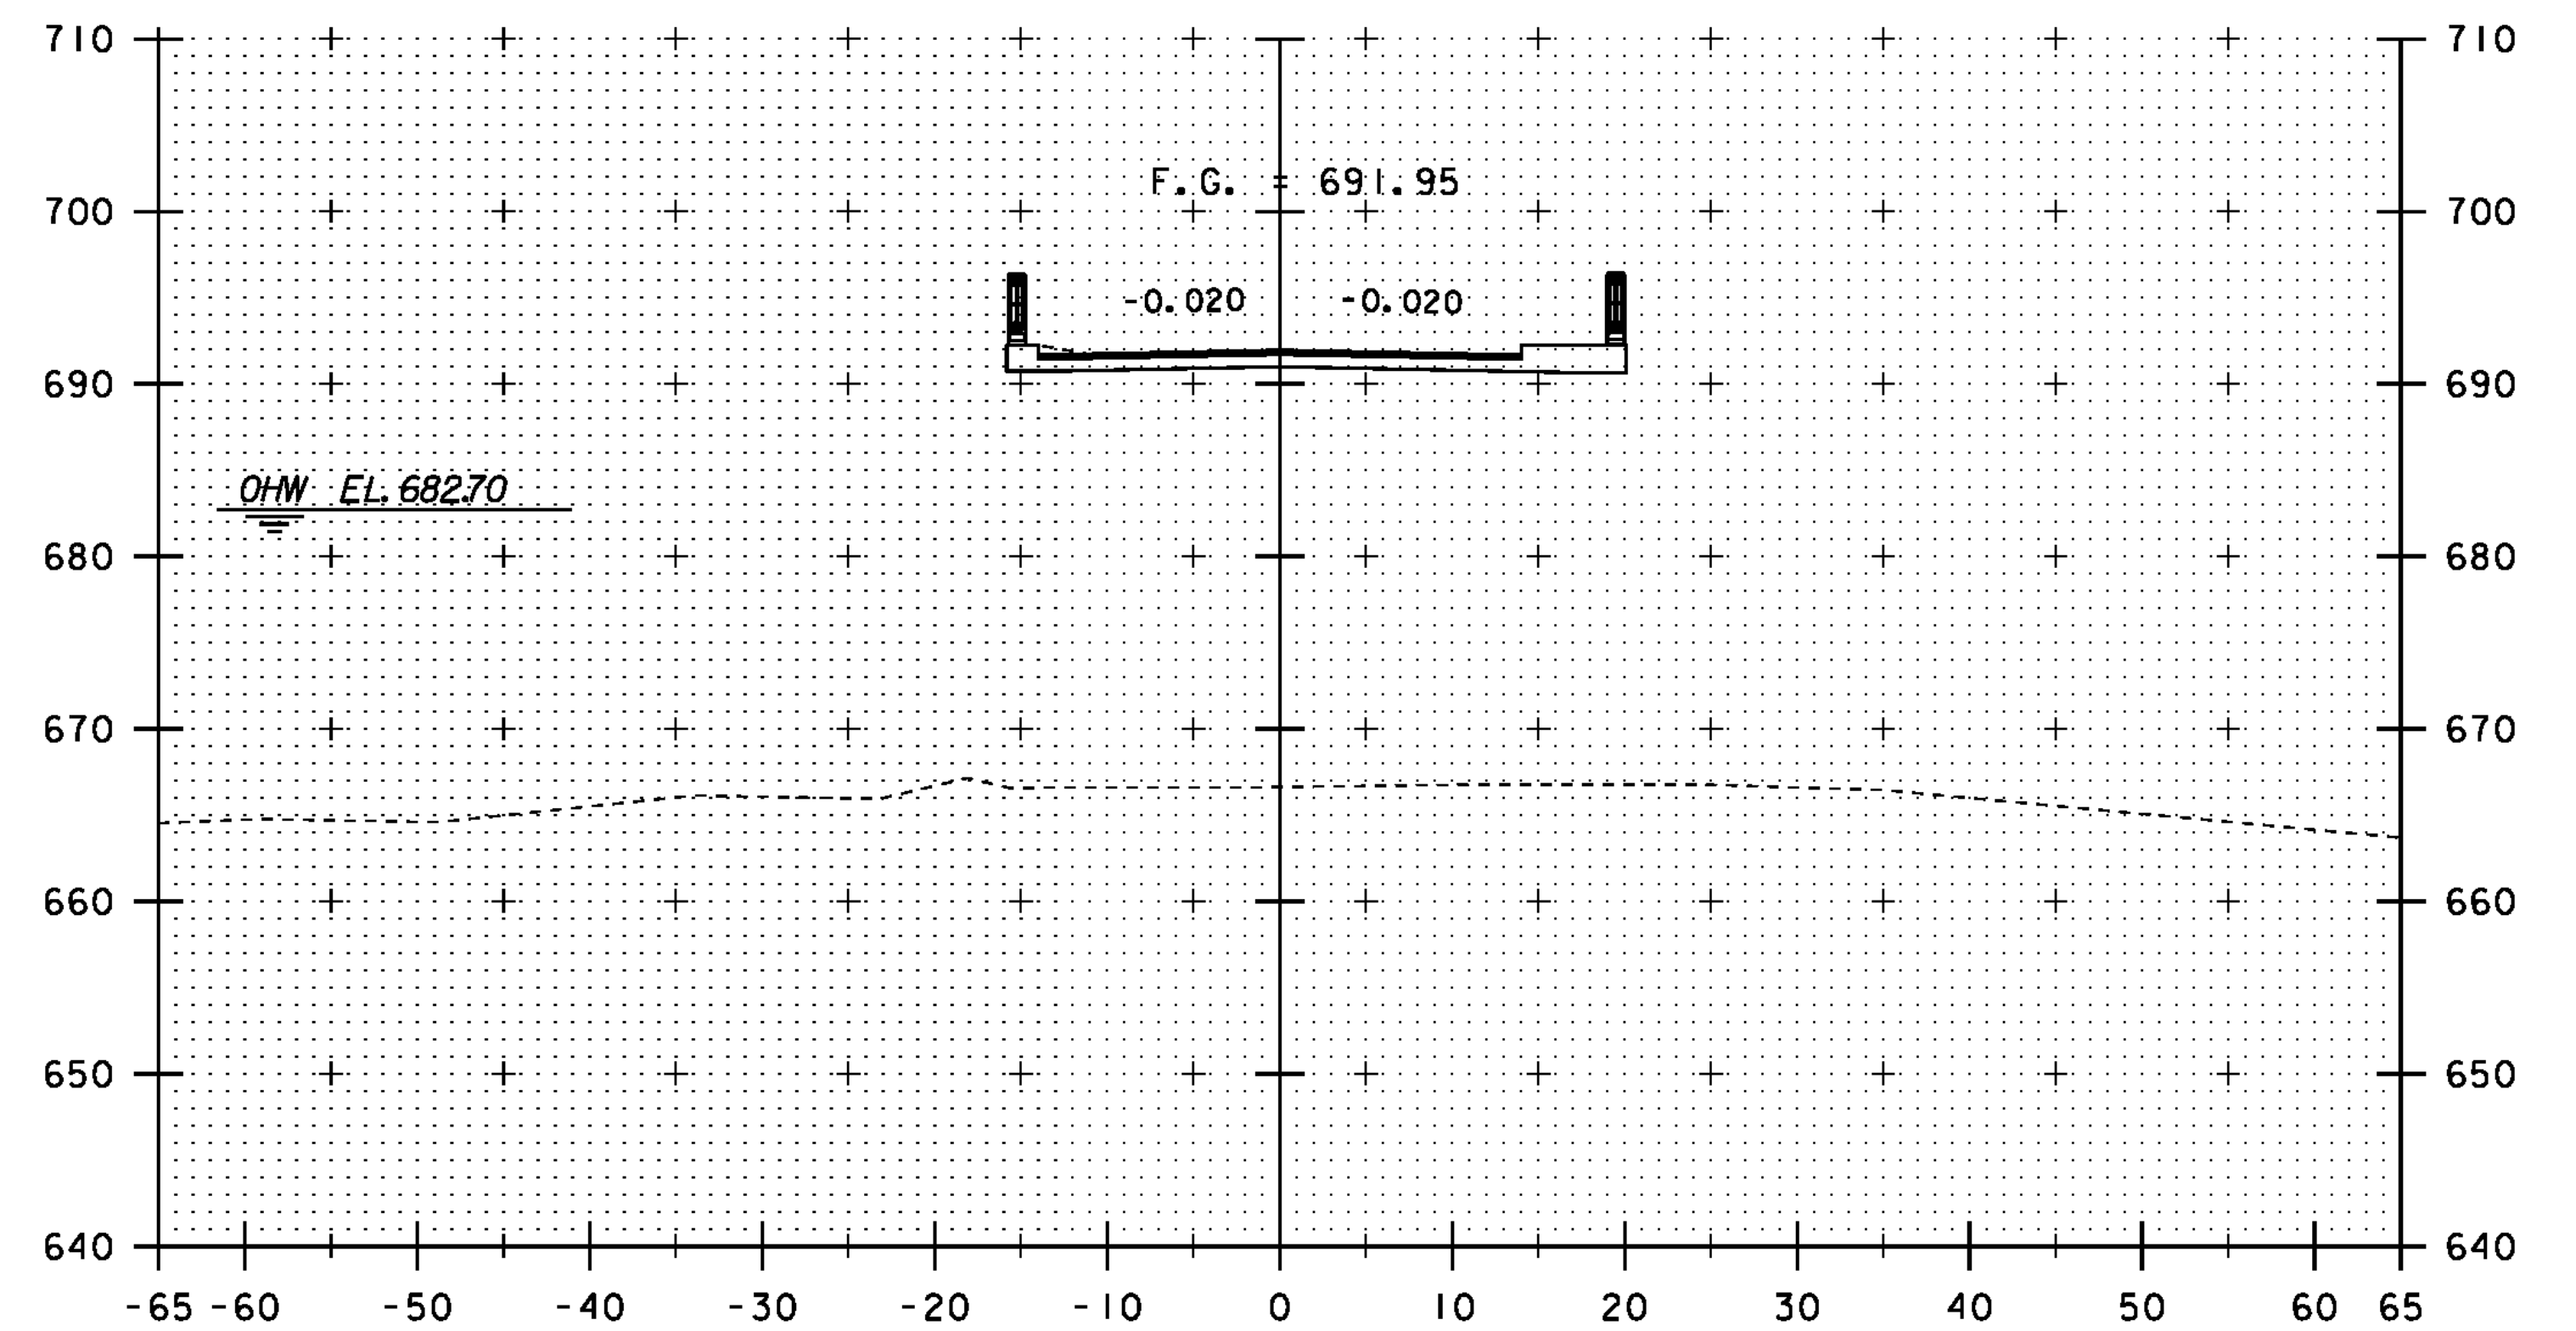

14+25

STA. 13+75 TO STA. 14+50

PROJECT NAME:	NEWPORT CITY	PLOT DATE:	22-NOV-2011
PROJECT NUMBER:	BRO 1449(25)	DRAWN BY:	C. MOONEY
FILE NAME:	96J314/STR/96J314xsl.dgn	CHECKED BY:	C. CARLSON
PROJECT LEADER:	C. CARLSON	DESIGNED BY:	D. PETERSON
DESIGNED BY:	D. PETERSON	MAINLINE SECTION 4	SHEET 52 OF 75