



STA. 14+96.83
 END BRIDGE

14+98 = 14+97.5 (Item 203.15)
 -3.0 ft

15+25

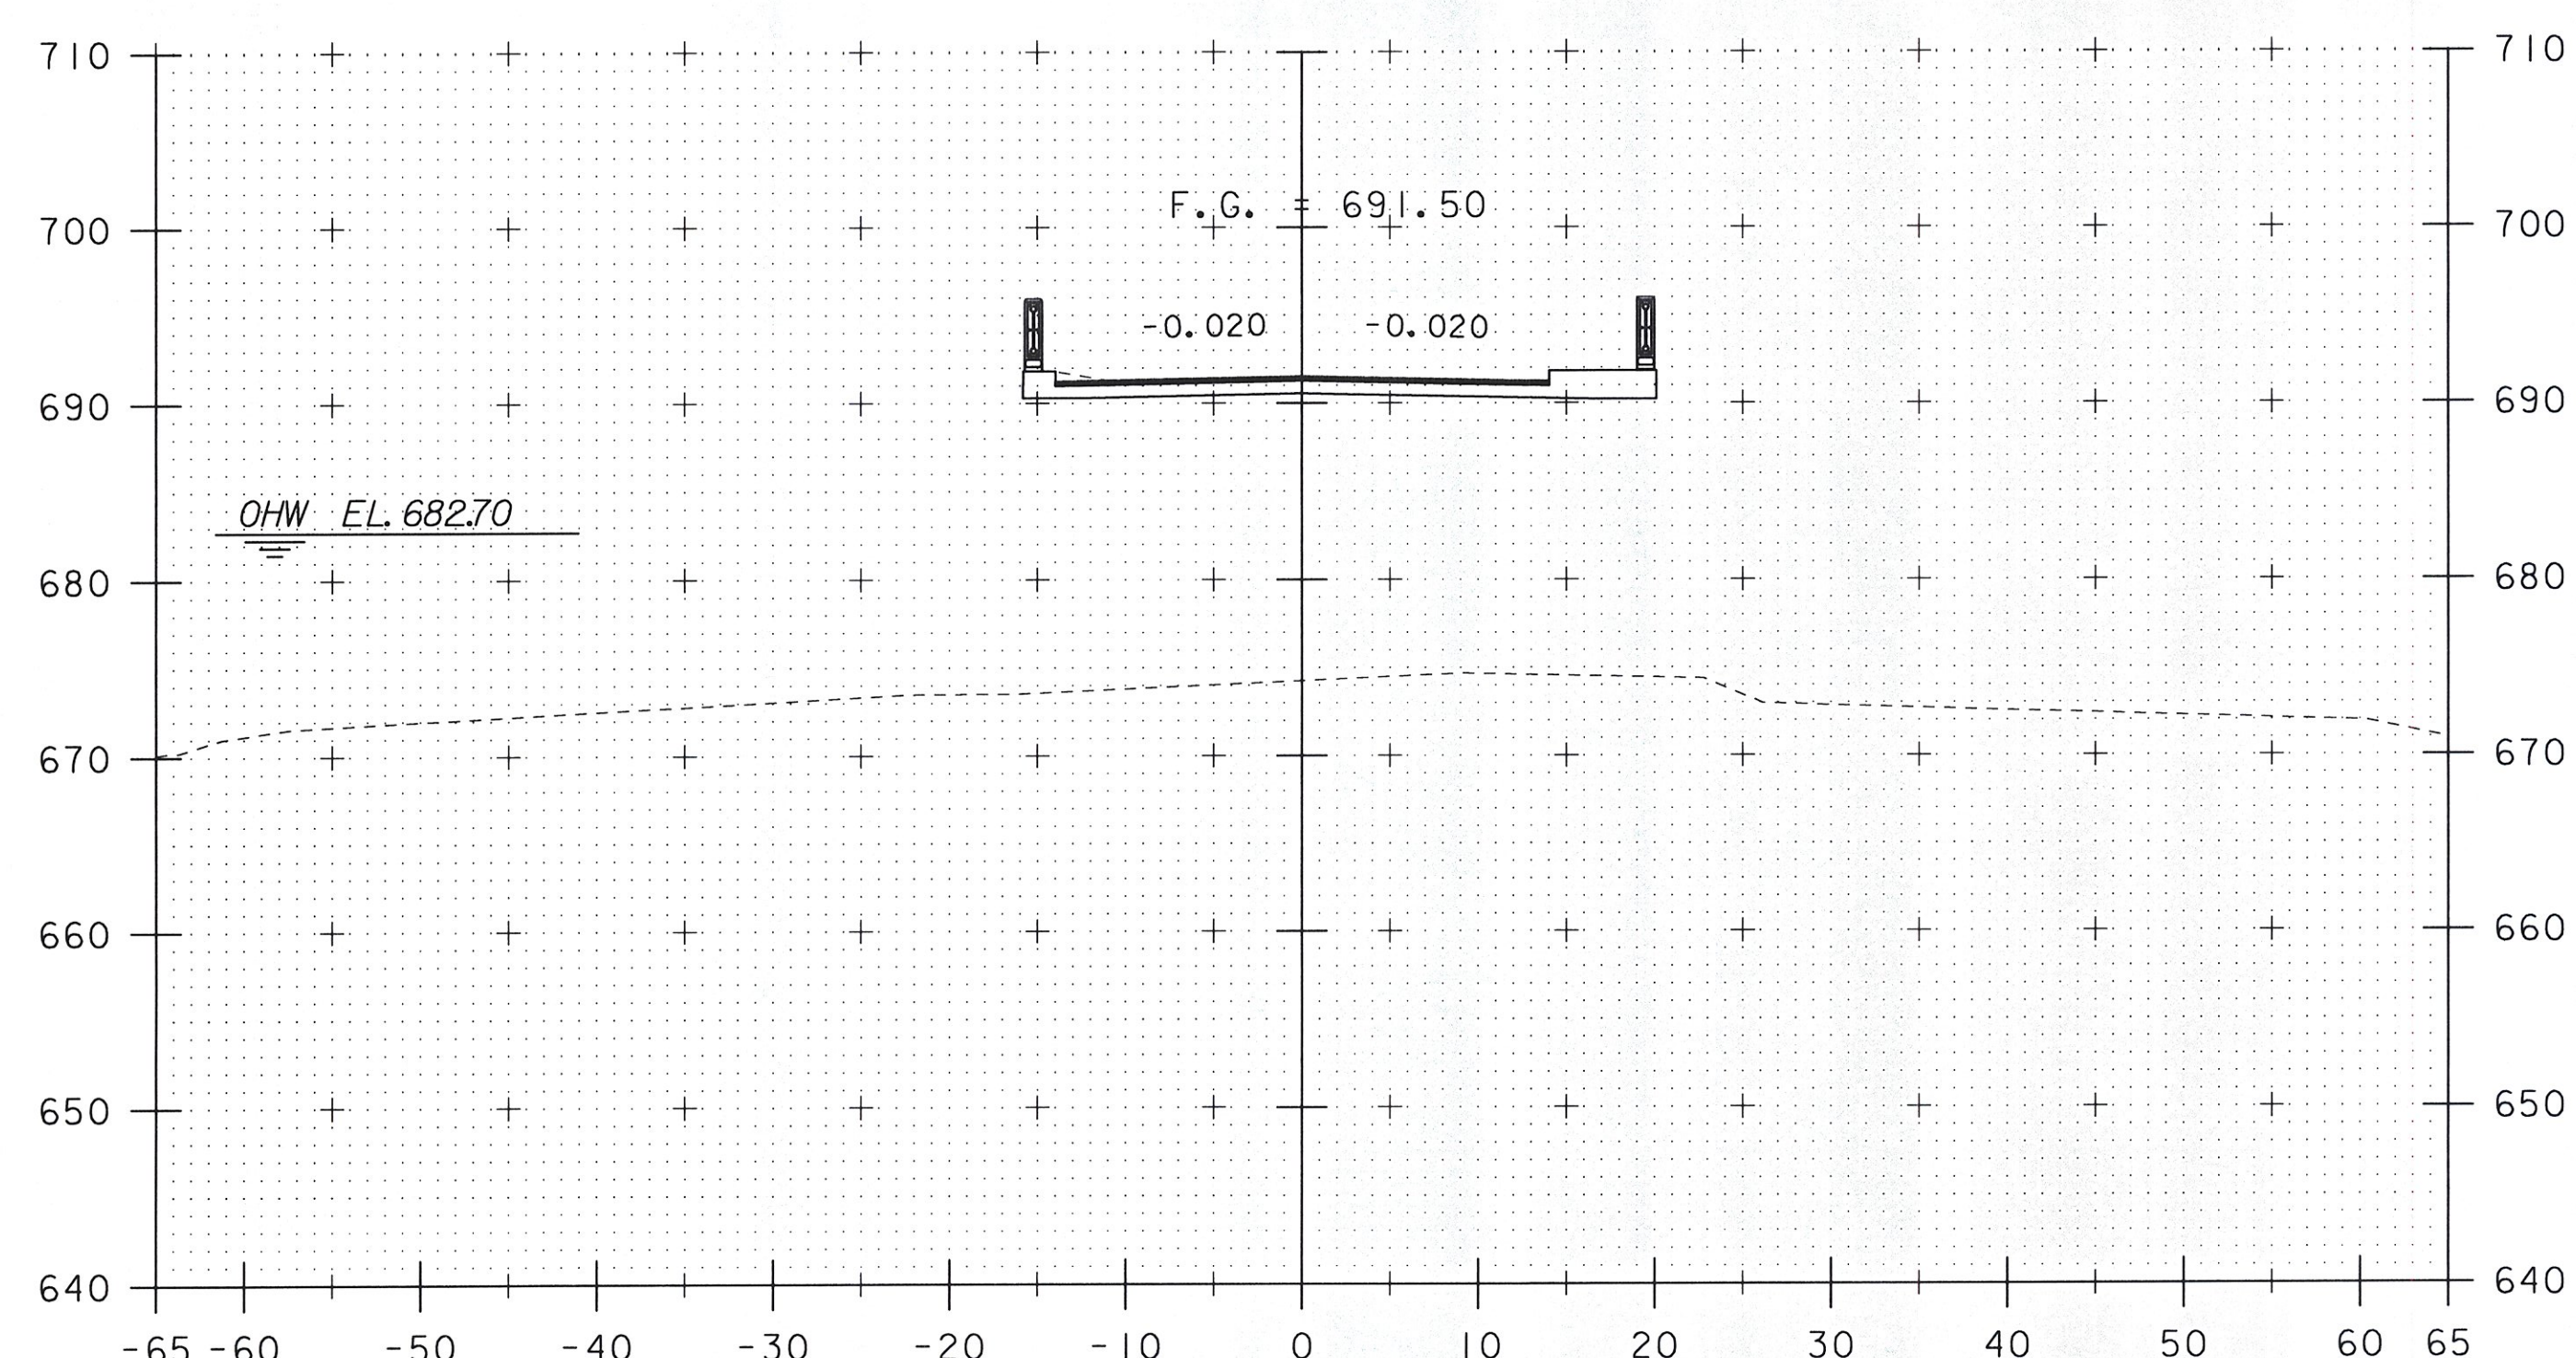

14+75

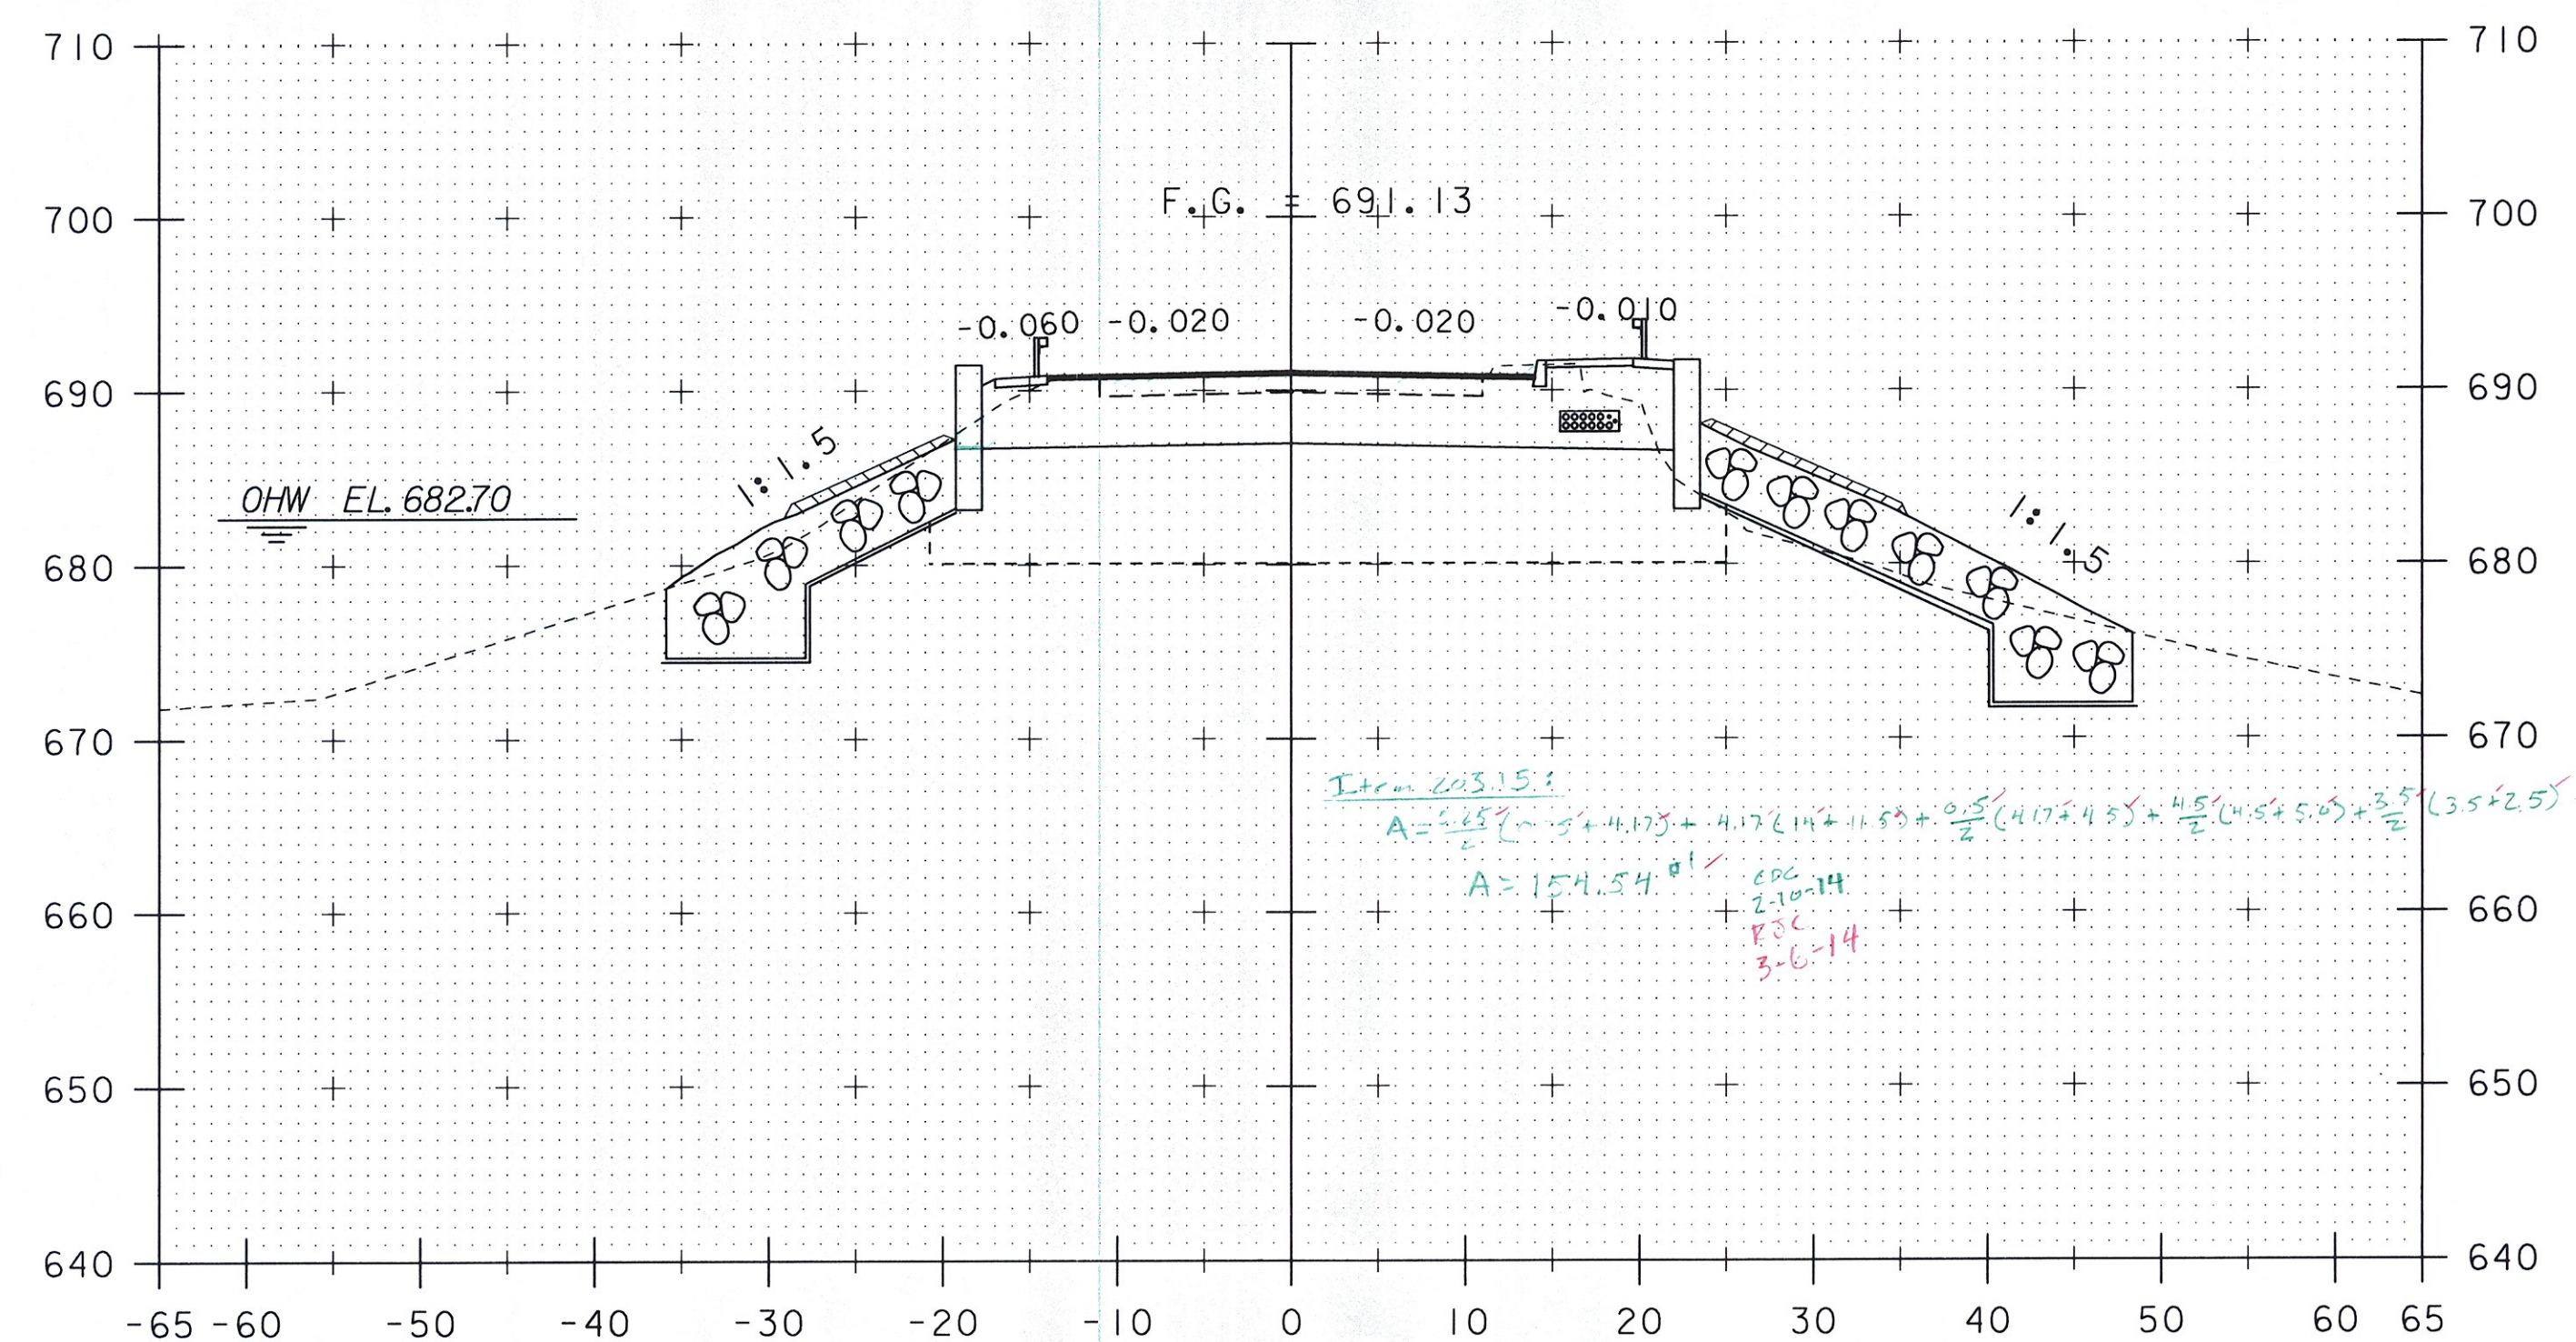

15+00

PROJECT NAME: NEWPORT CITY	PLOT DATE: 02-DEC-2011
PROJECT NUMBER: BRO 1449(25)	DRAWN BY: C. MOONEY
FILE NAME: 96J314/STR/96J314.dgn	CHECKED BY: C. CARLSON
PROJECT LEADER: C. CARLSON	SHEET 53 OF 75
DESIGNED BY: D. PETERSON	
MAINLINE SECTION 5	

STA. 14+75 TO STA. 15+25