



15+75

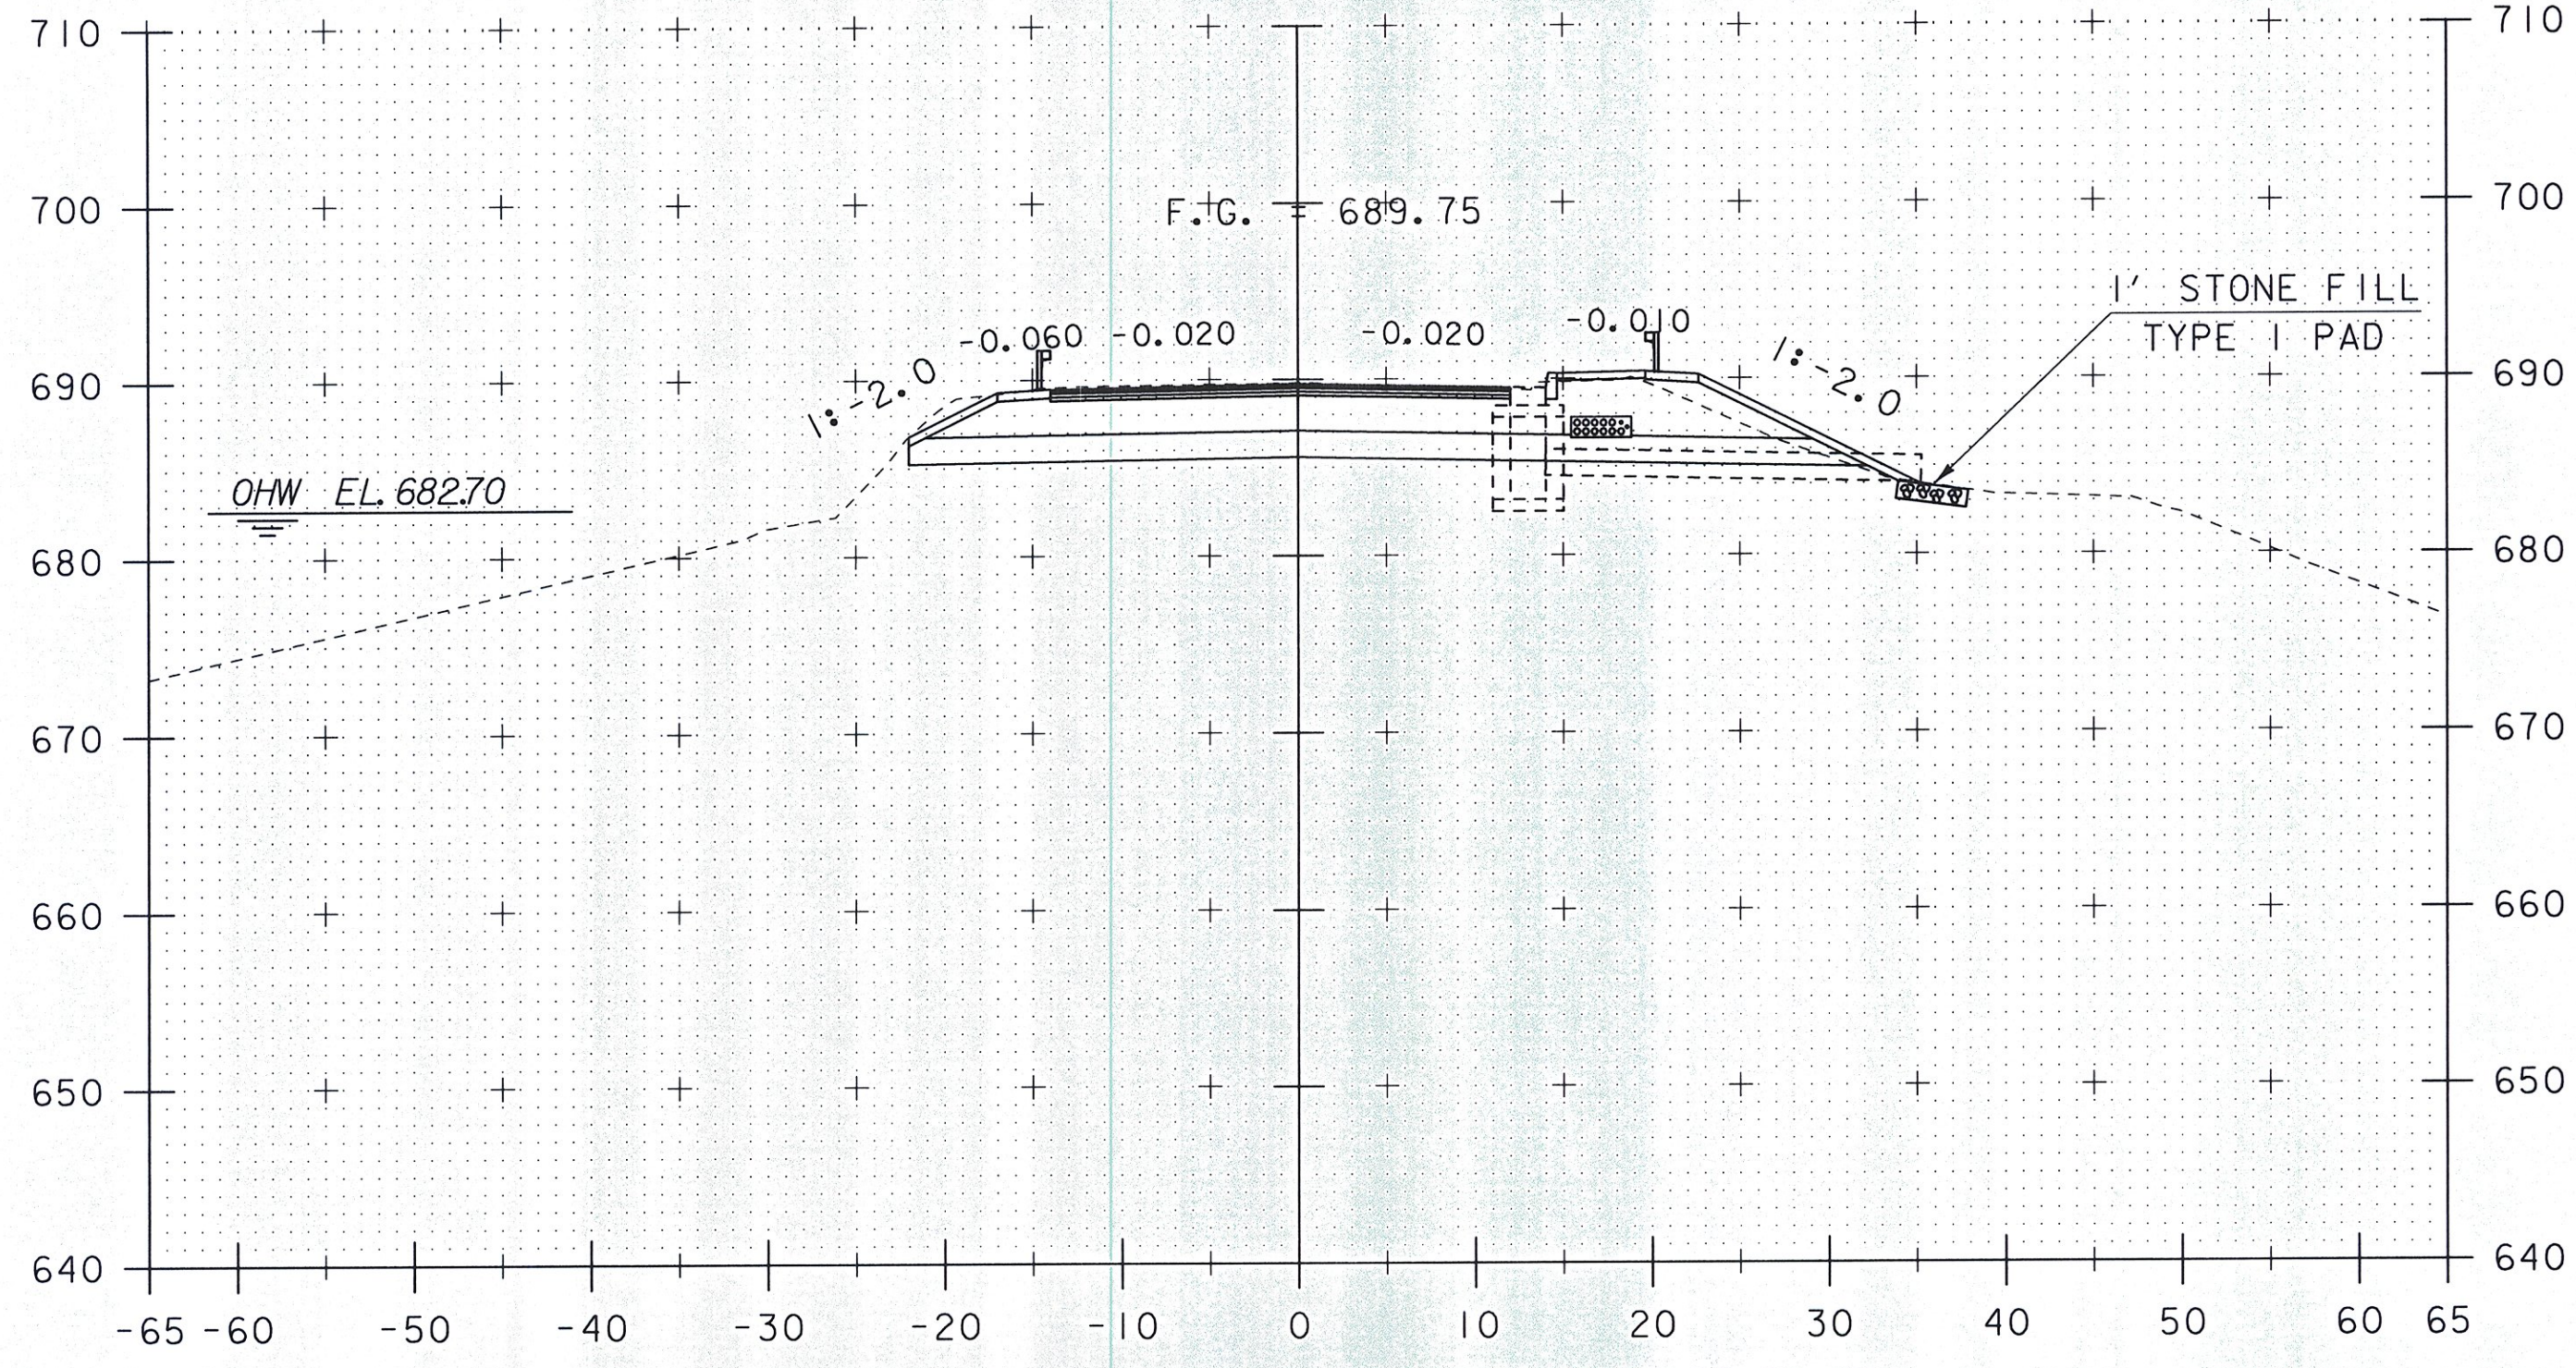


16+25

STA. 16+21.33 RT.
 PRECAST CONCRETE DI W/18"
 OPTION PIPE AND STONE FILL
 TYPE I PAD

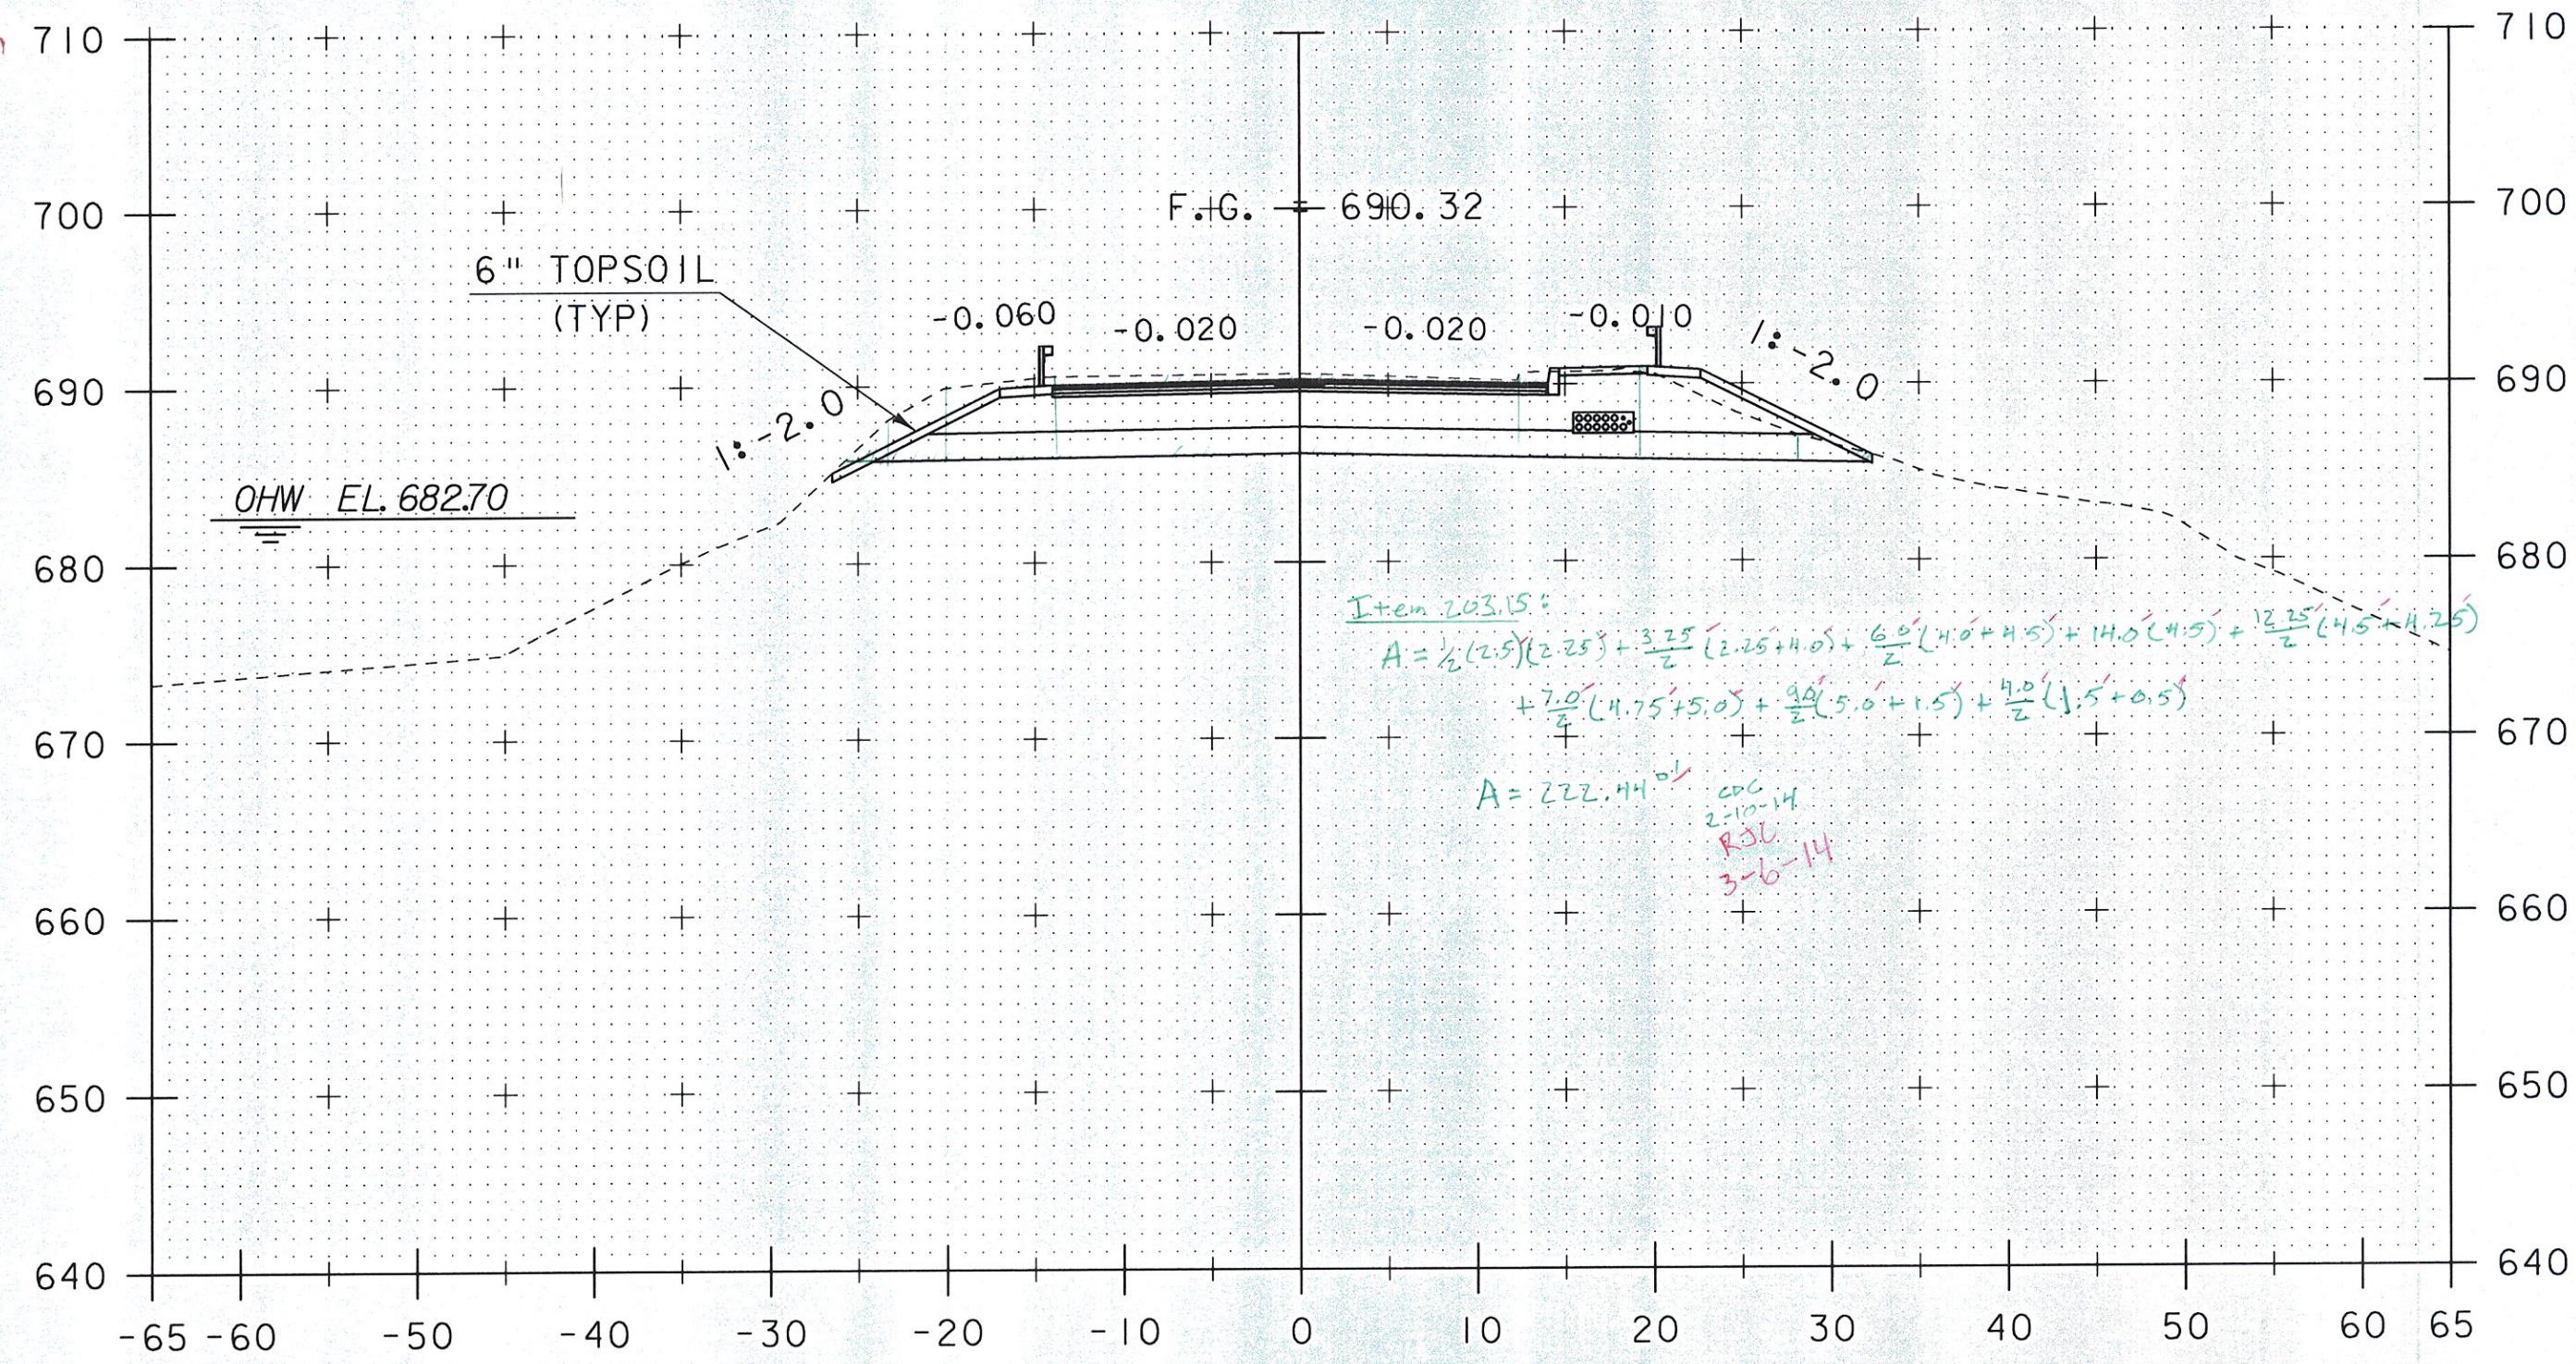

15+50

Item 203.15:
 $A = \frac{1}{2}(13)(2.05) + \frac{3}{2}(2.05+4.05) + \frac{1}{2}(4.05+4.05) + \frac{1}{2}(4.05) + \frac{1}{2}(4.05+4.05)$
 $+ \frac{1}{2}(4.75+5.0) + \frac{1}{2}(5.0+1.5) + \frac{1}{2}(1.5+0.5)$
 $A = 222.11$ sq ft
 2-10-14
 RSC
 3-6-14

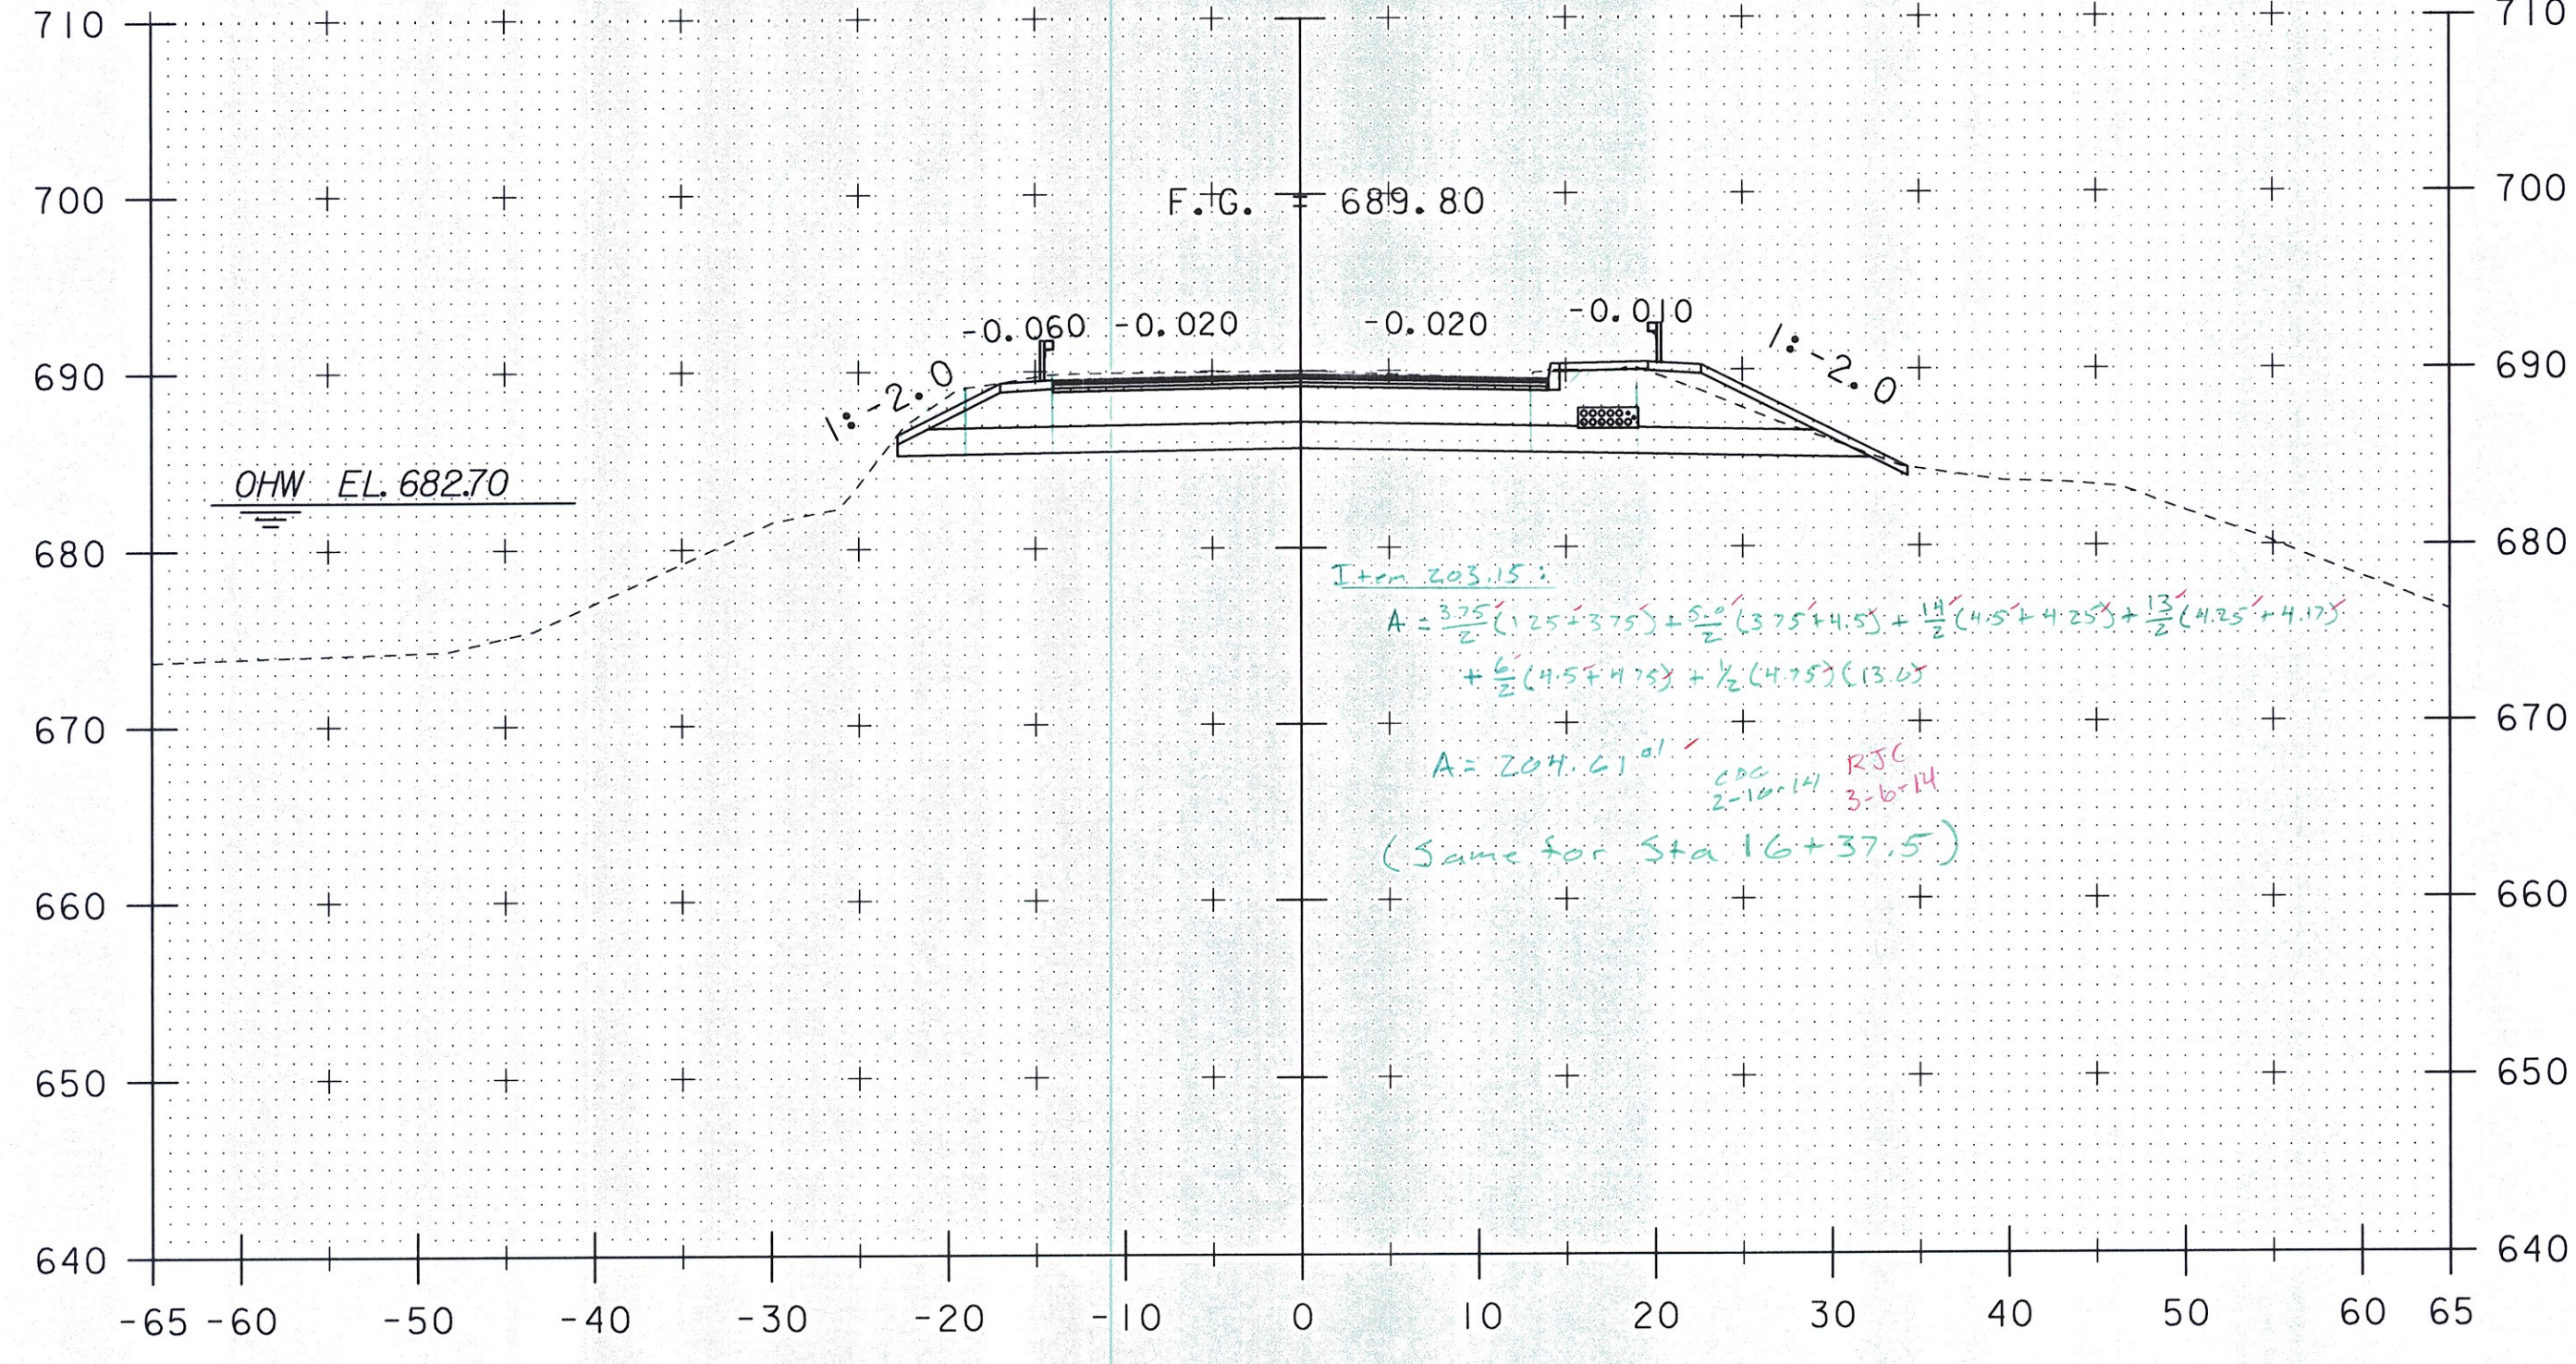

16+00

Item 203.15:
 $A = \frac{3}{2}(1.25+2.75) + \frac{3}{2}(3.75+4.75) + \frac{1}{2}(4.75+4.75) + \frac{1}{2}(4.75+4.75)$
 $+ \frac{1}{2}(4.75+4.75) + \frac{1}{2}(4.75)(13.0)$
 $A = 207.61$ sq ft
 2-10-14 RSC
 3-6-14
 (Same for Sta. 16+37.5)

STA. 15+50 TO STA. 16+25

PROJECT NAME:	NEWPORT CITY	PLOT DATE:	02-DEC-2011
PROJECT NUMBER:	BRO 1449(25)	DRAWN BY:	C. MOONEY
FILE NAME:	96J314/STR/96J314xsl.dgn	CHECKED BY:	C. CARLSON
PROJECT LEADER:	C. CARLSON	DESIGNED BY:	D. PETERSON
DESIGNED BY:	D. PETERSON	MAINLINE SECTION 6	SHEET 54 OF 75