



STA. 50+53.40 LT
 BEGIN GRANULAR BACKFILL
 FOR STRUCTURES

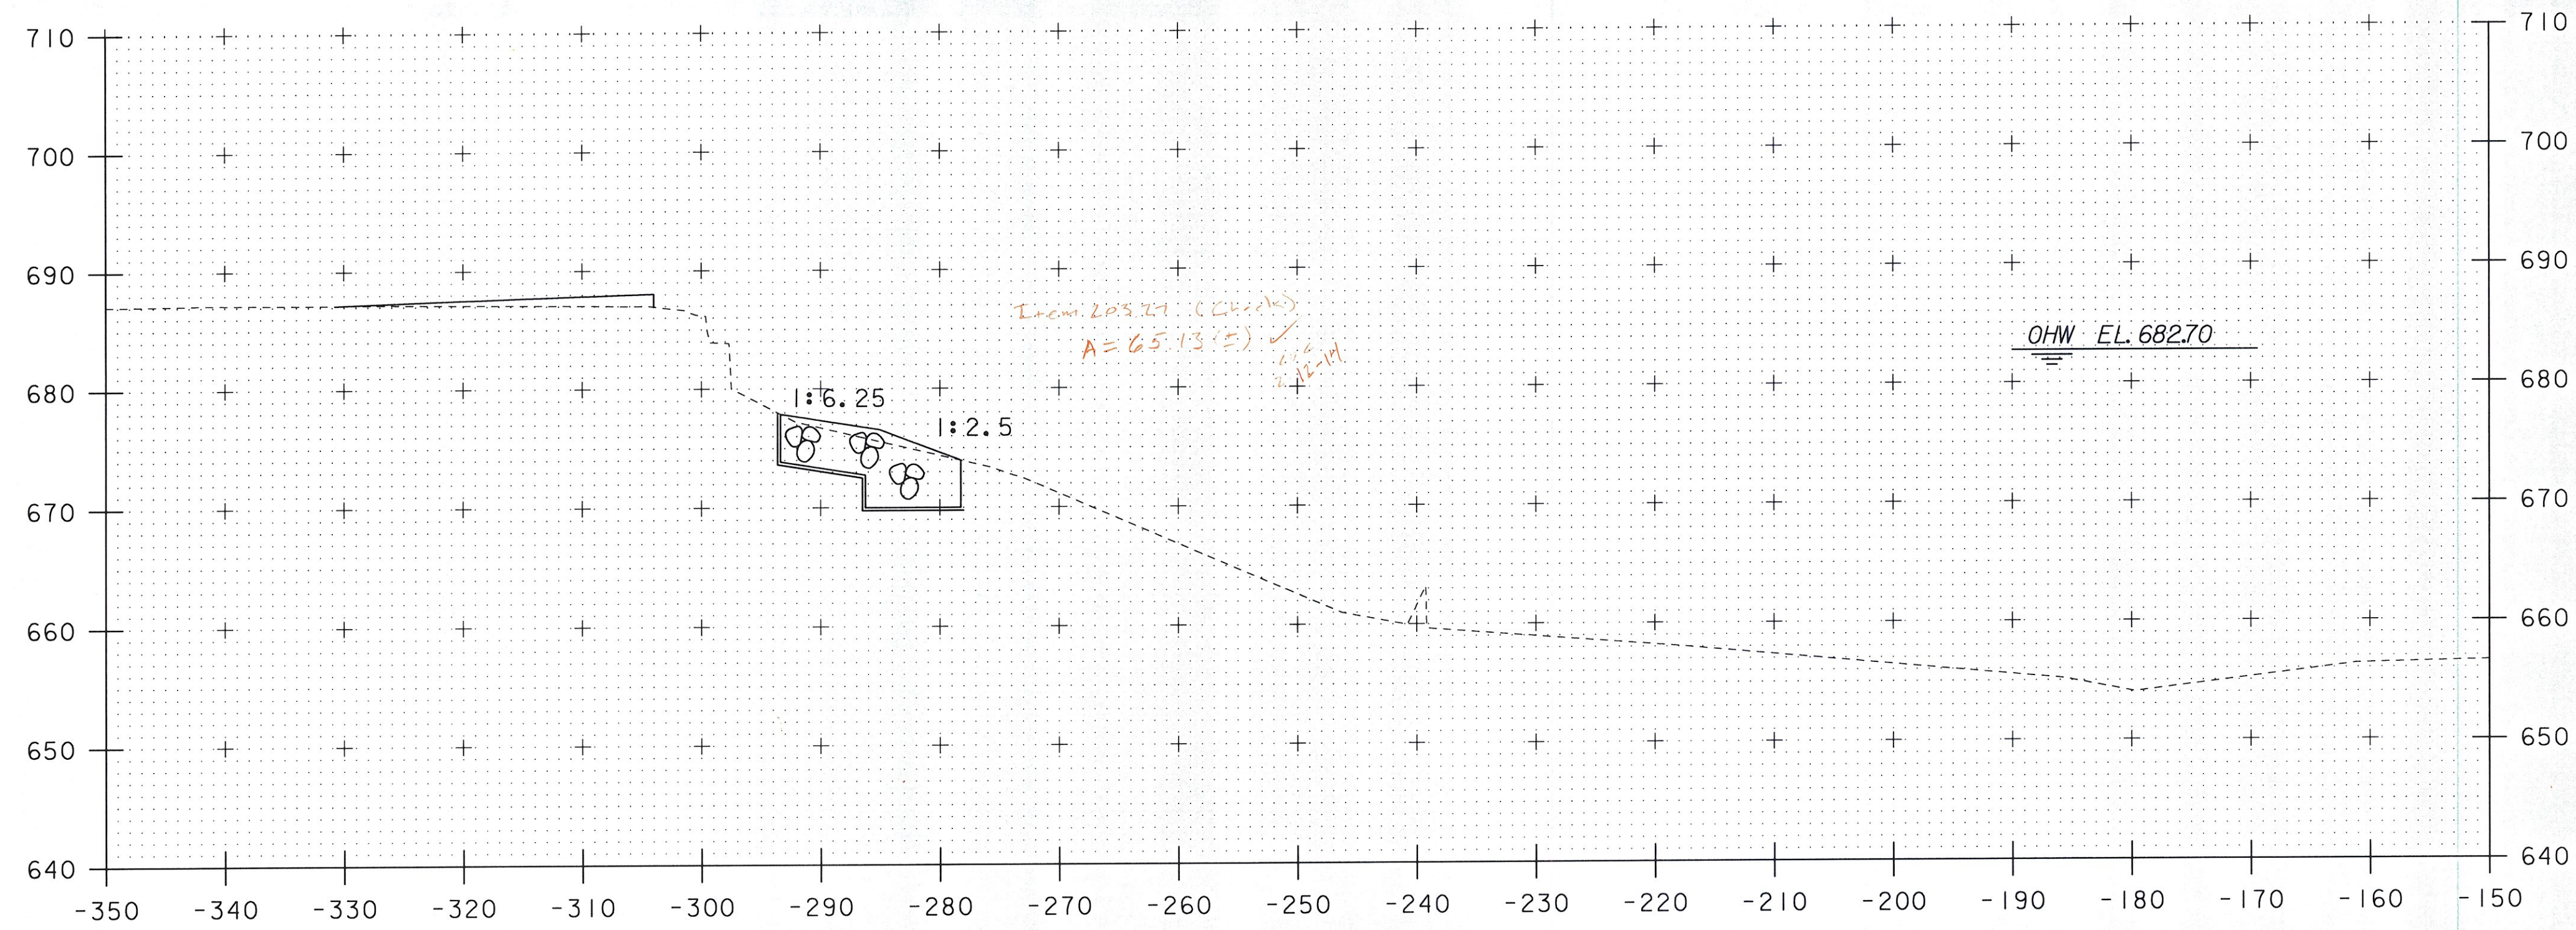

STA. 50+47.93 LT
 BEGIN UNCLASSIFIED CHANNEL EXCAVATION
 GEOTEXTILE UNDER STONE FILL
 STONE FILL, TYPE IV
 GRUBBING MATERIAL

50+50

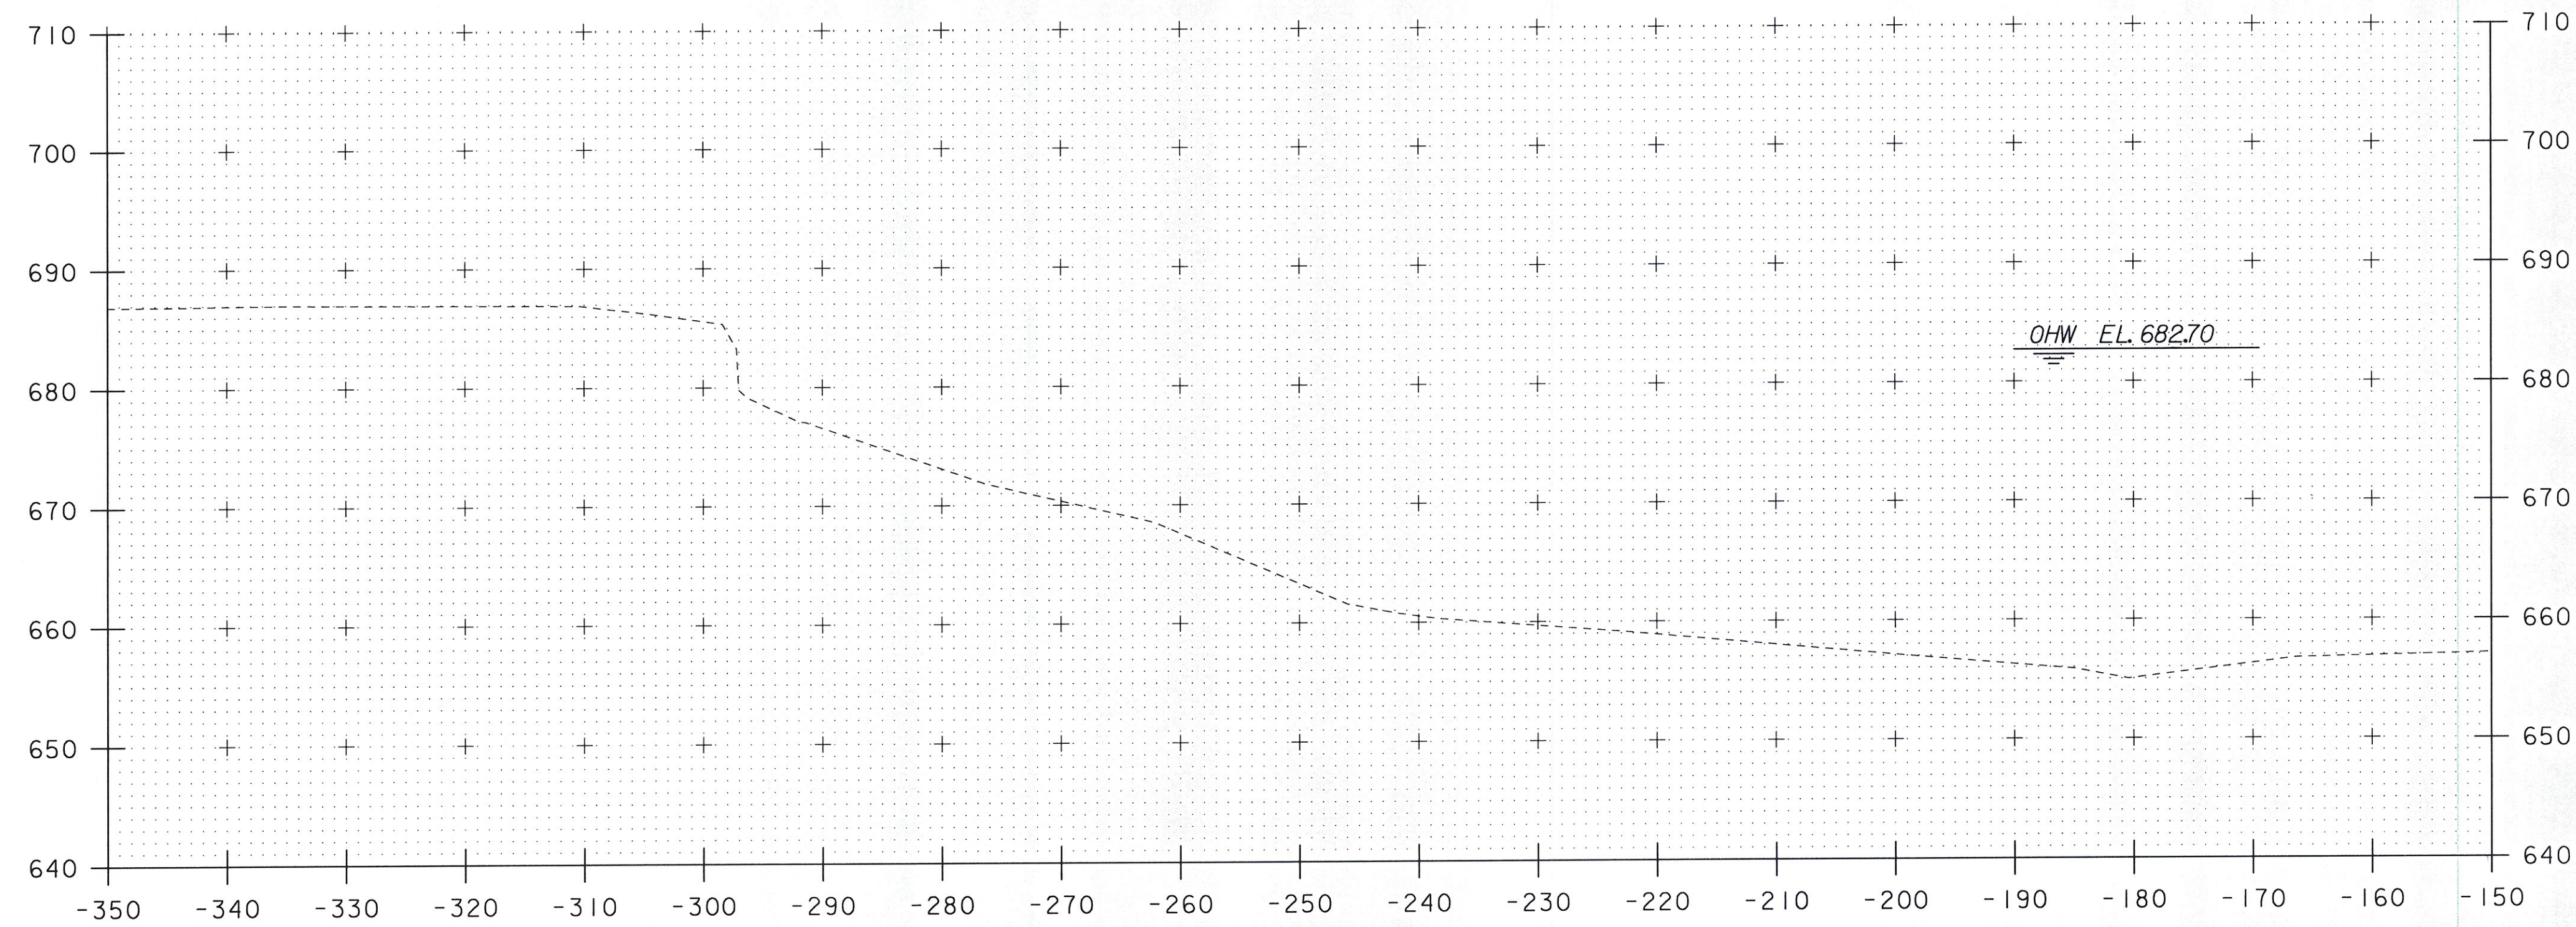

50+40

CHANNEL LT. STA. 50+40 TO STA. 50+50

PROJECT NAME: NEWPORT CITY	PLOT DATE: 22-NOV-2011
PROJECT NUMBER: BRO 1449(25)	DRAWN BY: C. MOONEY
FILE NAME: 96j314/STR/96j314xsl.dgn	CHECKED BY: C. CARLSON
PROJECT LEADER: C. CARLSON	SHEET 57 OF 75
DESIGNED BY: D. PETERSON	
ABUTMENT CHANNEL SECTION I	