


50+80

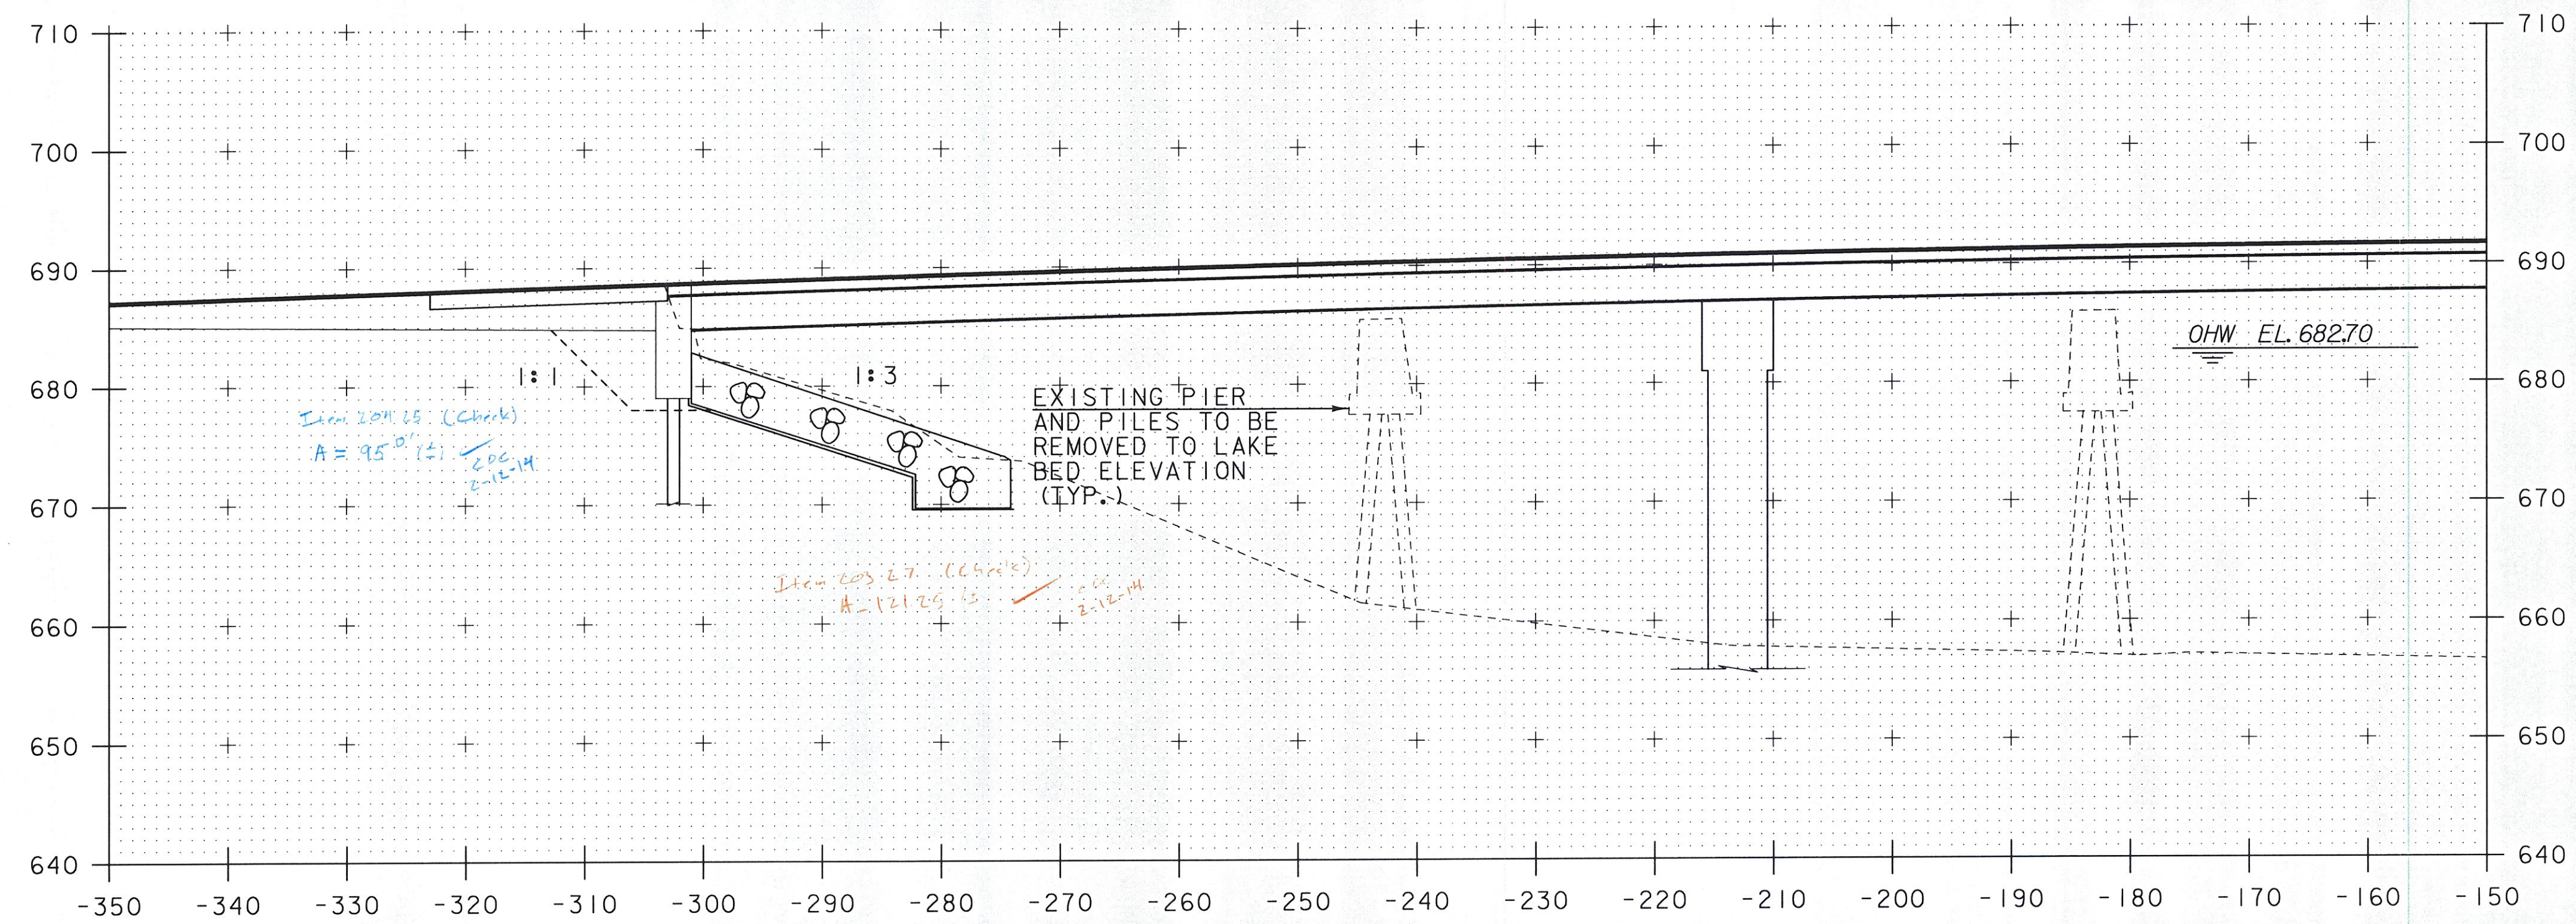

50+75

CHANNEL LT. STA. 50+75 TO STA. 50+80

PROJECT NAME:	NEWPORT CITY	PLOT DATE:	22-NOV-2011
PROJECT NUMBER:	BRO 1449(25)	DRAWN BY:	C. MOONEY
FILE NAME:	96J314/STR/96J314xsl.dgn	DESIGNED BY:	D. PETERSON
PROJECT LEADER:	C. CARLSON	CHECKED BY:	C. CARLSON
ABUTMENT CHANNEL SECTION 3		SHEET	59 OF 75