



STA. 51+05 LT  
 END UNCLASSIFIED CHANNEL EXCAVATION  
 GEOTEXTILE UNDER STONE FILL  
 STONE FILL, TYPE IV  
 GRUBBING MATERIAL

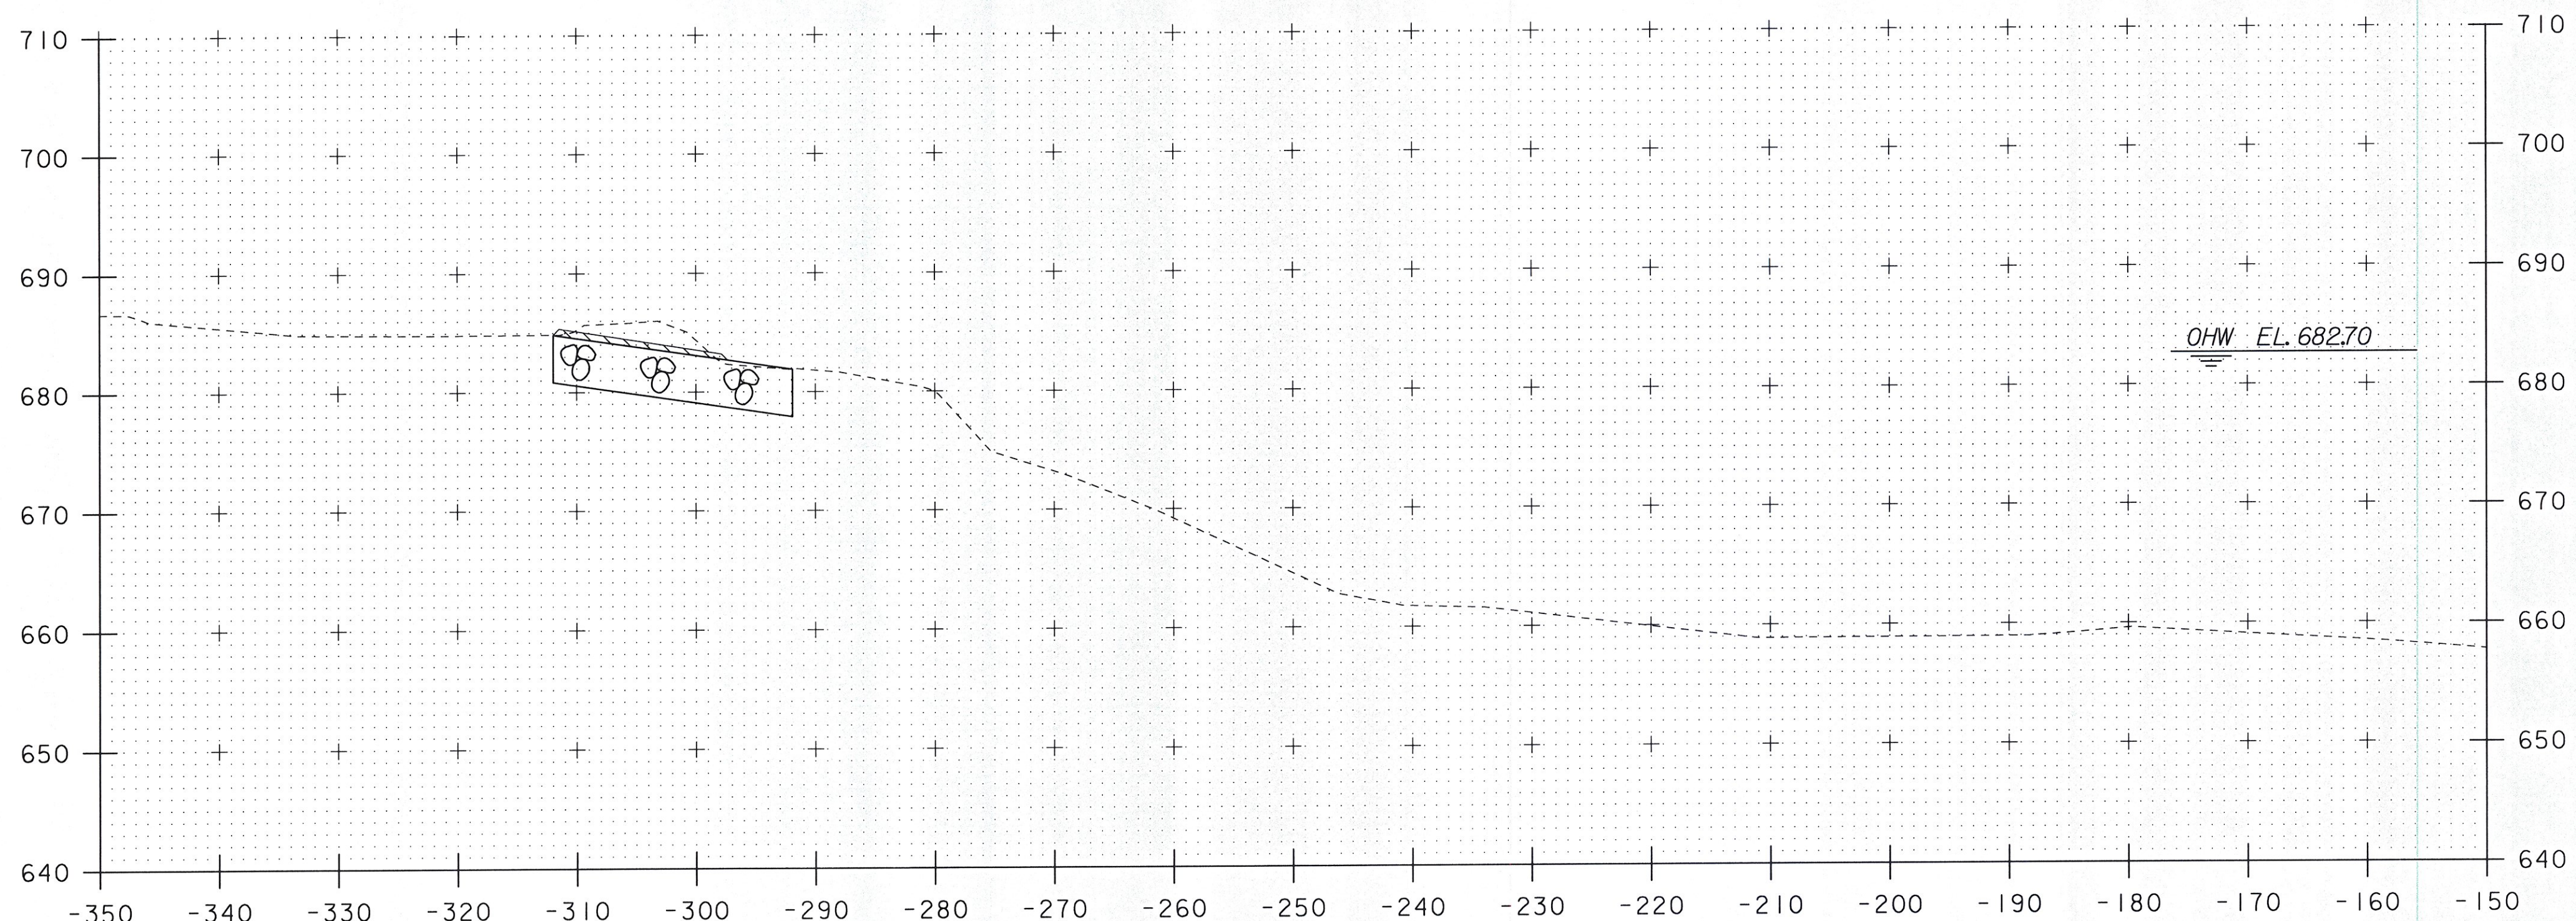

STA. 50+91 LT  
 BEGIN GRUBBING MATERIAL  
 STA. 50+92 LT  
 END GRANULAR BACKFILL  
 FOR STRUCTURES

51+00

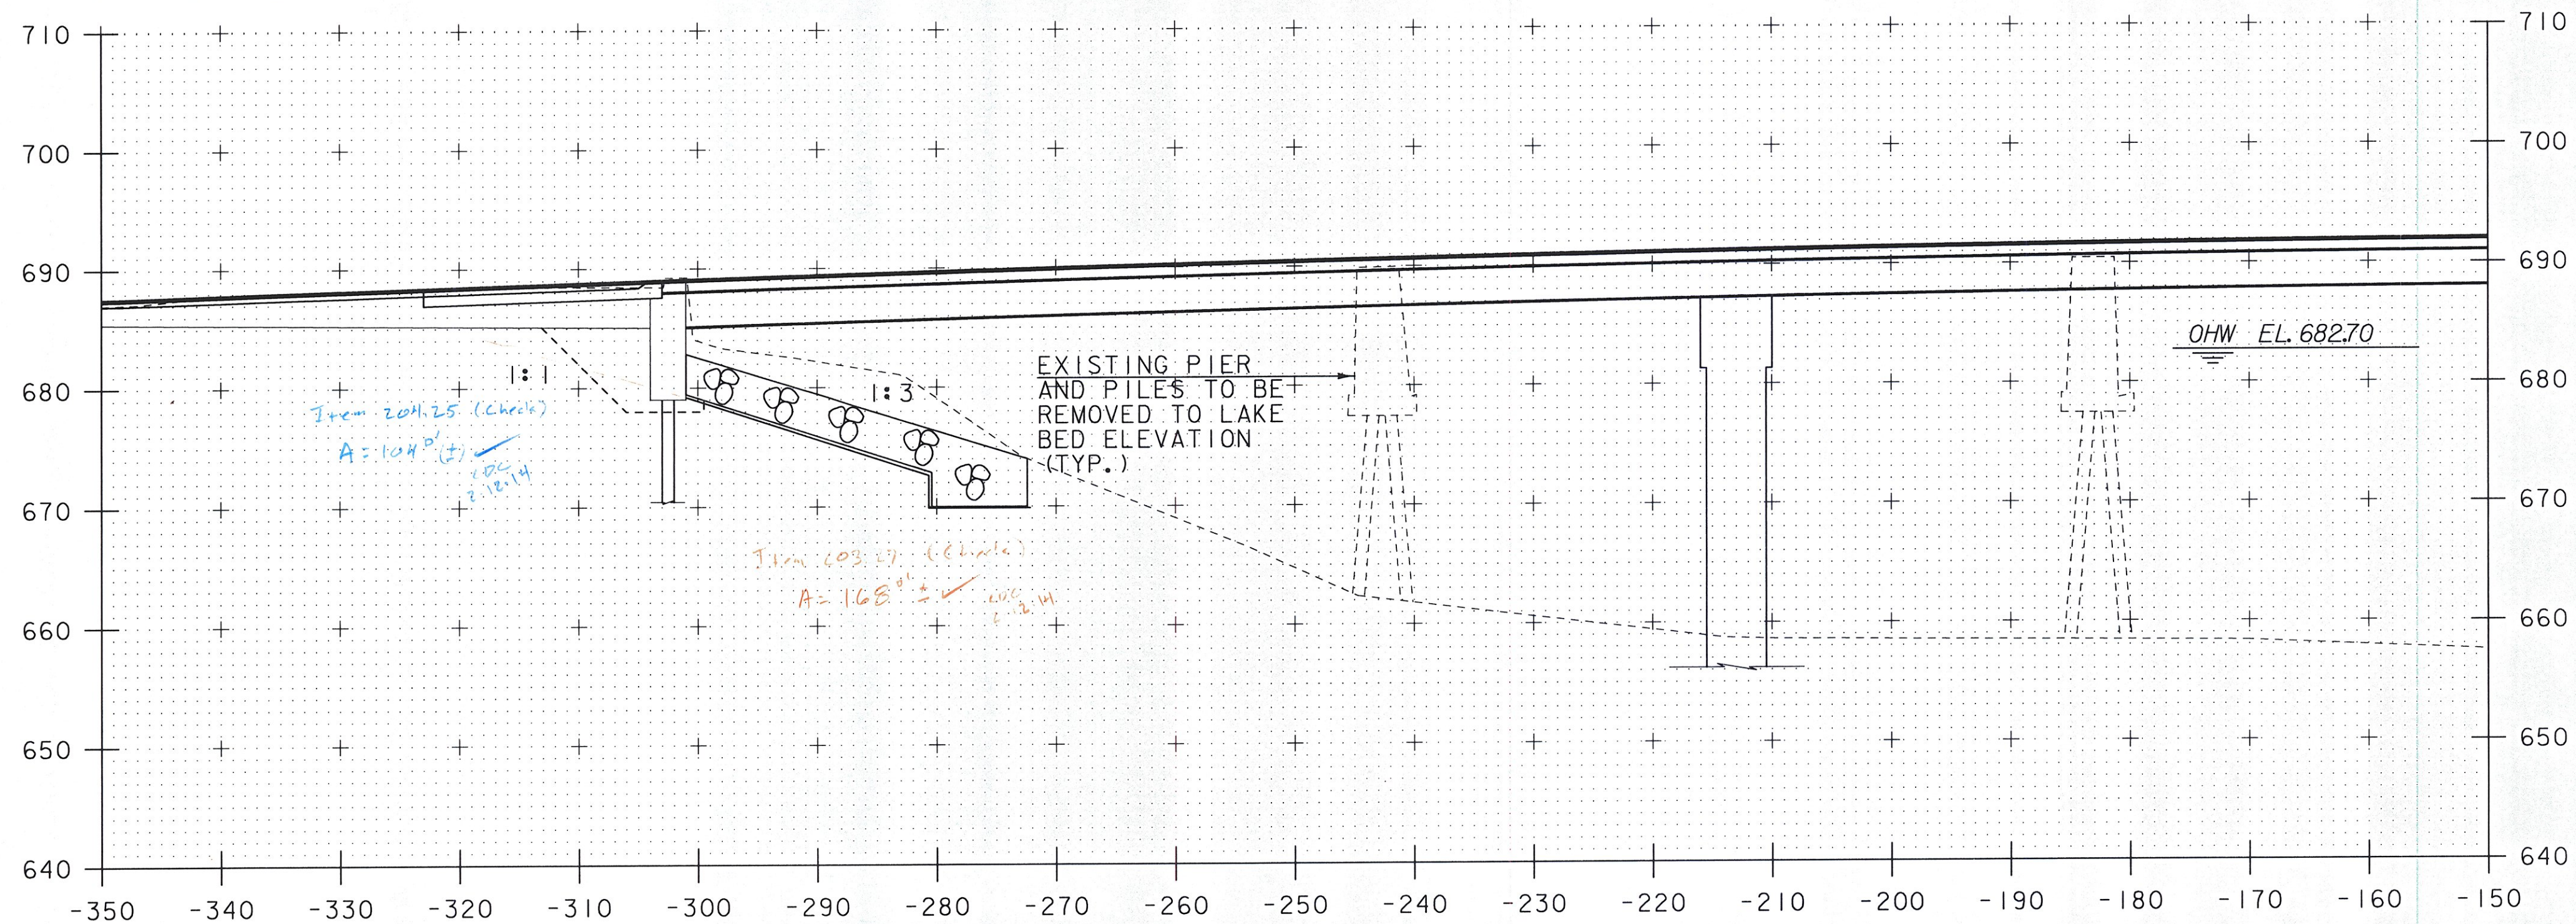

50+90

PROJECT NAME:	NEWPORT CITY	PLOT DATE:	22-NOV-2011
PROJECT NUMBER:	BRO 1449(25)	DRAWN BY:	C. MOONEY
FILE NAME:	96J314/STR/96J314xsl.dgn	CHECKED BY:	C. CARLSON
PROJECT LEADER:	C. CARLSON	SHEET	60 OF 75
DESIGNED BY:	D. PETERSON		
ABUTMENT CHANNEL SECTION 4			

CHANNEL LT. STA. 50+90 TO STA. 51+00