


50+30

STA. 50+29 RT  
 BEGIN UNCLASSIFIED CHANNEL EXCAVATION  
 GEOTEXTILE UNDER STONE FILL  
 STONE FILL, TYPE IV  
 GRUBBING MATERIAL

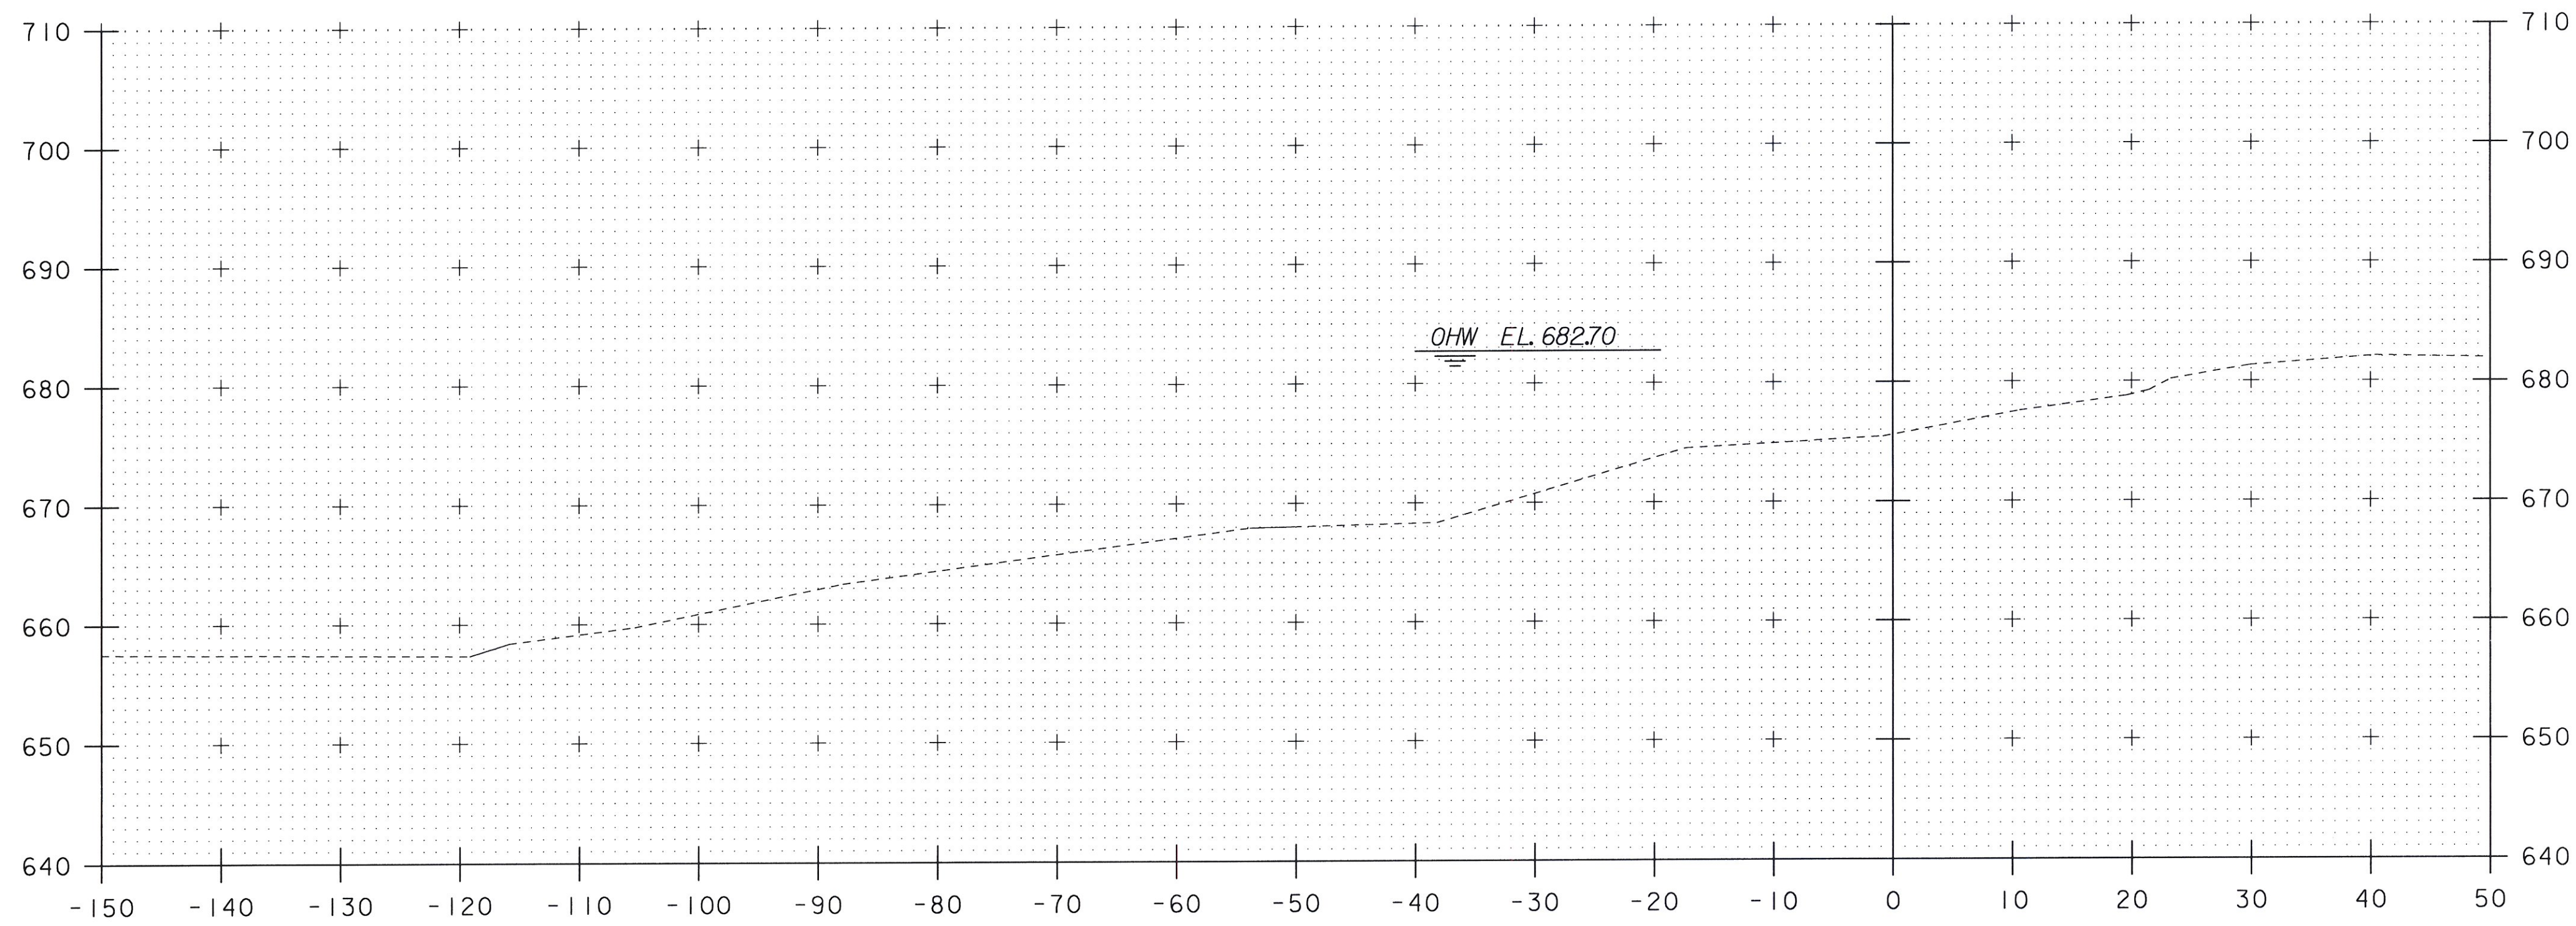

50+25

CHANNEL RT. STA. 50+25 TO STA. 50+30

PROJECT NAME:	NEWPORT CITY	PLOT DATE:	22-NOV-2011
PROJECT NUMBER:	BRO 1449(25)	DRAWN BY:	C. MOONEY
FILE NAME:	96J314/STR/96J314xsl.dgn	DESIGNED BY:	D. PETERSON
PROJECT LEADER:	C. CARLSON	CHECKED BY:	C. CARLSON
ABUTMENT 2 CHANNEL SECTION 1		SHEET	61 OF 75