



STA. 50+54.90 RT
END GRUBBING MATERIAL

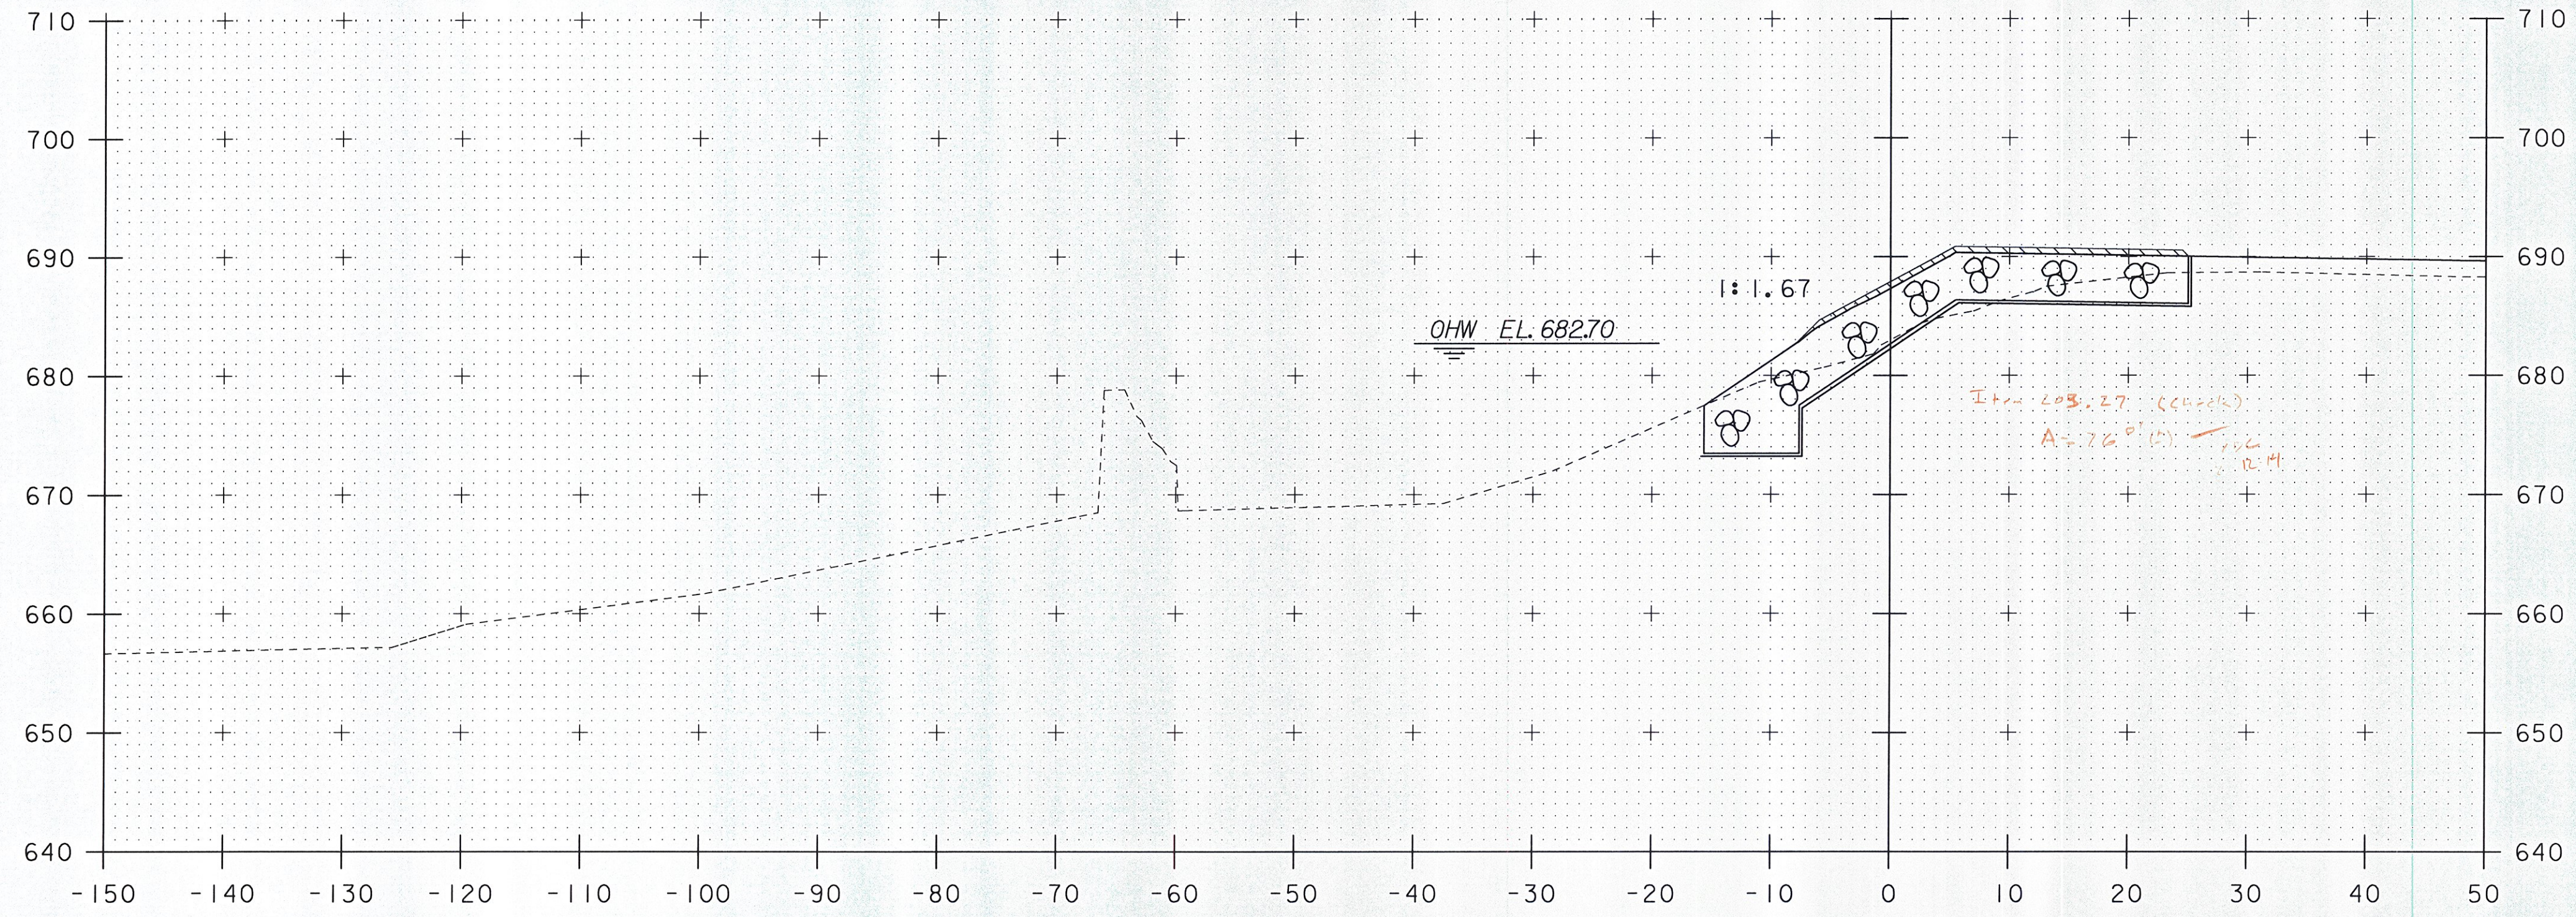

50+50

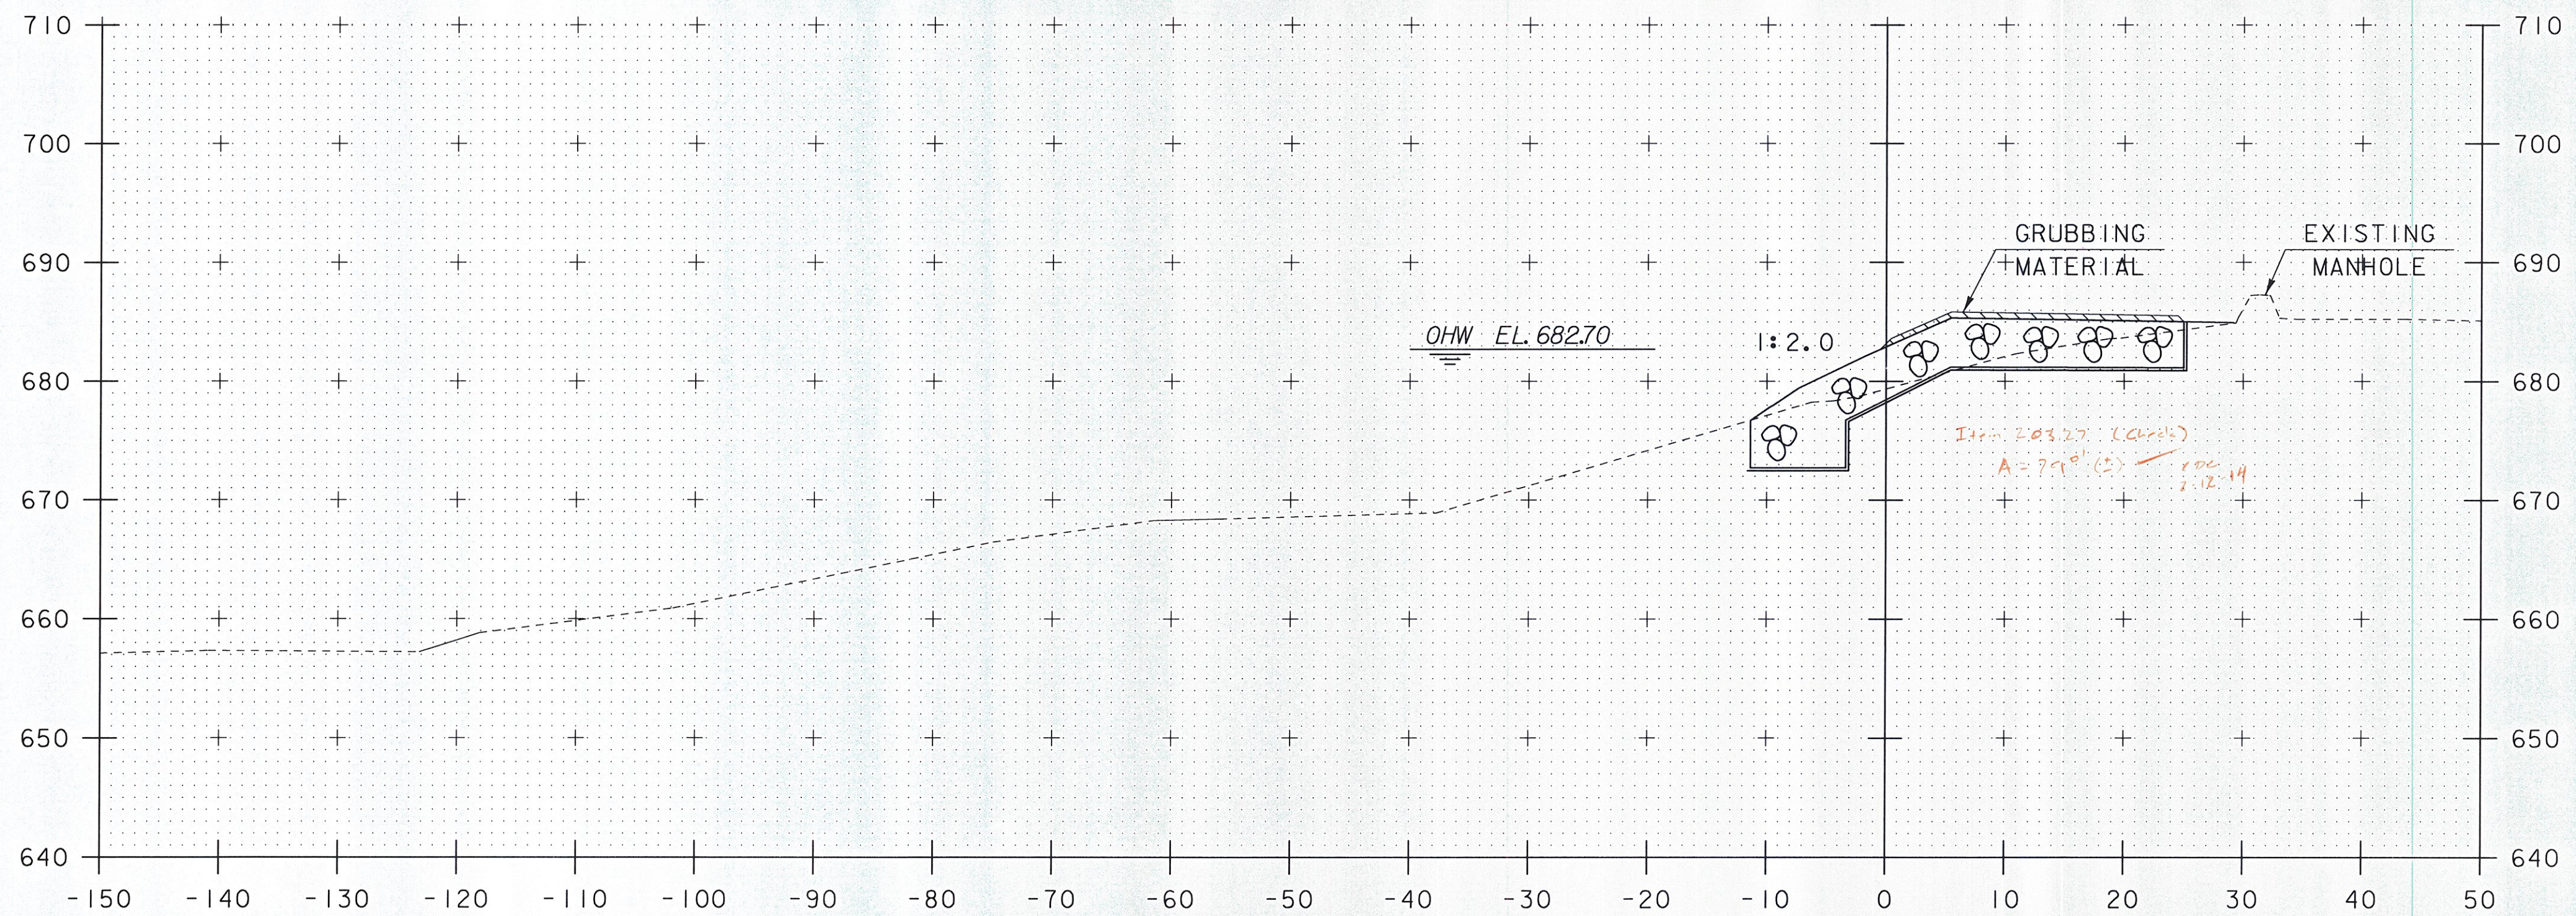

50+40

PROJECT NAME:	NEWPORT CITY	PLLOT DATE:	22-NOV-2011
PROJECT NUMBER:	BRO 1449(25)	DRAWN BY:	C. MOONEY
FILE NAME:	96J314/STR/96J314xsl.dgn	DESIGNED BY:	D. PETERSON
PROJECT LEADER:	C. CARLSON	CHECKED BY:	C. CARLSON
ABUTMENT 2 CHANNEL SECTION 2		SHEET	62 OF 75

CHANNEL RT. STA. 50+40 TO STA. 50+50