


50+70

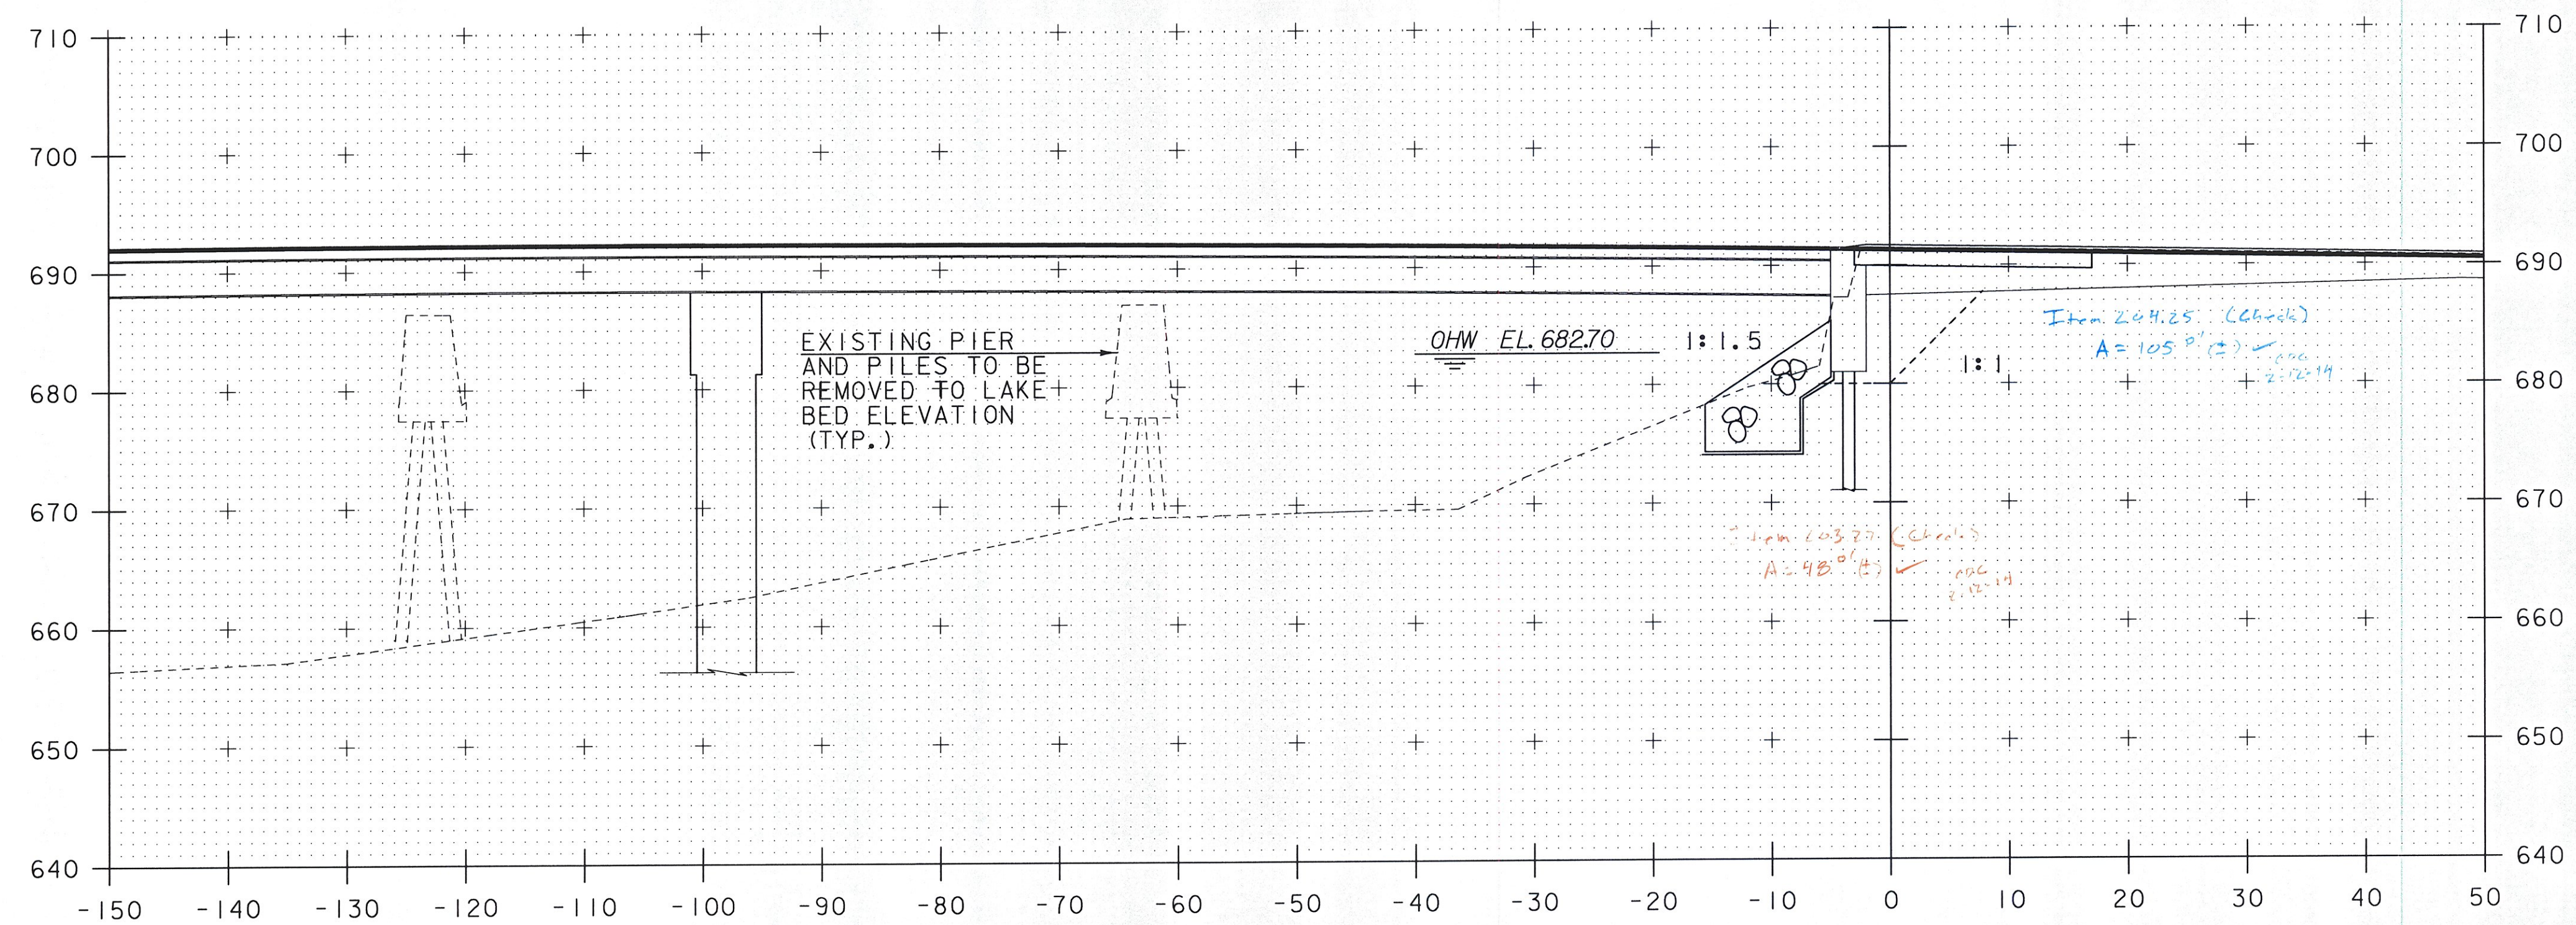

50+60

STA. 50+53.40 RT  
BEGIN GRANULAR BACKFILL  
FOR STRUCTURES

CHANNEL RT. STA. 50+60 TO STA. 50+70

PROJECT NAME:	NEWPORT CITY	PLOT DATE:	22-NOV-2011
PROJECT NUMBER:	BRO 1449(25)	DRAWN BY:	C. MOONEY
FILE NAME:	96J314/STR/96J314xsl.dgn	CHECKED BY:	C. CARLSON
PROJECT LEADER:	C. CARLSON	ABUTMENT 2 CHANNEL SECTION 3	SHEET 63 OF 75
DESIGNED BY:	D. PETERSON		