


50+80

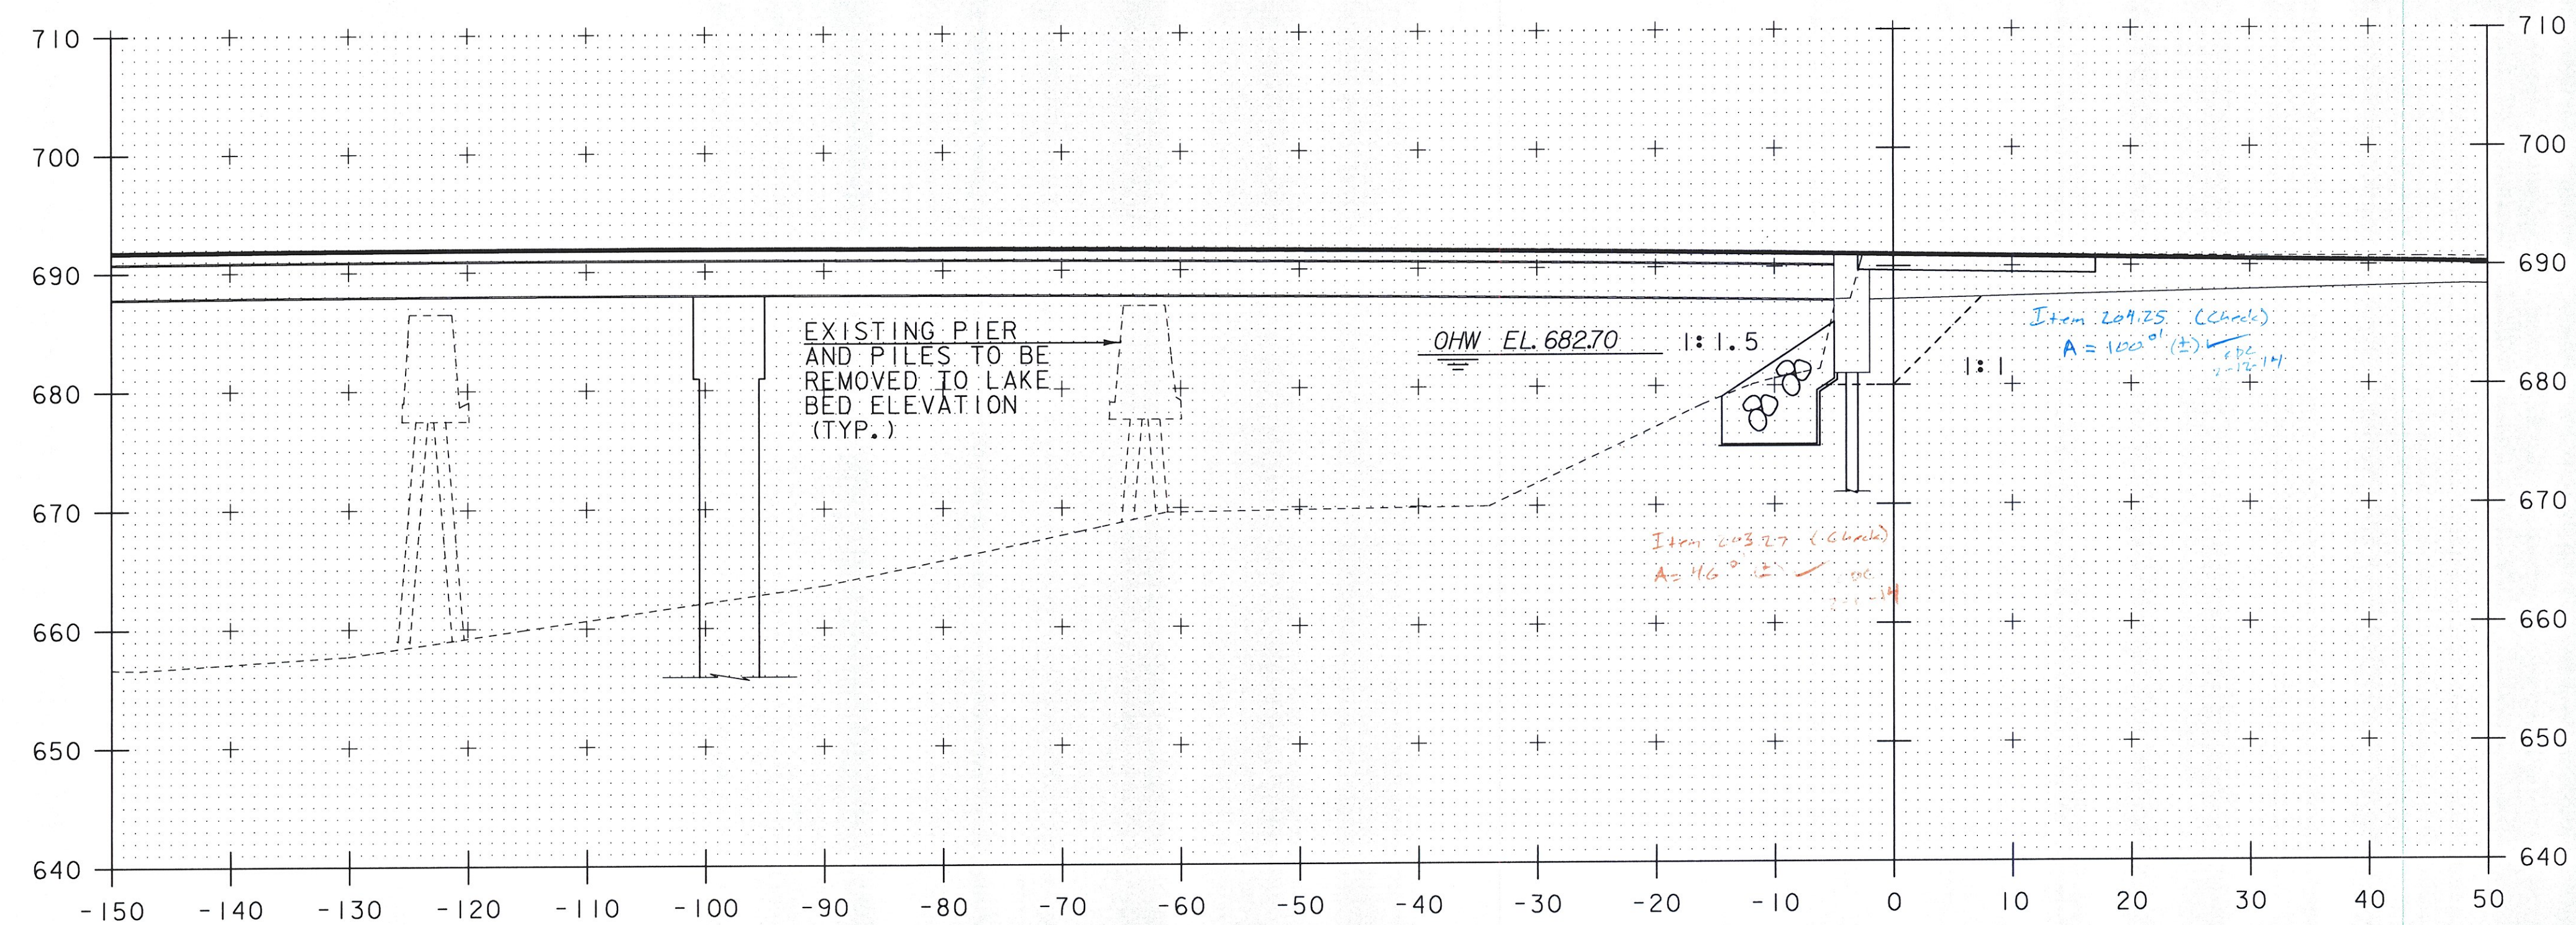

50+75

CHANNEL RT. STA. 50+75 TO STA. 50+80

PROJECT NAME:	NEWPORT CITY	PLOT DATE:	22-NOV-2011	
PROJECT NUMBER:	BRO 1449(25)	DRAWN BY:	C. MOONEY	
FILE NAME:	96J314/STR/96J314.dgn	DESIGNED BY:	D. PETERSON	
PROJECT LEADER:	C. CARLSON	ABUTMENT 2 CHANNEL SECTION 4	CHECKED BY:	C. CARLSON
			SHEET	64 OF 75