
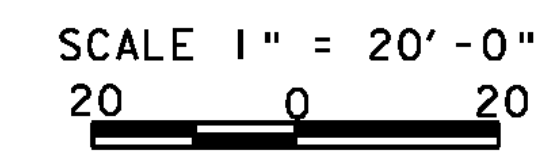


LEGEND	
	STABILIZED CONSTRUCTION ENTRANCE
	SILT FENCE, WOVEN WIRE REINFORCED
	BARRIER FENCE
	EROSION MATTING
	GEOTEXTILE FOR FILTER CURTAIN
	PROPOSED DEWATERING AREA
	INLET PROTECTION DEVICE
	ORDINARY HIGH WATER

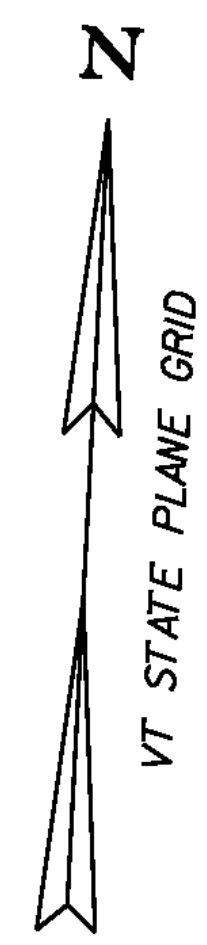

PROJECT NAME: NEWPORT CITY	PLOT DATE: 22-NOV-2011
PROJECT NUMBER: BRO 1449(25)	DRAWN BY: C. MOONEY
FILE NAME: 96j3i4\str\j3i4bdr.dgn	CHECKED BY: C. CARLSON
PROJECT LEADER: C. CARLSON	SHEET 70 OF 75
DESIGNED BY: D. PETERSON	
EPSC - PLAN 2	