


TOP VIEW (BOTTOM VIEW SIM.)

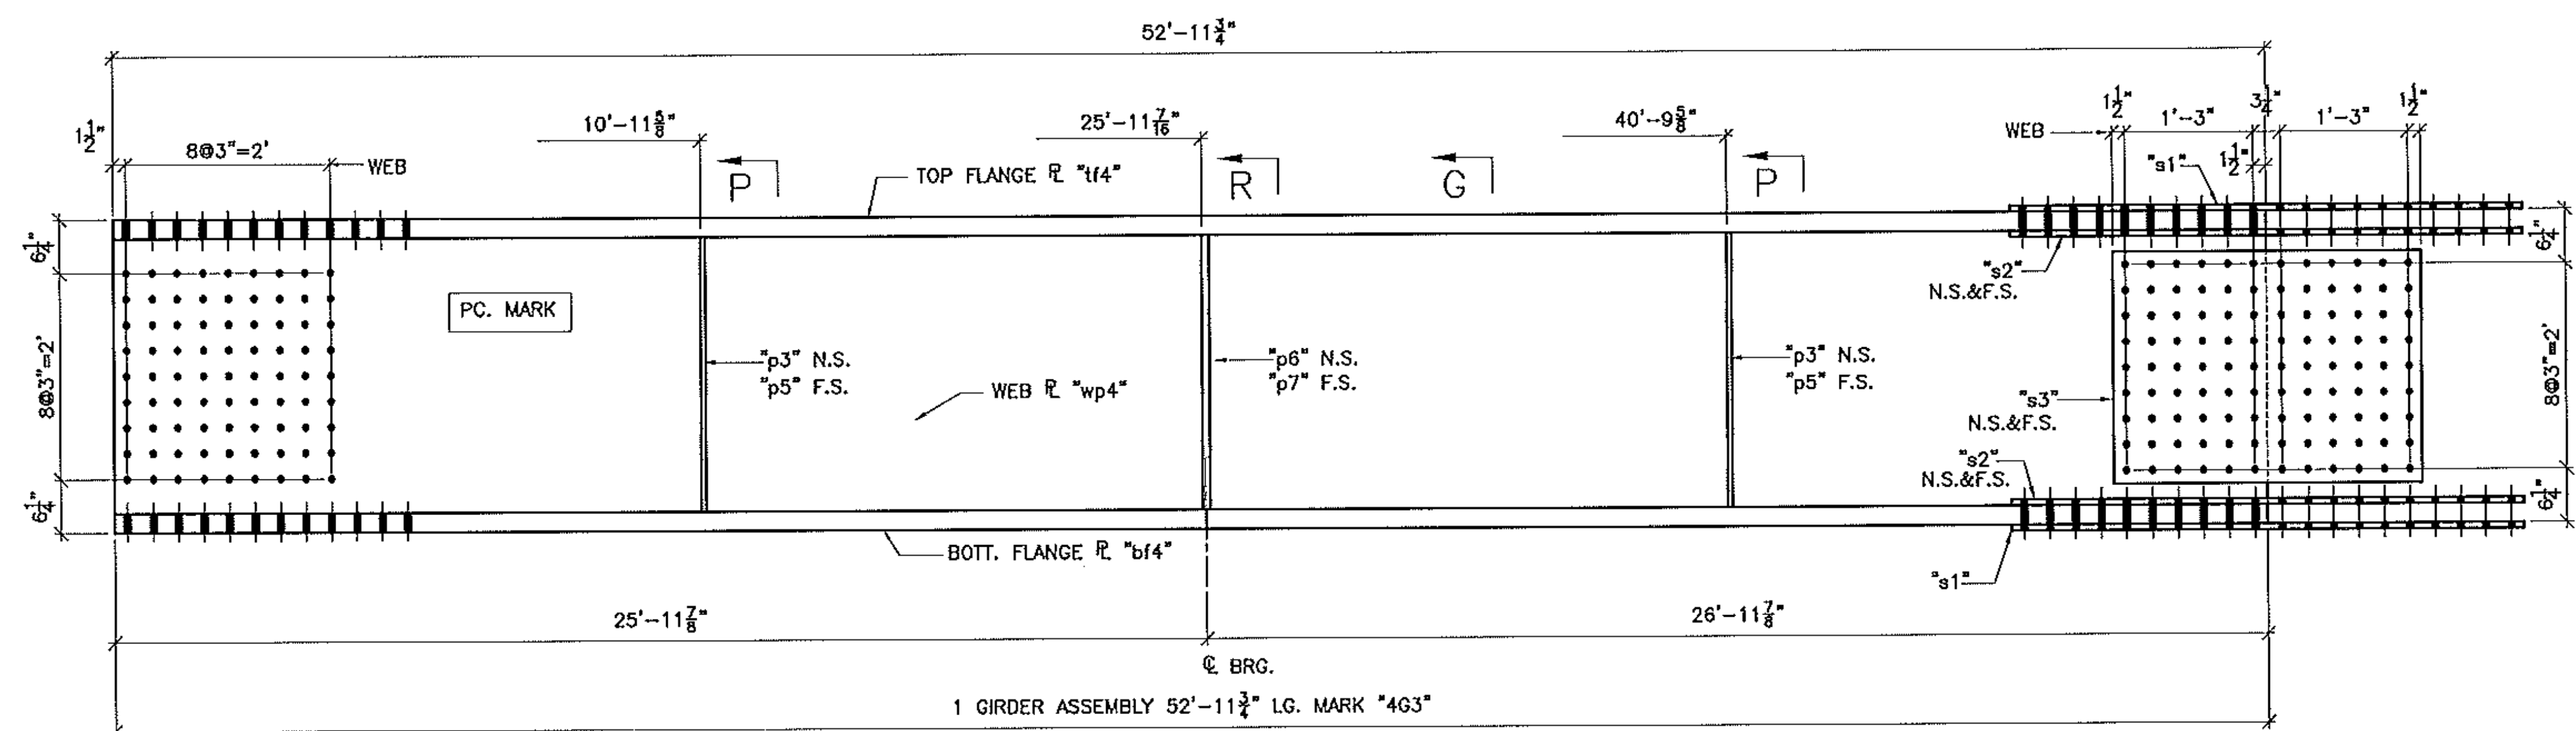

BILL OF MATERIAL							
SHIP	SHIP MARK	NO. PCS.	PIECE MARK	DESCRIPTION	LENGTH	REMARKS	WT.
1	463			BRIDGE GIRDER			
		1	wp4	R 1/4 X 32	52'-11 1/2"		2888
		1	bf4	R 2 1/2 X 18	52'-11 1/2"		7305
		1	bf4	R 2 1/2 X 18	52'-11 1/2"		7305
		1	p7	SEE SHT. 26			
		2	p5	SEE SHT. 26			
		1	p6	SEE SHT. 26			
		2	p3	SEE SHT. 26			
		2	s1	SEE SHT. 26			
		4	s2	SEE SHT. 26			
		2	s3	SEE SHT. 26			

GIRDER WT: 18,488

Vermont Agency of Transportation
RECEIVED

CK'D BY GFR OK'D BY
05/15/2012

RESUBMIT APPROVED X
BY C. CARLSON DATE 05/16/2012

SEE .dxf FILES FOR WEB R CUTTING
SEE SHEET 26 FOR PIECE DETAILS
SEE SHEET B1 FOR NOTES

FINISH			
MATERIAL	AASHTO M270 (ASTM A709) GRADE 50		
HOLES	15/16" U.O.J.		
ELECTRODES			
WELDS	PER WPS		
SURFACE PREP		5/15/12	PER APPROVAL
		NO DATE	JAC
REVISIONS			

	ADVANCED RESOURCES & CONST. ENTERPRISES, INCORPORATED P.O. BOX 120 KINGFIELD, ME. 04947 PHONE: (207) 265-2646 - FAX: (207) 265-4054		CONTRACT NO. BR0 1449 (25)
	DRAFTER JAC DATE 4/11/12 CHECKED JS JOB # 12-100	STRINGER DETAILS VERMONT AGENCY OF TRANSPORTATION, MEMPHIS CITY, CO. OF OREGON RAILROAD SQUARE, 1311 (CLASS 2) MAJOR COLLECTOR, BRIDGE NO. 8 D.C. REED & REED	

JAC DRAFTING/5/15/12/D16

PDF created with FinePrint pdfFactory trial version http://www.pdffactory.com