


LOOKING @ BOTTOM FLANGE

4G1

3rd HOLE DRILLED 1/4" TO RIGHT

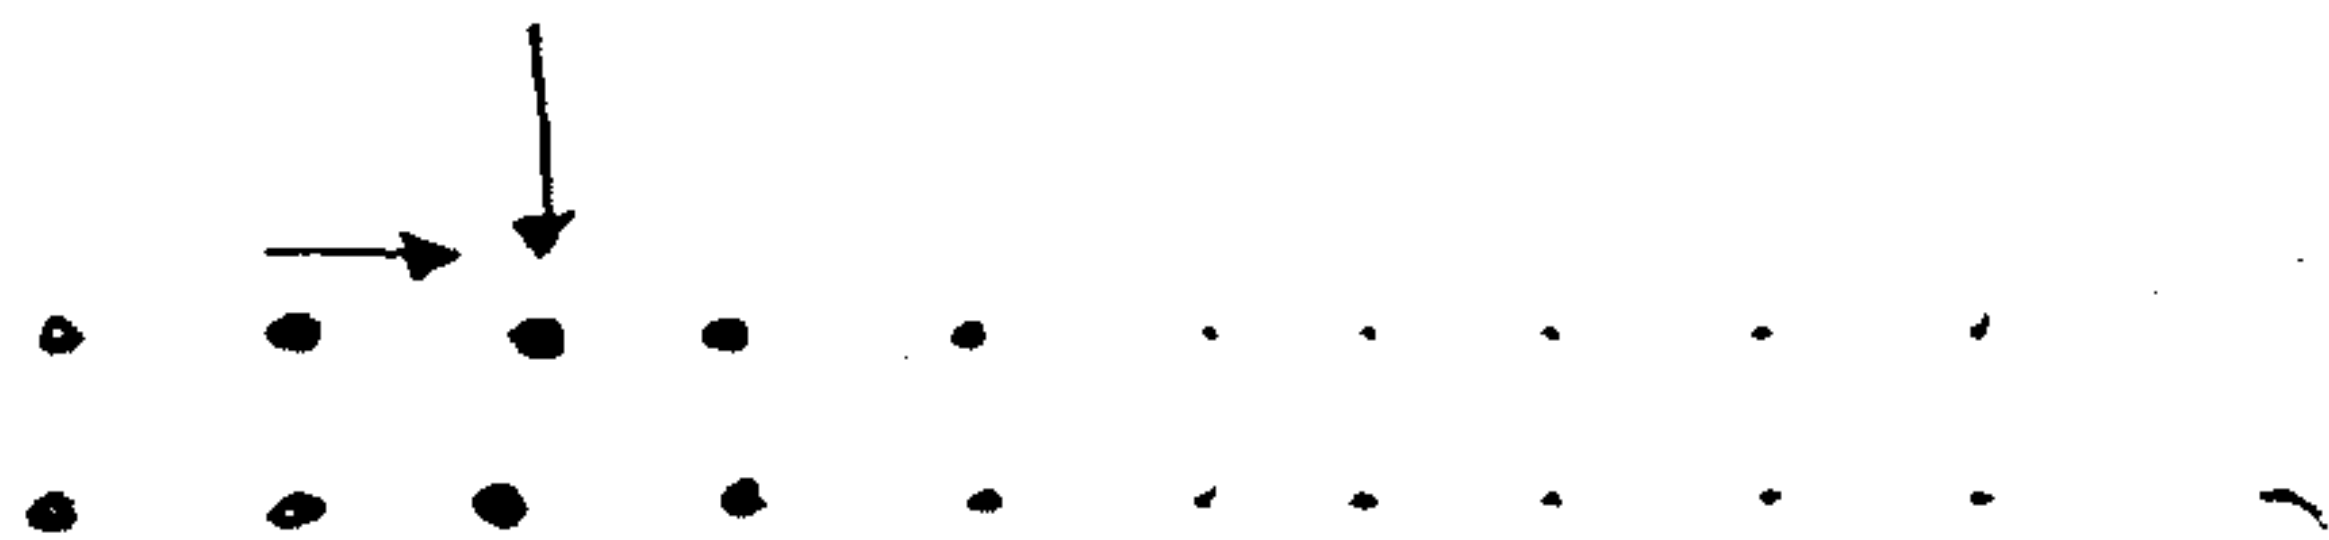

Dave-

Can you check to

be sure we are all set
with leaving this as is?

Similar situation as before, I suspect
that we are fine! ^{TP} Dave

R. let Jeff C. know