


MONUMENT AVENUE



# PROFILE SHEET # 1

## VERMONT AGENCY OF TRANSPORTATION

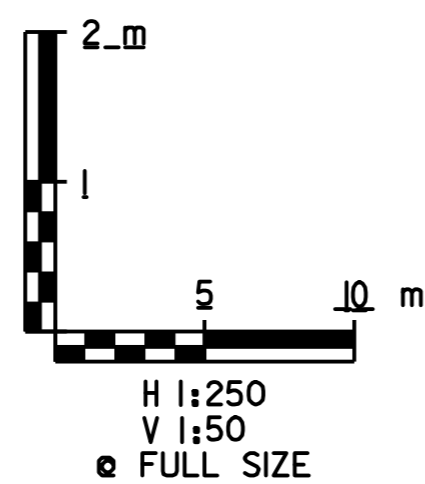

PROJECT NAME: OLD BENNINGTON  
 PROJECT NUMBER: STP 1400(5)  
 FILE NAME: /pave/97d228/p97d228.dgn  
 PROJECT LEADER: I.P.K.  
 DESIGNED BY: J.S.P.  
 PLOT DATE: 05-MAY-2008 14:  
 DRAWN BY: C.A.K.  
 CHECKED BY: D.E.G.  
 SHEET 14 OF 48