

646.41 DURABLE 100 mm YELLOW LINE (TYPE ITAPE)

STA. 1+003.0 - STA. 1+017.7 DOUBLE SOLID (CENTER LINE)
 STA. 1+047.3 - STA. 1+062.0 DOUBLE SOLID (CENTER LINE)
 STA. 2+014.3 - STA. 2+029.0 DOUBLE SOLID (CENTER LINE)

646.61 TEMPORARY 100 mm YELLOW LINE

STA. 1+003.0 - STA. 1+017.7 DOUBLE SOLID (CENTER LINE)
 STA. 1+047.3 - STA. 1+062.0 DOUBLE SOLID (CENTER LINE)
 STA. 2+014.3 - STA. 2+029.0 DOUBLE SOLID (CENTER LINE)

646.70 TEMPORARY LETTER OR SYMBOL

STA. 1+015.0 RT (S,T,O,P)
 STA. 1+050.0 LT (S,T,O,P)
 STA. 2+017.0 LT (S,T,O,P)

675.50 REMOVING SIGNS

AS SHOWN - 97

675.60 ERECTING SALVAGED SIGNS

AS SHOWN - I (SOUTHERN VERMONT COLLEGE)
 REFER TO BOOK IA PAGE 60

646.46 DURABLE 600 mm STOP BAR (TYPE ITAPE)


STA. 1+018.0 RT
 STA. 1+047.0 LT
 STA. 2+014.0 LT

646.66 TEMPORARY 600 mm STOP BAR

STA. 1+018.0 RT
 STA. 1+047.0 LT
 STA. 2+014.0 LT


646.50 DURABLE LETTER OR SYMBOL (TYPE ITAPE)

STA. 1+015.0 RT (S,T,O,P)
 STA. 1+050.0 LT (S,T,O,P)
 STA. 2+017.0 LT (S,T,O,P)

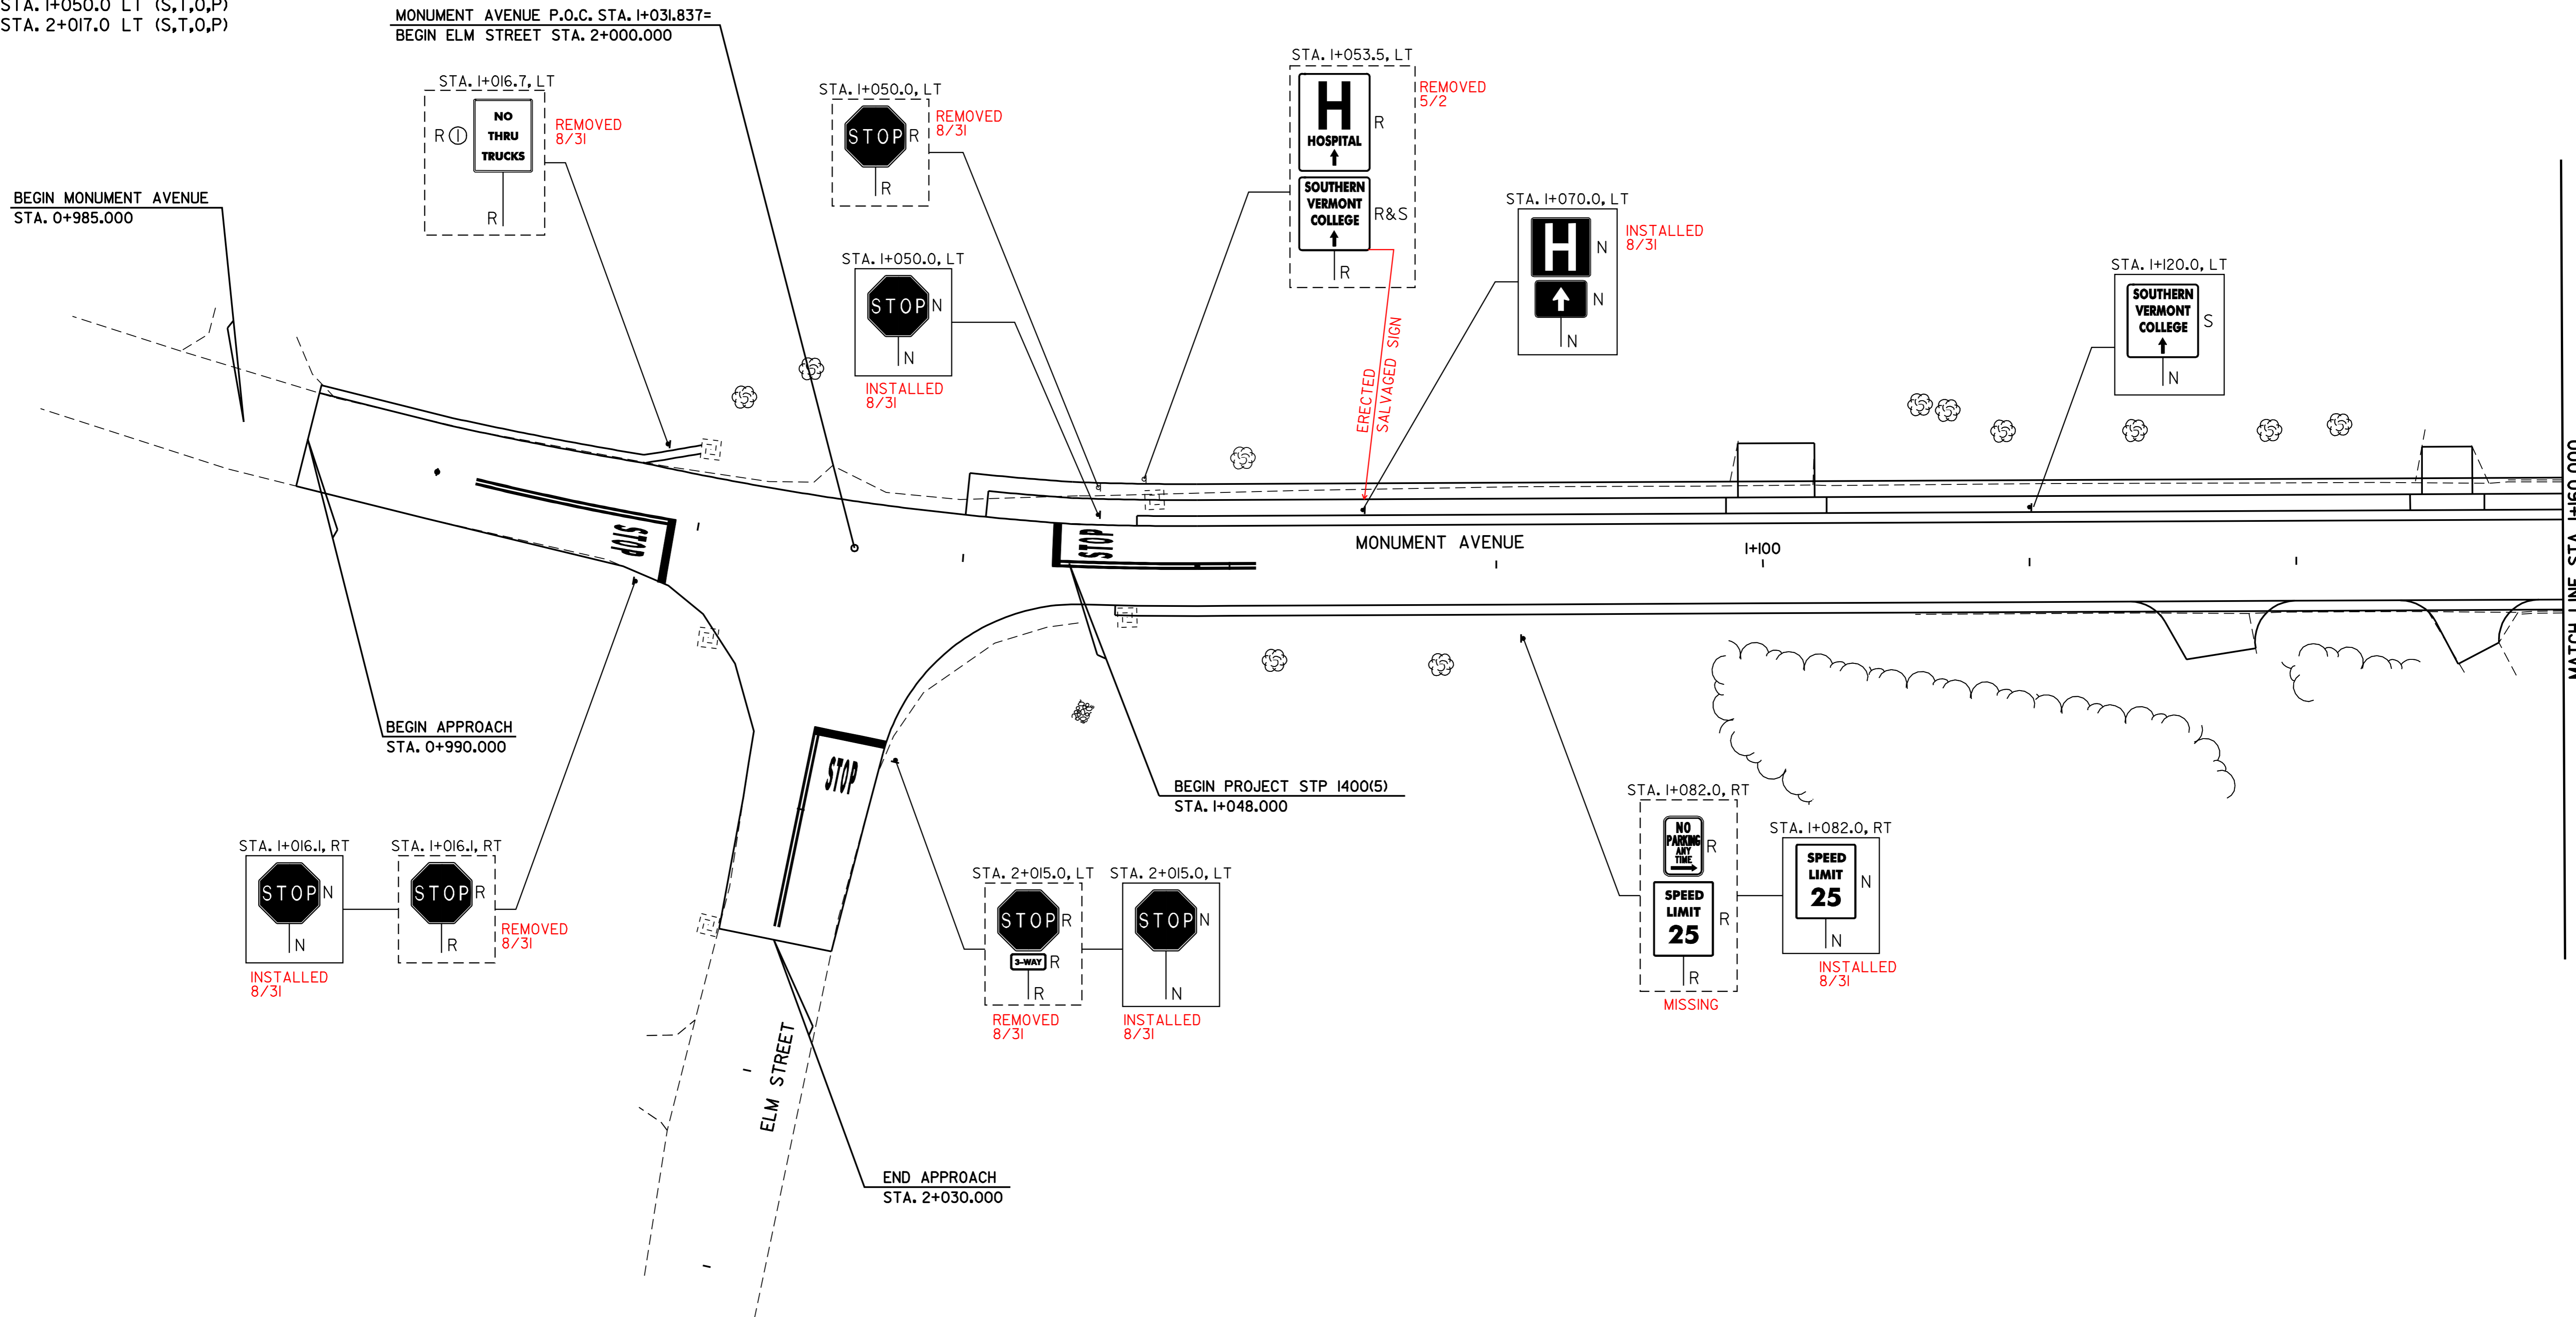

DATUM	
VERTICAL	N/A
HORIZONTAL	NAD 83 (1996)

SIGN LEGEND
 R= REMOVE
 S= SALVAGE
 N= NEW
 RET= RETAIN
 B-B= BACK TO BACK
 EXISTING=
 NEW=
 ⊙ = RETURN TO VILLAGE OF OLD BENNINGTON

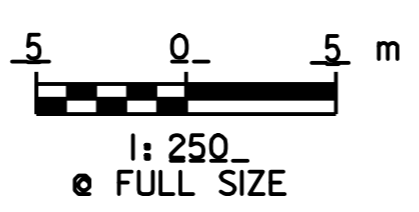

SIGNING, STRIPING, AND PLAN SHEET #1

VERMONT AGENCY OF TRANSPORTATION

<p>CLOUGH, HARBOUR & ASSOCIATES <small>ENGINEERS, SURVEYORS, PLANNERS & LANDSCAPE ARCHITECTS</small> <small>MEMBERS: CIRCLE ALBANY, NEW YORK, 02208</small></p>	PROJECT NAME: <u>OLD BENNINGTON</u> PROJECT NUMBER: <u>STP 1400(5)</u>	PLOT DATE: 05-MAY-2008 14:
	FILE NAME: /pave/97d228/p97d228.dgn	DRAWN BY: <u>C.A.K.</u>
	PROJECT LEADER: <u>I.P.K.</u> DESIGNED BY: <u>J.S.P.</u>	CHECKED BY: <u>D.E.G.</u>
	p97d228ssp1.i	SHEET <u>21</u> OF 48