




BEGIN APPROACH  
STA. 0+990.000

BEGIN MONUMENT AVENUE  
STA. 0+985.000

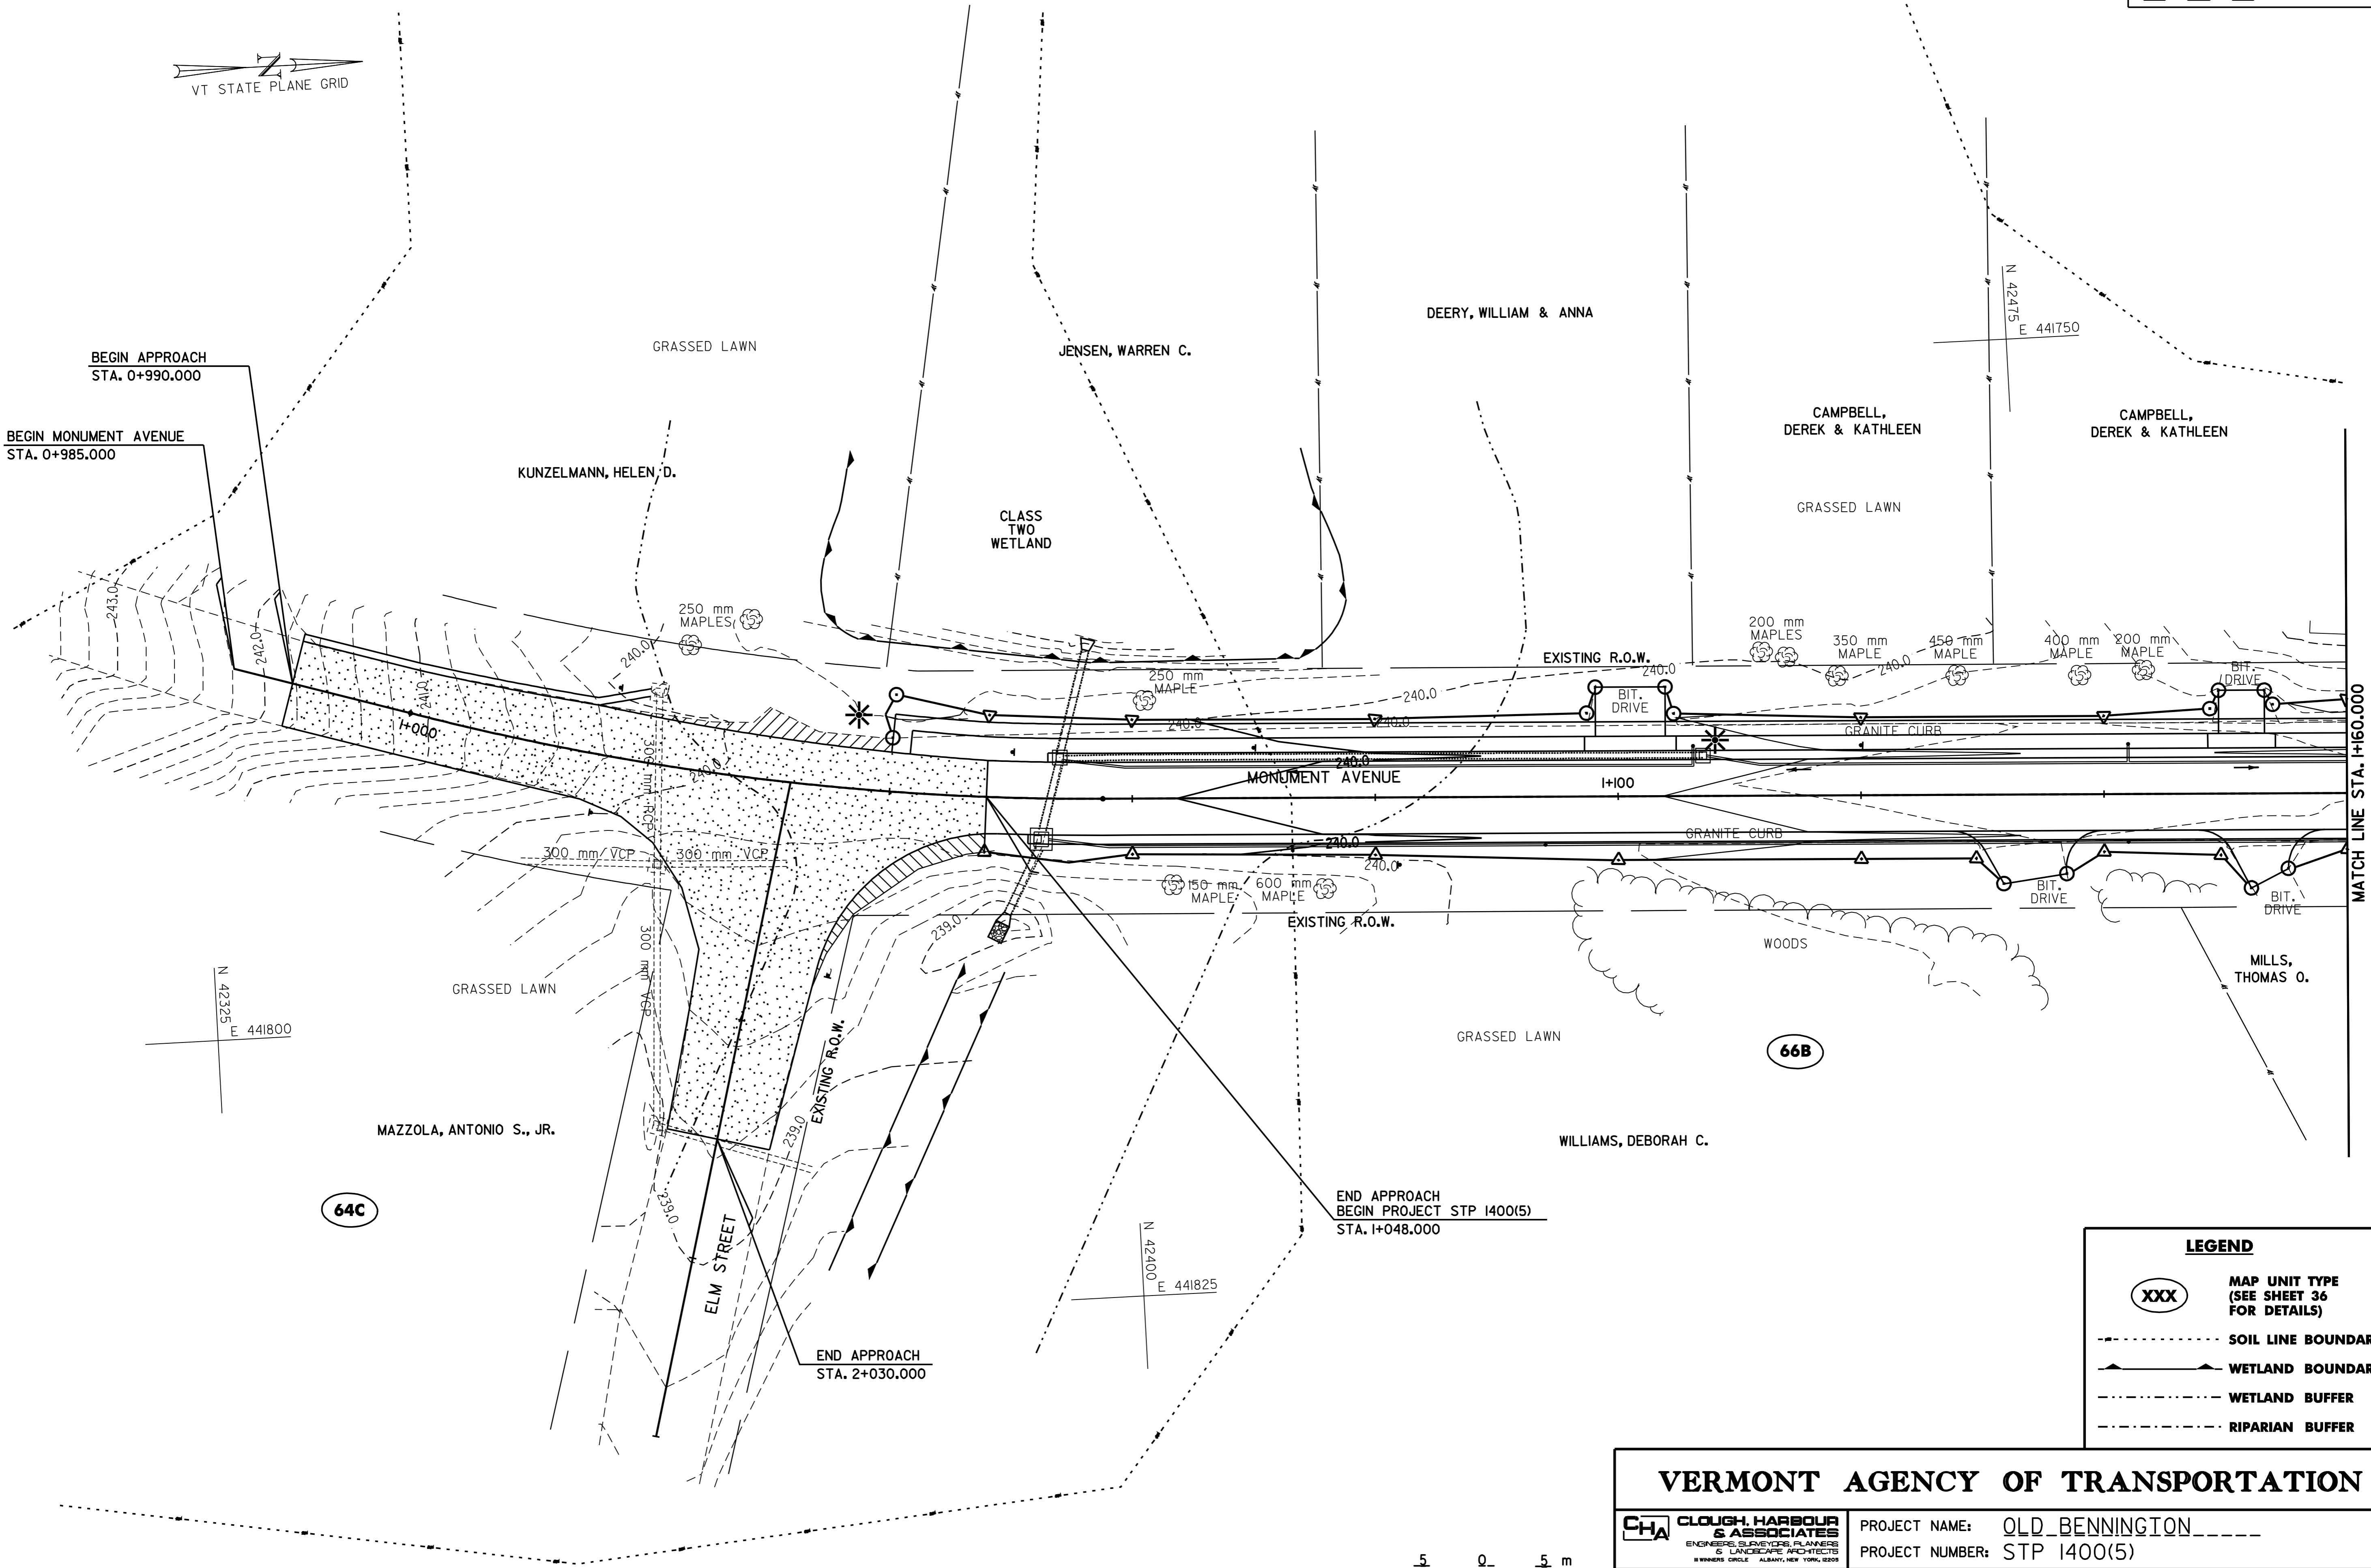

MATCH LINE STA. 1+160.000

64C

66B

END APPROACH  
BEGIN PROJECT STP 1400(5)  
STA. 1+048.000

END APPROACH  
STA. 2+030.000

LEGEND	
	MAP UNIT TYPE (SEE SHEET 36 FOR DETAILS)
	SOIL LINE BOUNDARY
	WETLAND BOUNDARY
	WETLAND BUFFER
	RIPARIAN BUFFER

**VERMONT AGENCY OF TRANSPORTATION**

**CHA** CLOUGH, HARBOUR & ASSOCIATES  
ENGINEERS, SURVEYORS, PLANNERS & LANDSCAPE ARCHITECTS  
110 BROADWAY, ALBANY, NEW YORK, 12204

PROJECT NAME: OLD BENNINGTON  
PROJECT NUMBER: STP 1400(5)

**FINAL CONDITION  
PLAN # 01**

FILE NAME: /pave/97d228/p97d228.dgn PLOT DATE: 05-MAY-2008 14:  
PROJECT LEADER: I.E.K. DRAWN BY: K.A.B.  
DESIGNED BY: J.S.P. CHECKED BY: D.E.G.  
p97d228fcp01.i SHEET 46 OF 48

