

BENT BARS, TIES, & STIRRUPS																		
ITEM	MARK	QTY.	SIZE	LENGTH	TYPE	A	B	C	D	E	F	G	H	J	K	O	GRADE	REMARKS
1	401	276	4	5'-3 1/8"	L4	14"	7"	7 7/8"	1'-5 1/8"	7 7/8"	7"	14"	4 1/2"		6 1/2"		60	EPOXY COATED
2	402	276	4	12'-5 3/4"	T2	6"	3'-3 1/8"	1'-6 1/4"	3'-3 1/8"	1'-6 1/4"							60	EPOXY COATED
3	403	168	4	4'-2 1/2"	S10		1'-6"	1'-4 1/2"	1'-6"								60	EPOXY COATED
4	404	T2	4	3'-3 1/8"	STR												60	EPOXY COATED
5																		
6																		
3'-7 1/2" (circled)






1'-4 1/2" (circled)

3'-7 1/2" (circled)

3'-7 1/2" (circled)

Check rebar marks (circled)

MISCELLANEOUS MATERIAL				
ITEM	MARK	QTY.	DESCRIPTION	REMARKS
1	EM-2	6	2 3/4" x 5" x 5" W/ 2" HOLE (GALV.)	FOR TRANS. TENSIONING (SEE DETAIL THIS SHEET)
2		3	1/2" POLYSTRAND x 30'-0" 20k	FOR TRANS. TENSIONING
3		6	SINGLE USE STRESSING CHUCK	FOR TRANS. TENSIONING
4				
5		24	DOUBLE 1/2" STRAND LIFT LOOPS	
6				
7		12	Ø8 x 2 1/2" ANCHOR DOWEL	
8				
9		T2	NON-FERROUS VOID DRAIN	
10		24	1" THICK x 10" x 16" ELASTOMERIC BRG. PAD (60D)	SEE DETAIL THIS SHEET
11				
12				
13				
14				
15		12	10" Ø x 21'-1 1/4" VOID	
16		24	12" Ø x 21'-1 1/4" VOID	
17				
18				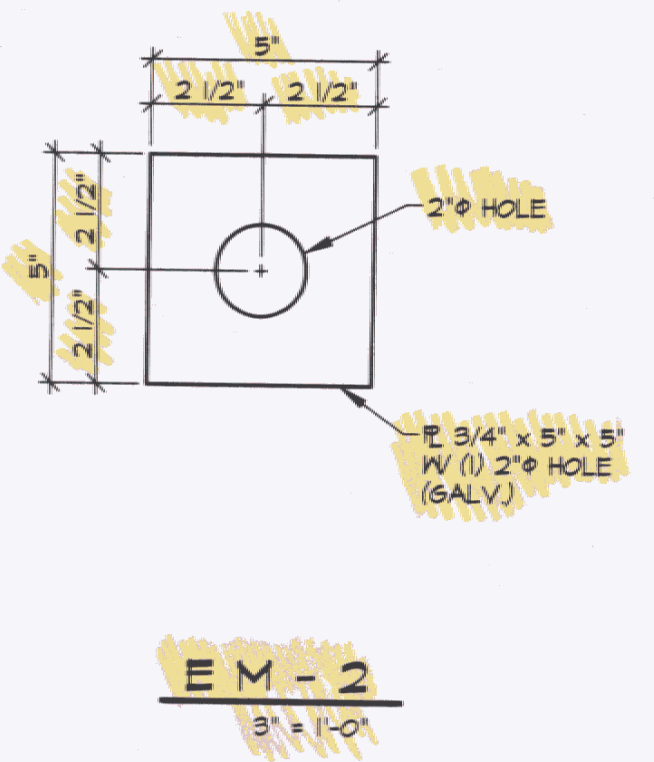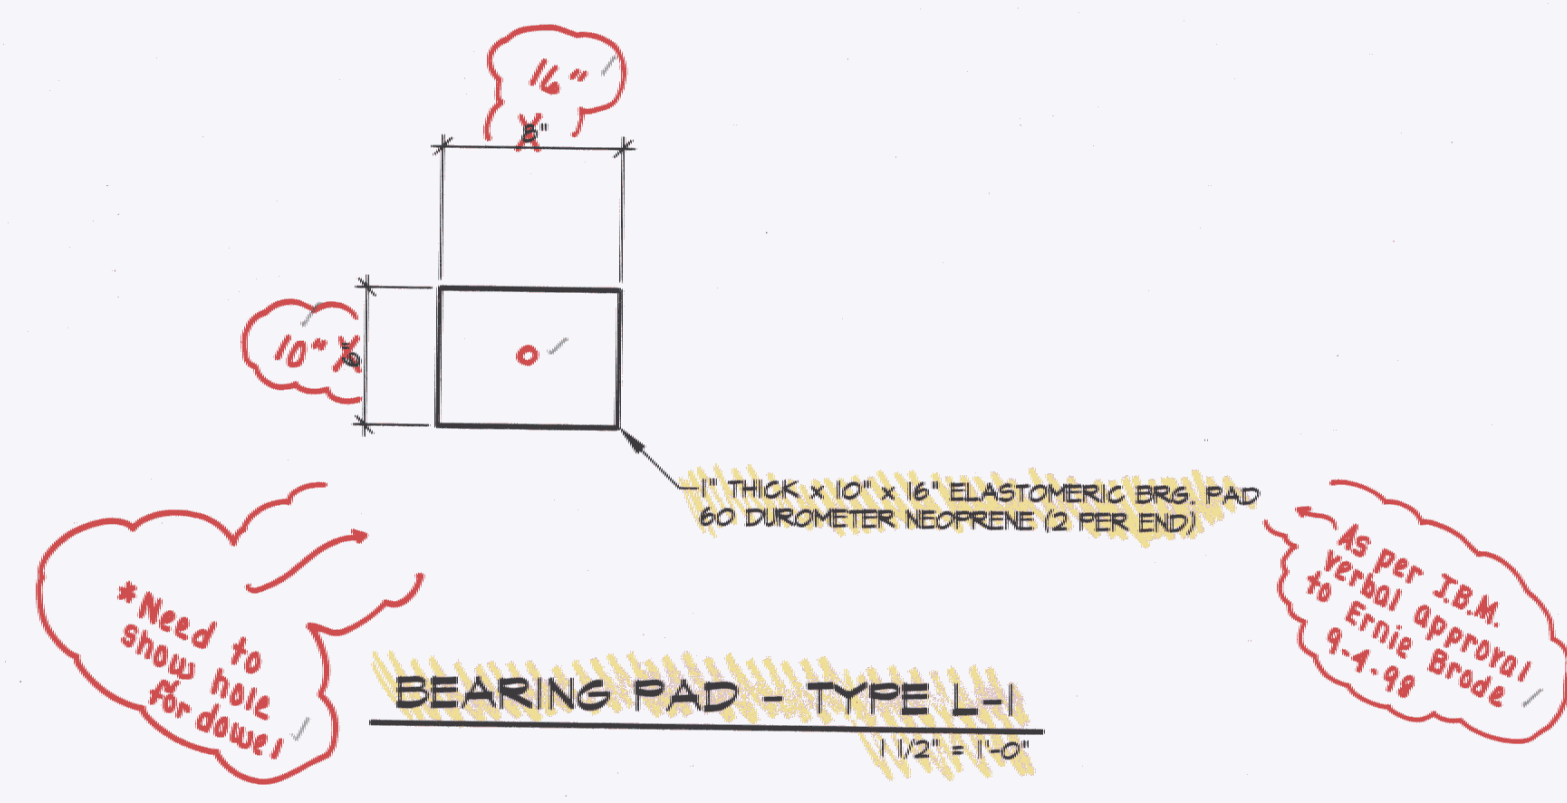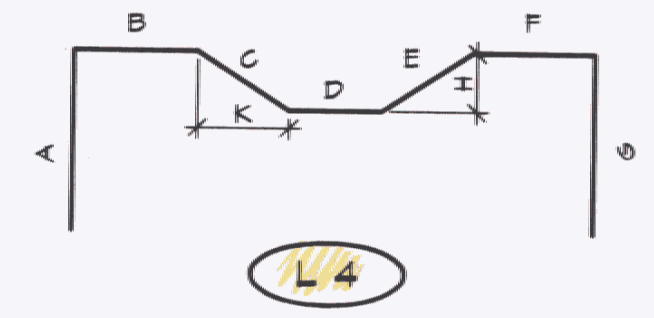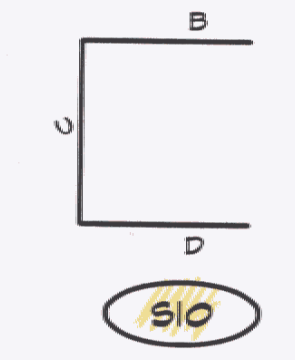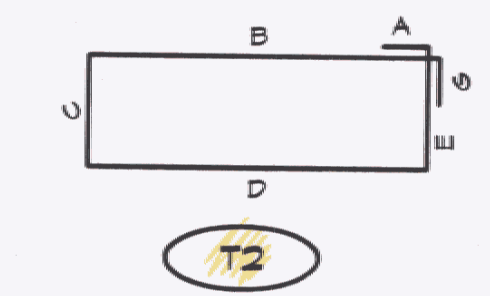
**RECEIVED**  
SEP - 9 1998  
LAWES  
CONSULTING ENGINEERS, INC.

NO EXCEPTION TAKEN  
FURNISH AS CORRECTED  
REVISE AND RESUBMIT  
REJECT:

Checking is only for conformance with the design and compliance with the requirements of the Contract Documents. Contractor is responsible for confirming and certifying all quantities and dimensions; selecting fabrication processes and techniques of construction; coordinating his work with that of all other trades; and performing his work in a safe and satisfactory manner.

LAWES CONSULTING ENGINEERS, INC.  
Date: \_\_\_\_\_ By: \_\_\_\_\_

RECEIVED  
CK'D BY PMT OK'D BY SLM  
SEP 16 1998  
RESUBMIT \_\_\_\_\_ APPROVED AS NOTED  
BY JBM/PMT DATE 9-18-98

NO.	DATE	REVISION	STATE OF VERMONT AGENCY OF TRANSPORTATION	DRAWN: <u>S. PETROSYAN</u> DESIGNED: _____ CHECKED: _____ APPROVED: _____	J.P. CARRARA & SONS INC. Precast & Prestress Manufacturer RTE. 116, MIDDLEBURY, VERMONT 05753 Phone: (802) 388-6361 Fax: (802) 388-9010	Contractor Name: <u>WINTERSSET, INC.</u> BOX 968 LYNDONVILLE, VT 05851	Project Name: <u>TOWN OF LOWELL</u> ROUTE TH2, BRIDGE # 9 TOWN OF LOWELL, VT	SCALE:	JOB #:
								NOTED	23065-98
MATERIAL LIST								DATE:	SHEET #:
								8-9-98	M 1