



**CENTERLINE PROFILE**

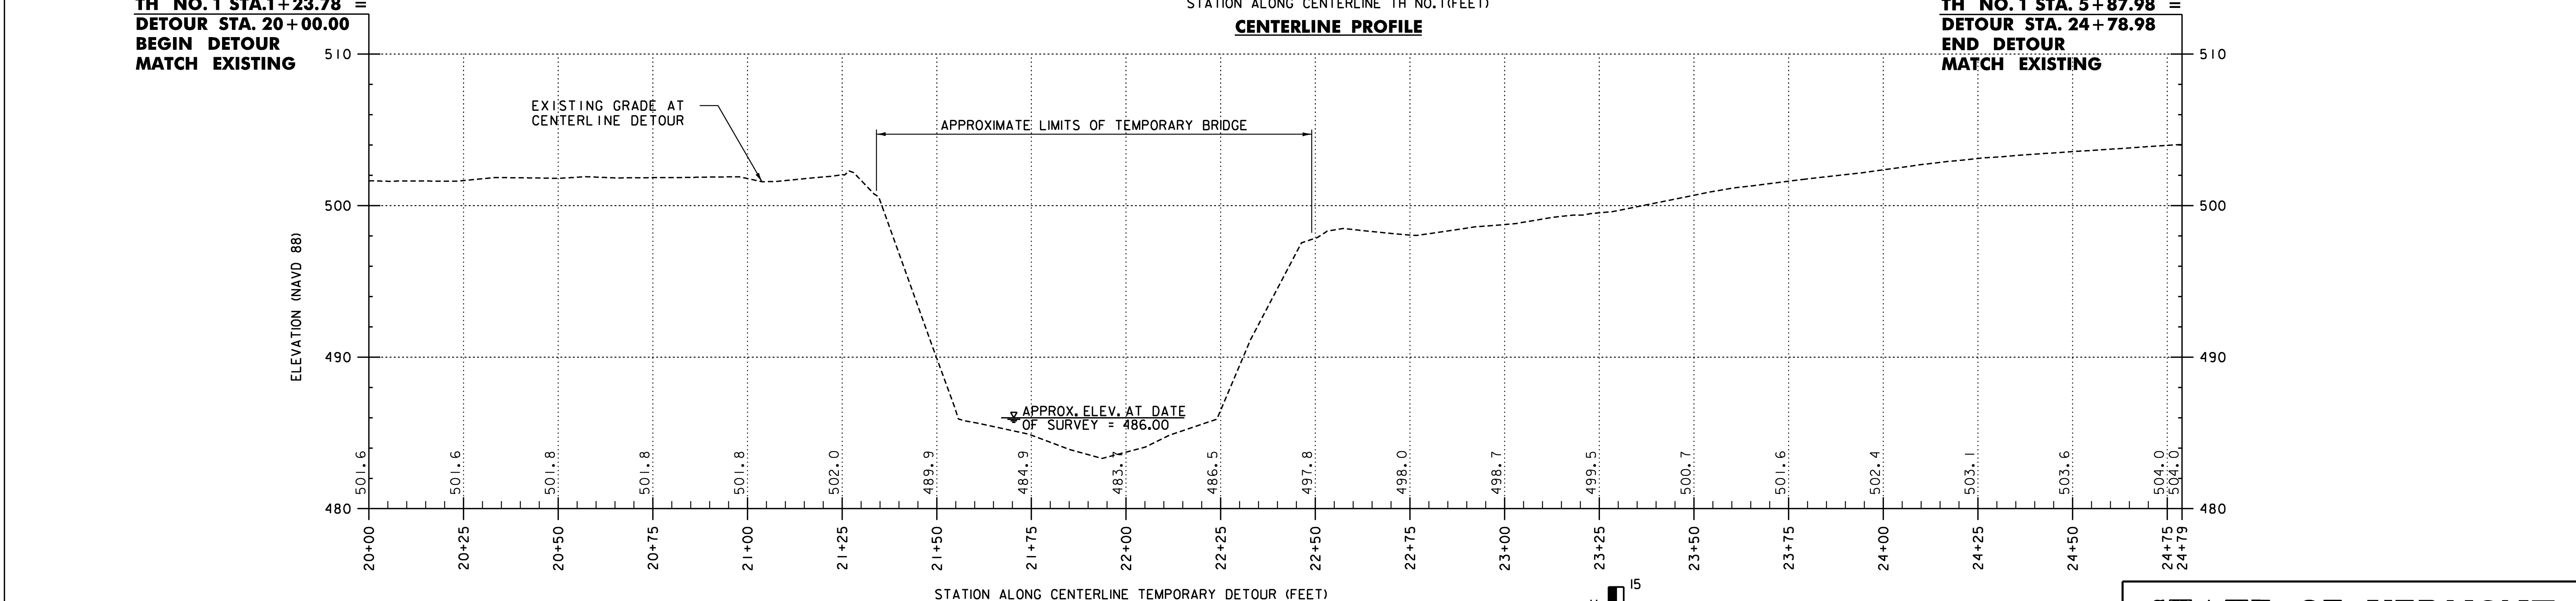

**TEMPORARY DETOUR PROFILE**

NOTE: GRADES SHOWN TO THE NEAREST TENTH REPRESENT EXISTING GROUND ELEVATION ALONG THE PROPOSED CENTERLINE.  
GRADES SHOWN TO THE NEAREST HUNDREDTH REPRESENT FINISHED GRADE ELEVATION ALONG THE PROPOSED CENTERLINE.

<b>DATUM</b>	
VERTICAL	NAVD 88
HORIZONTAL	ASSUMED

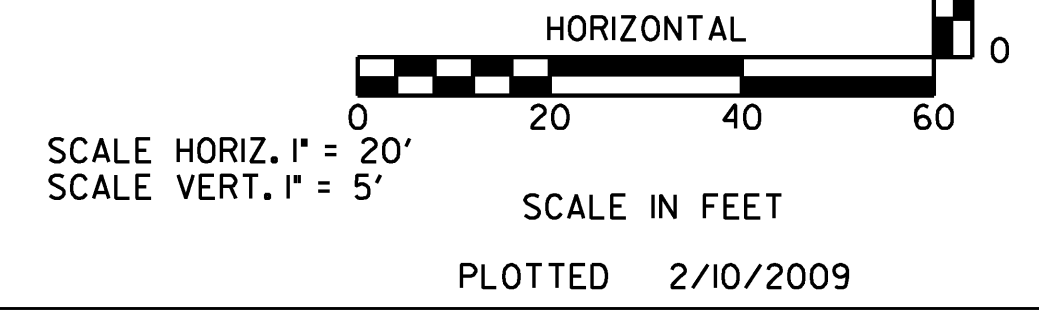

**DuBois & King**  
 engineering planning management development

<b>STATE OF VERMONT AGENCY OF TRANSPORTATION</b>			
Town Of	JOHNSON	Bridge No.	5
Highway No.	1	Log Sta.	
		Surv. Sta.	
<b>TH NO. 1 OVER THE GIHON RIVER</b>			
<b>PROFILE</b>			
Designed By	A.P. GUYETTE	Drawn By	A.P. GUYETTE
Checked By	Date	Bridge Design Supervisor	J. W. TUCKER Date 2/09
PROJECT	JOHNSON	PROJECT NO.	BHO 1448 (29)
I.G.C. Info.	z98J372xs.dgn	D & K DWG NO.	
Bridge Sheet No.		Sheet	13 of 68