


DATUM
 VERTICAL NAVD 88
 HORIZONTAL ASSUMED

SCALE 1" = 10'-0"
 10 0 10
 PLOTTED 2/10/2009

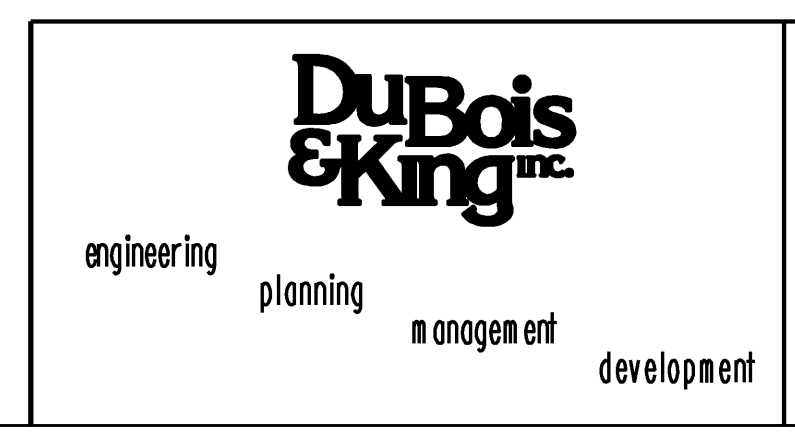

STATE OF VERMONT AGENCY OF TRANSPORTATION			
Town Of	JOHNSON	Bridge No.	5
Highway No.	1	Log Sta.	
		Surv. Sta.	
TH NO. 1 OVER THE GIHON RIVER			
CHANNEL CROSS SECTIONS (6)			
Designed By	A.P. GUYETTE	Drawn By	A.P. GUYETTE
Checked By	Date	Bridge Design Supervisor	
J. W. TUCKER	2/09	J. W. TUCKER	Date 2/09
PROJECT	JOHNSON	PROJECT NO.	BHO 1448 (29)
I.G.C. Info.	z98J372xs.dgn	D & K DWG NO.	
Bridge Sheet No.		Sheet	59 of 68