


WEB CUTTING DIAGRAM FOR 13G2A

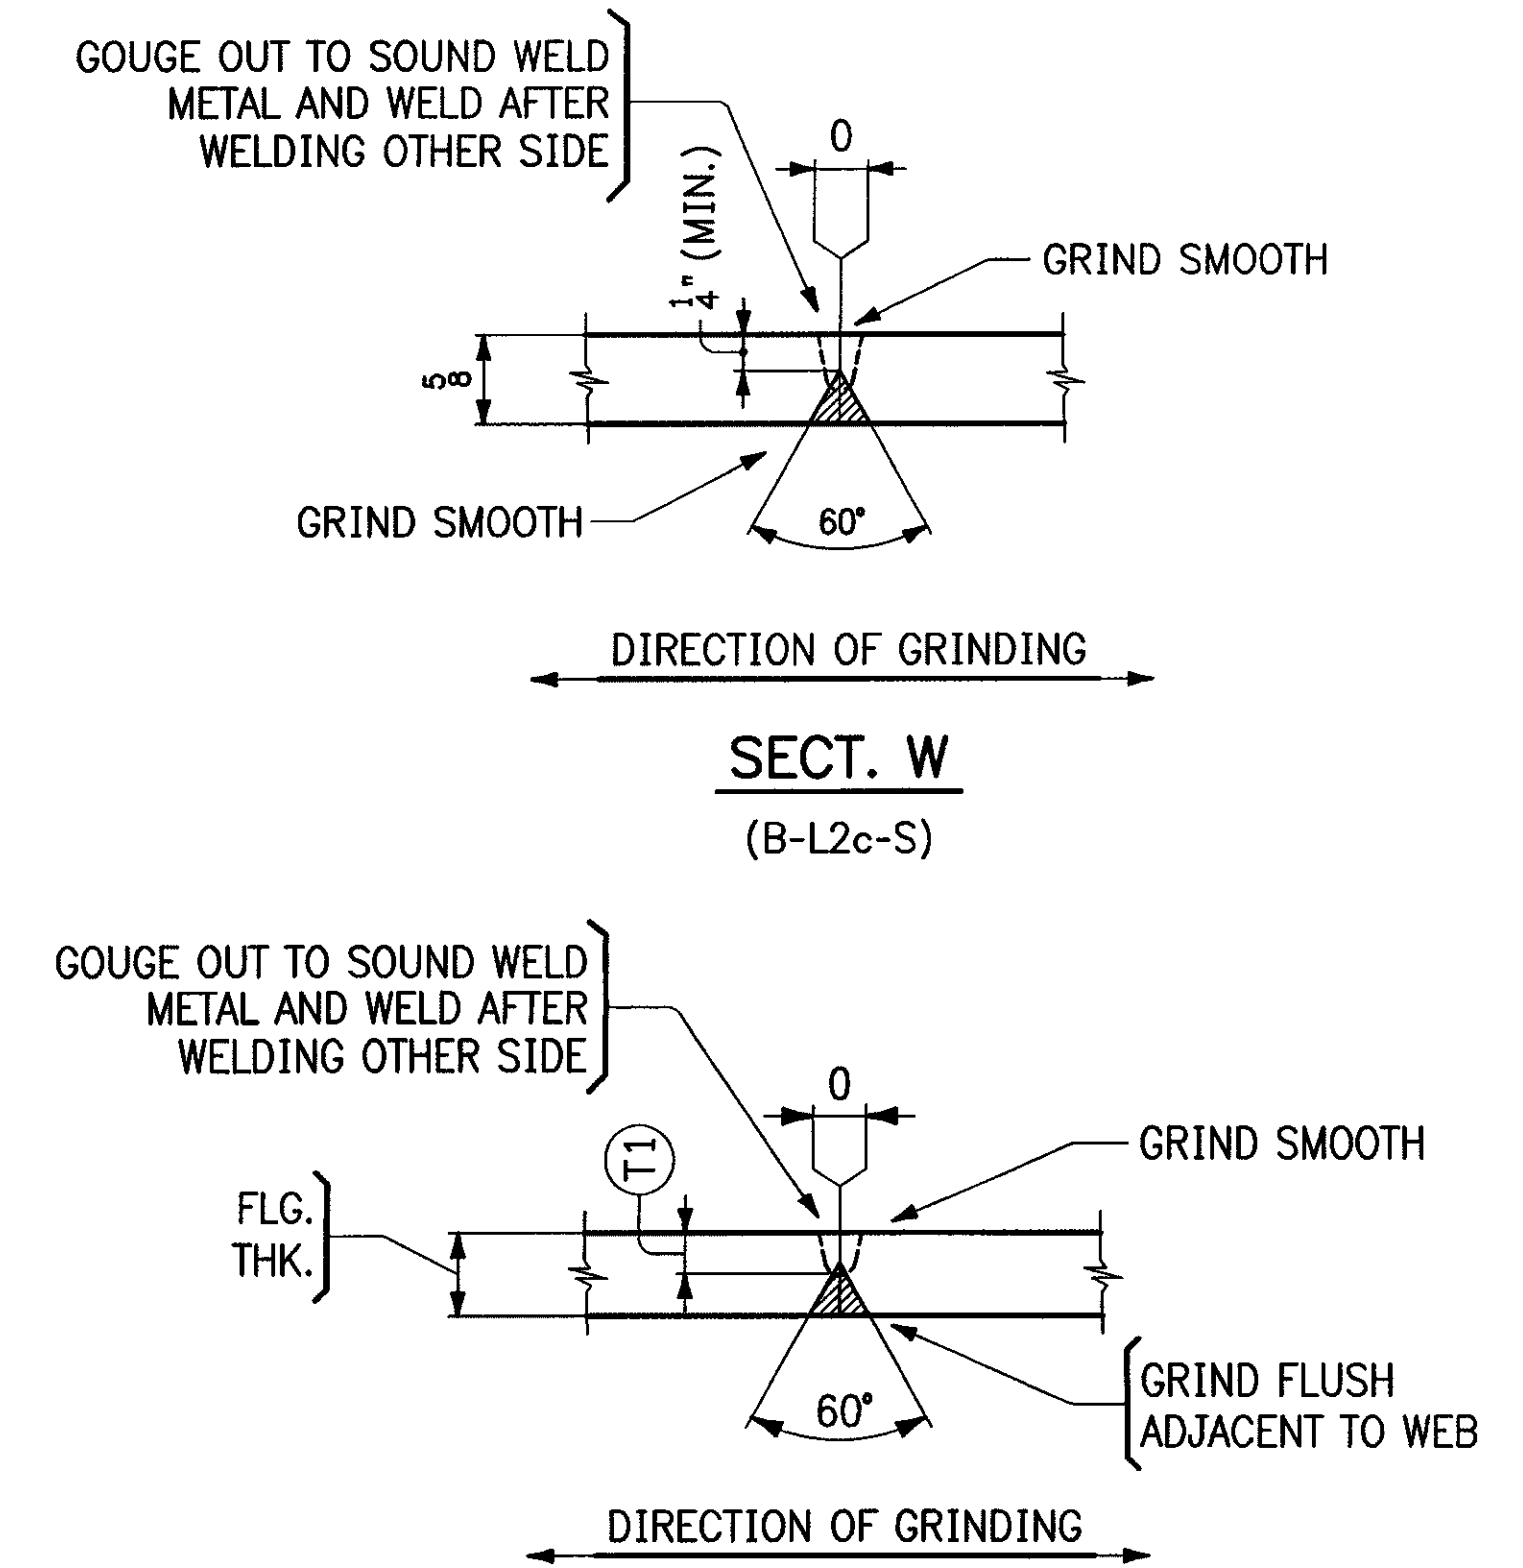


TYPICAL FLANGE PLATE SPLICE (B-L2c-S)

FLG. THK.	(T1)
1"	5/16
1 1/2"	1/2

NOTES:

- FOR GENERAL NOTES, SEE DWG. GN1.
- THE LETTER "t" AT FLANGE SPLICES INDICATES SPLICES IN TENSION.
- ALL MATERIAL SHALL BE M270-50W (CVN).
- ALL FLANGE SPLICES ARE TO BE RADIOGRAPHICALLY TESTED 100%.

RECEIVED
 JUL 23 2009
 APPROVED BY kmh DATE 7/21/09

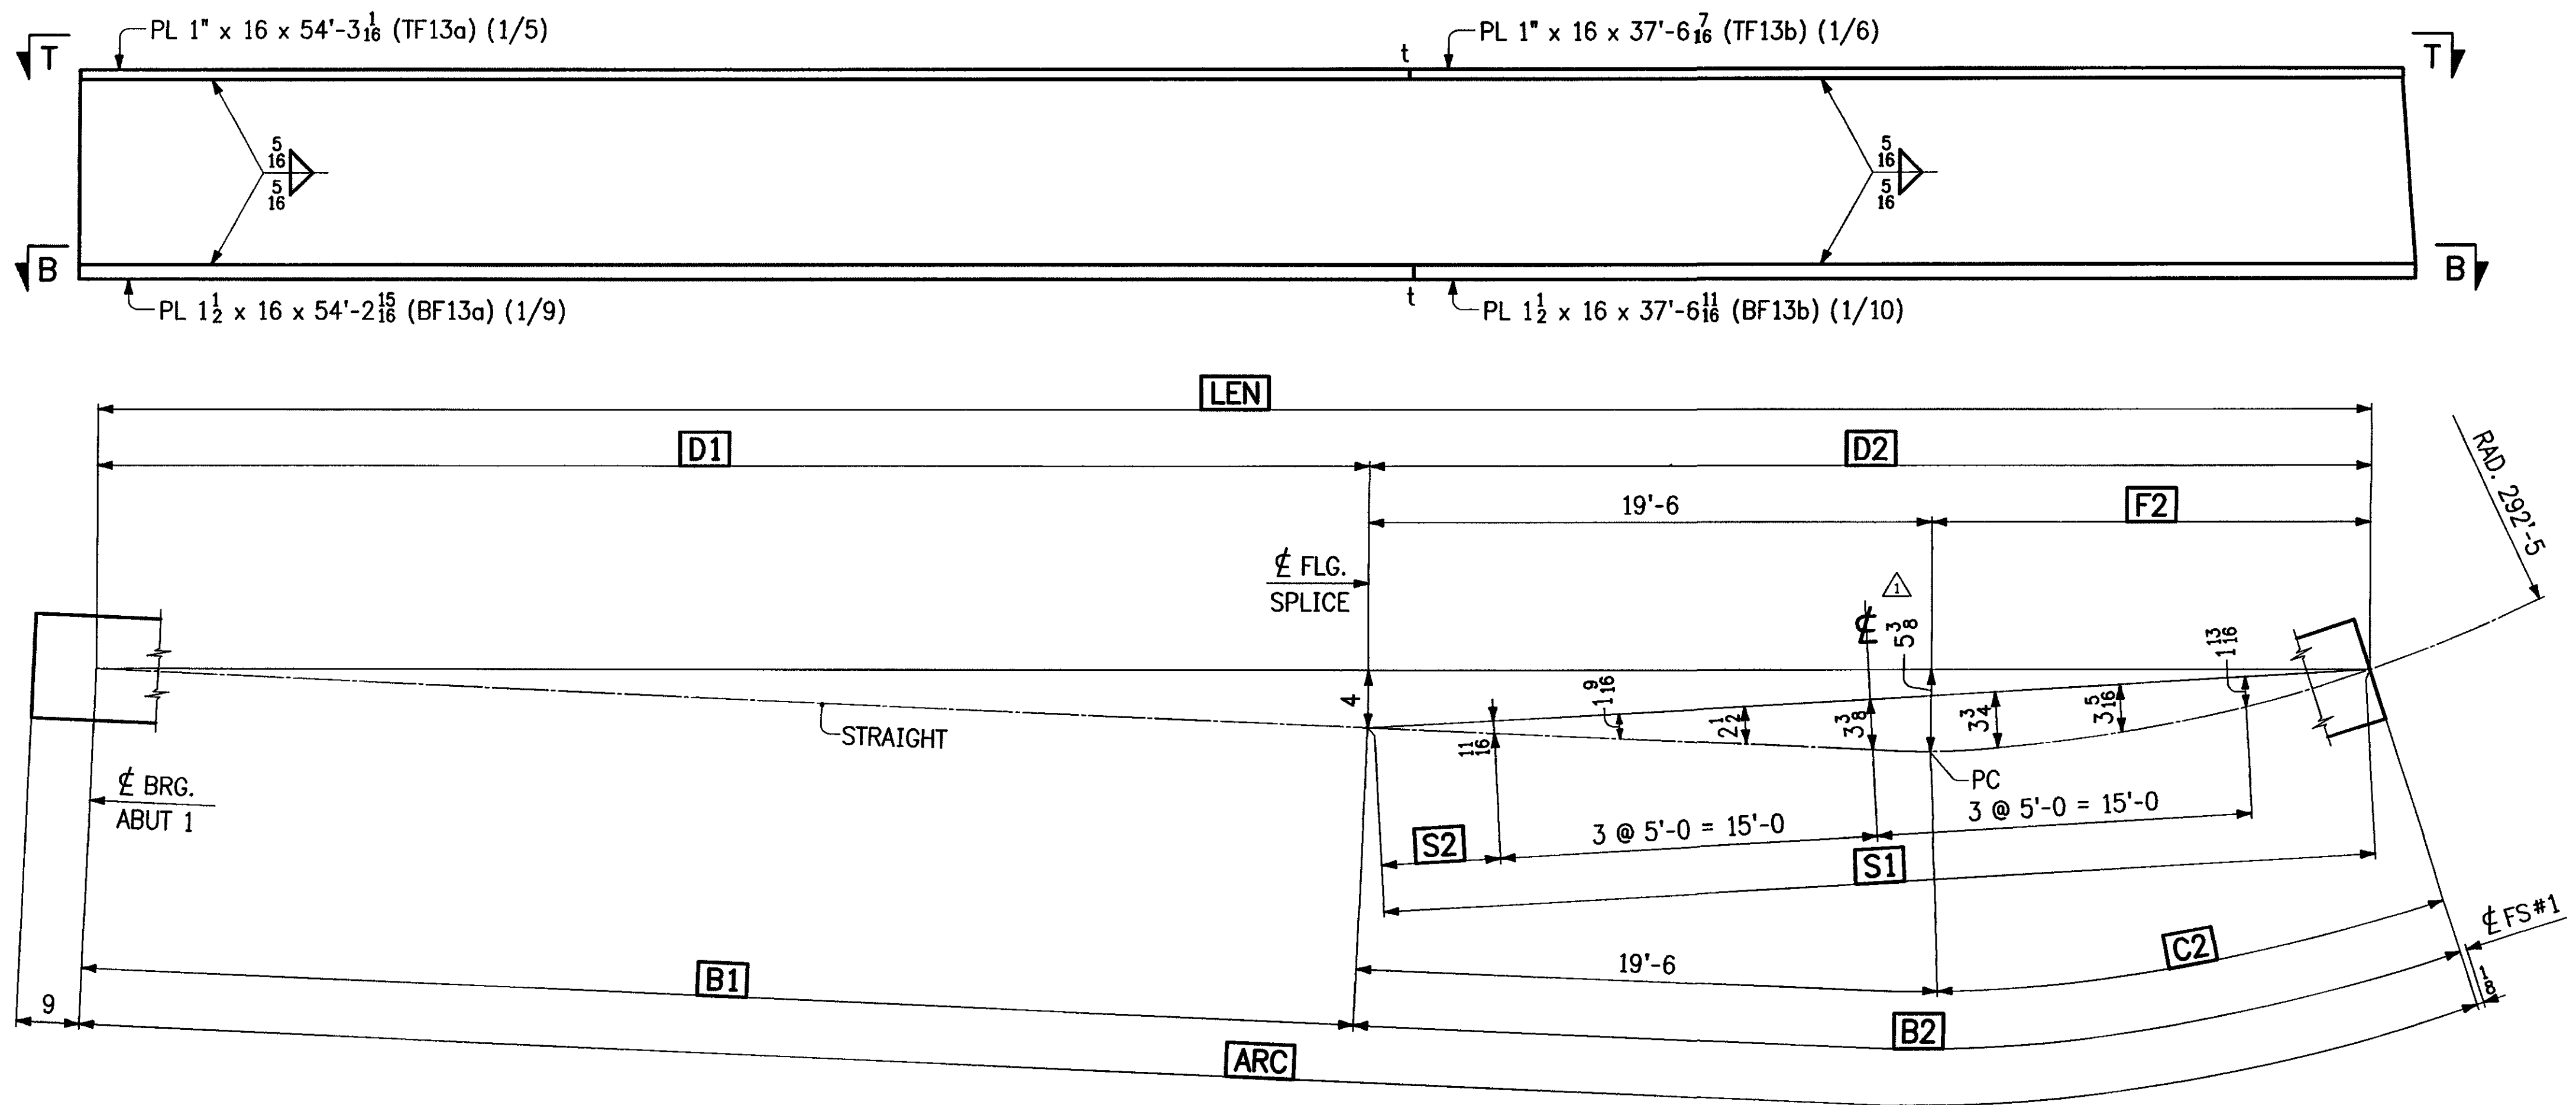

LOCATION	ARC	LEN	B1	B2	C2	D1	D2	F2	S1	S2
VIEW T-T	91'-0 1/2	91'-0 3/8	53'-6 1/16	37'-6 7/16	18'-0 7/16	53'-6	37'-6 3/8	18'-0 3/8	37'-6 3/8	3'-9 3/16
SECT. B-B	91'-0 5/8	91'-0 1/2	53'-5 15/16	37'-6 11/16	18'-0 11/16	53'-5 7/8	37'-6 5/8	18'-0 5/8	37'-6 9/16	3'-9 5/16

REVISIONS		PRINT RECORD			
NO	DATE	DESCRIPTION	DATE	QTY	ISSUED
			7-16	5P	APP.
7-14-09		REVISED HORIZONTAL CURVING DIAGRAM.			

MEGQUIER & JONES INC.

STRUCTURAL STEEL SINCE 1895		1156 BROADWAY		SOUTH PORTLAND, MAINE 04106	
PAIN	HOLES U N	WELD U N	Q C REVIEW		
PROJECT			DATE		
TH NO.1 OVER THE GIHON RIVER			6-4-09		
PROJECT NO. BHO 1448 (29) BRIDGE NO. 5			DRAWN BY		
TOWN OF JOHNSON, VERMONT			RLK 5-22-09		
DESCRIPTION			CHK'D BY		
CAMBER DIAGRAMS			GDC		
ARCH	N/A	ENGR	VERMONT AGENCY OF TRANSPORTATION	JOB NO	
CUSTOMER			S.D. IRELAND CONCRETE CONSTRUCTION CORP.		J-81
					SHT NO
					2