
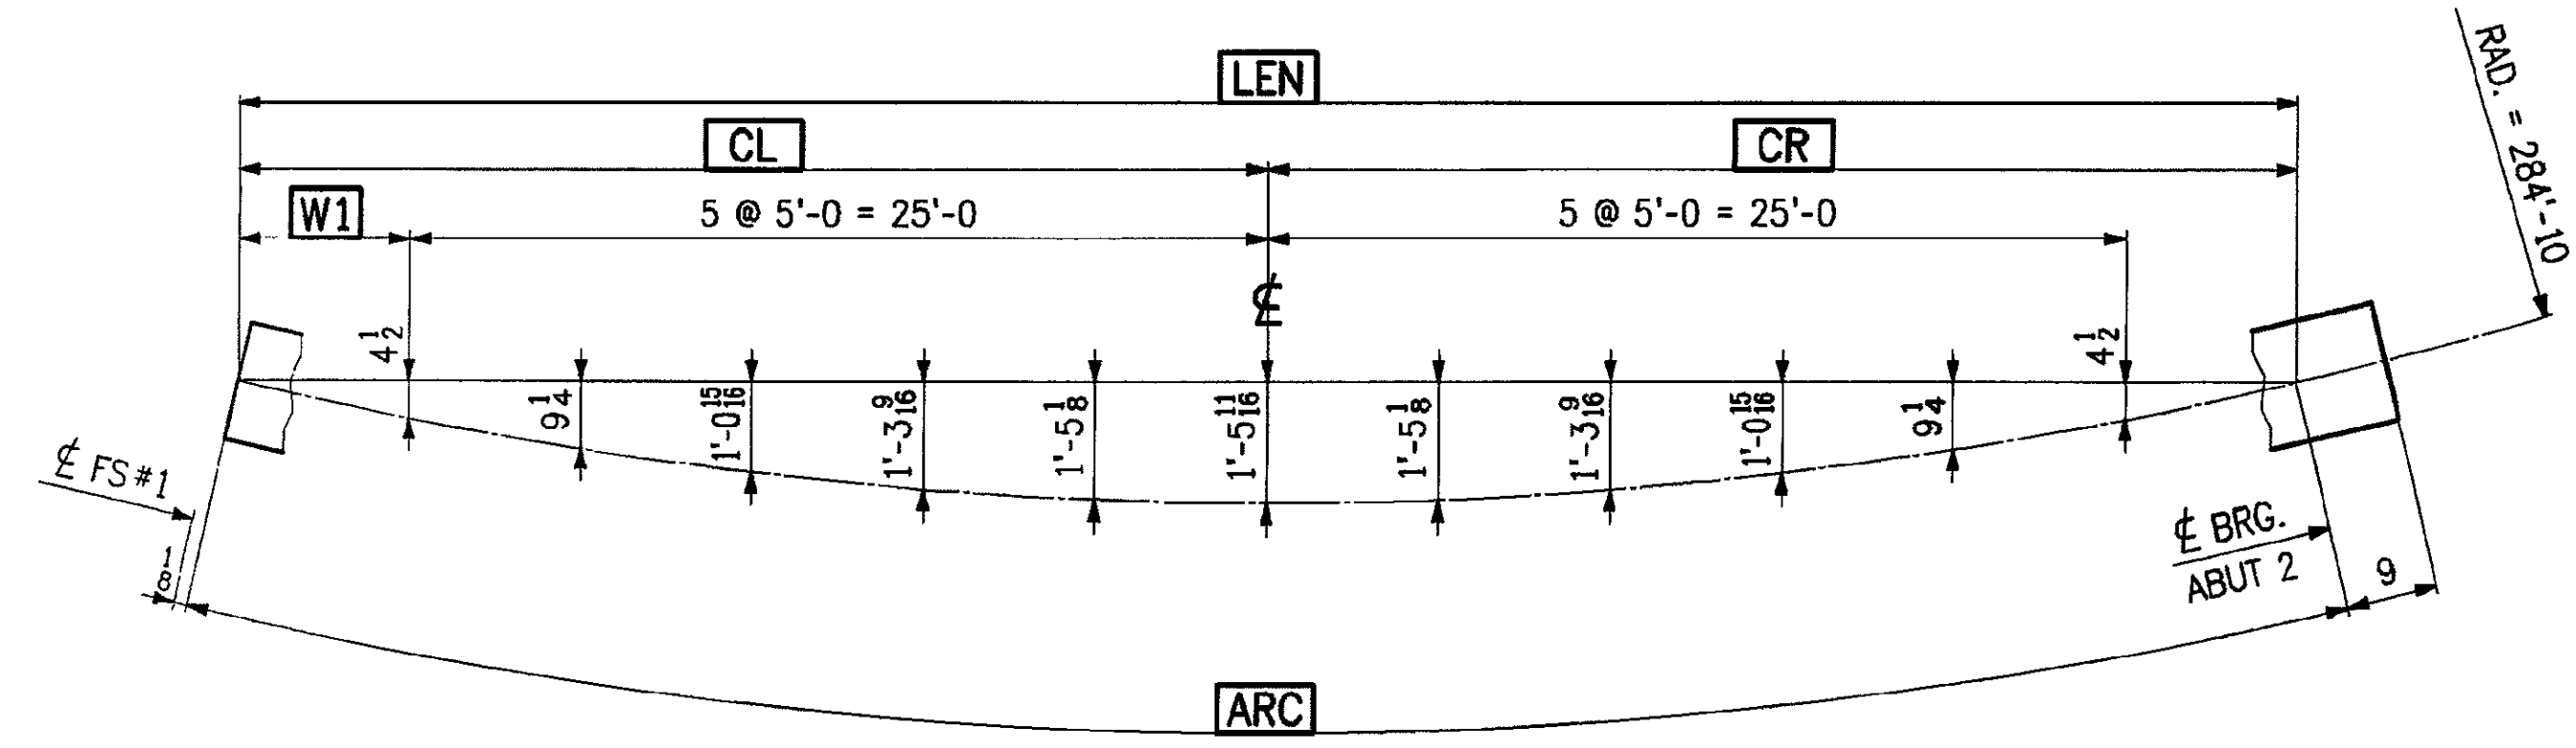


WEB CUTTING DIAGRAM FOR 17G1B

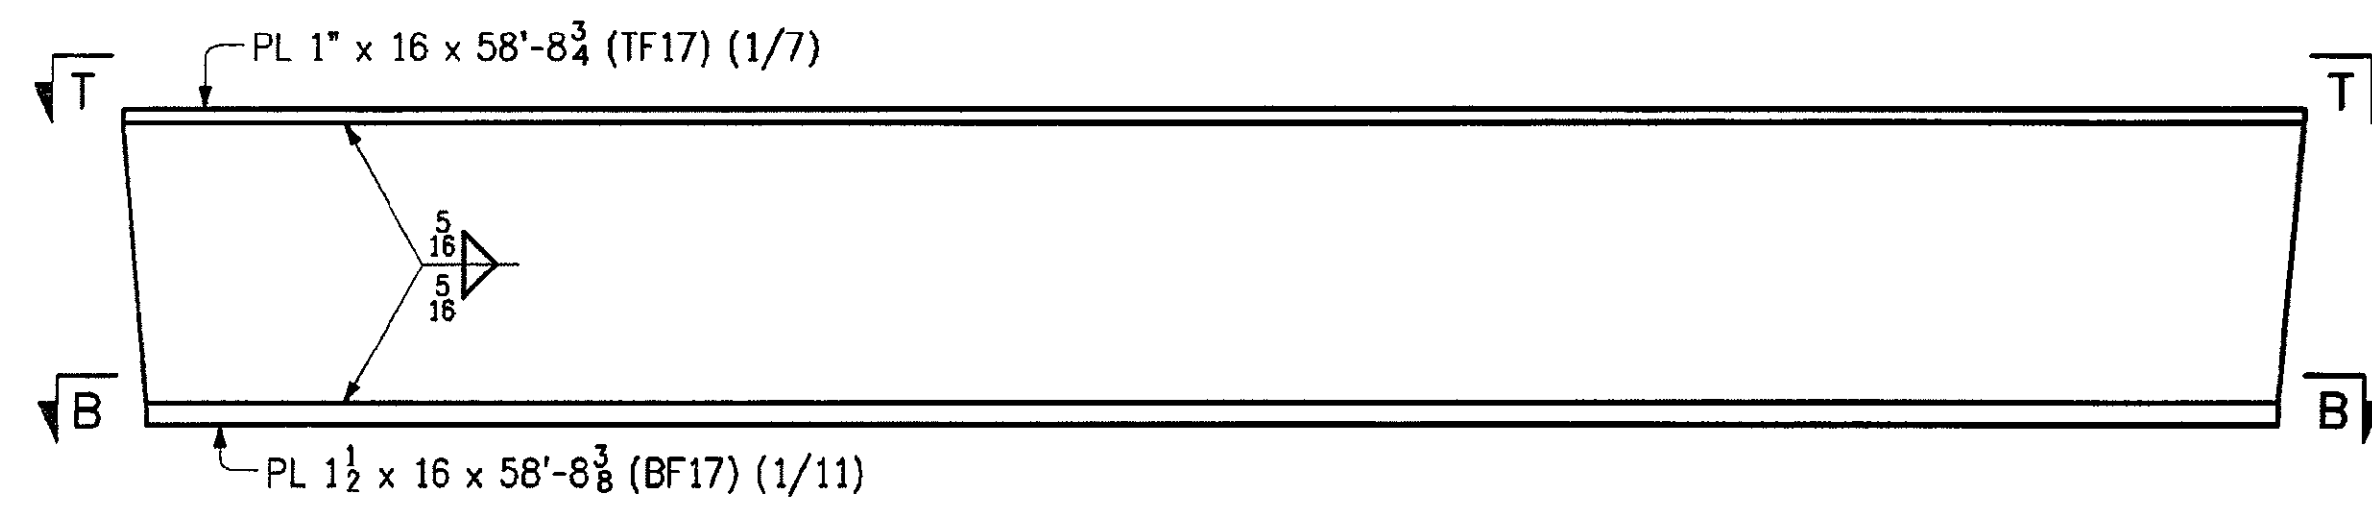

LOCATION	ARC	LEN	CL	CR	W1
VIEW T-T	57'-11 $\frac{3}{4}$	57'-10 $\frac{9}{16}$	28'-11 $\frac{5}{16}$	28'-11 $\frac{1}{4}$	3'-11 $\frac{5}{16}$
SECT. B-B	57'-11 $\frac{3}{8}$	57'-10 $\frac{3}{16}$	28'-11 $\frac{1}{16}$	28'-11 $\frac{1}{8}$	3'-11 $\frac{1}{16}$

NOTES:

- FOR GENERAL NOTES, SEE DWG. GN1.
- ALL MATERIAL SHALL BE M270-50W (CVN).

Accepted	<input checked="" type="checkbox"/>
Accepted as Noted	<input type="checkbox"/>
Accepted/Noted Resubmit	<input type="checkbox"/>
Rejected, Revise Resubmit	<input type="checkbox"/>
Rejected - Unacceptable	<input type="checkbox"/>

Checking is only for conformance with the design concept of the Project and compliance with the information given in the Contract Documents. The Engineer assumes no liability for errors or omissions that may be contained herein. The Contractor, by approving and submitting these documents, verifies their accuracy as stipulated on the Contractor's Shop Drawing Stamp.

7/7/09 DUBOIS AND KING
By *[Signature]*

RECEIVED
 OK'D BY: *JTL* OK'D BY: *KMH*
 JUN 10 2009
 APPROVED BY: *[Signature]*
 BY: *KMH* DATE: 7/13/09

REVISIONS			PRINT RECORD		
NO	DATE	DESCRIPTION	DATE	QTY	ISSUED
			6-15	E	Appr.

MEGQUIER & JONES INC.
 STRUCTURAL STEEL SINCE 1895
 1156 BROADWAY
 SOUTH PORTLAND, MAINE 04106

PAIN	HOLES U N	WELD U N	Q C REVIEW
PROJECT	TH NO. 1 OVER THE GIRON RIVER PROJECT NO. BHO 1448 (29) BRIDGE NO. 5 TOWN OF JOHNSON, VERMONT		DATE 6-4-09
DESCRIPTION	CAMBER DIAGRAMS		DRAWN BY RLK 5-22-09
ARCH	N/A	ENGR VERMONT AGENCY OF TRANSPORTATION	CHK'D BY GCS
CUSTOMER	S.D. IRELAND CONCRETE CONSTRUCTION CORP		JOB NO J-81
			SHT NO 6