
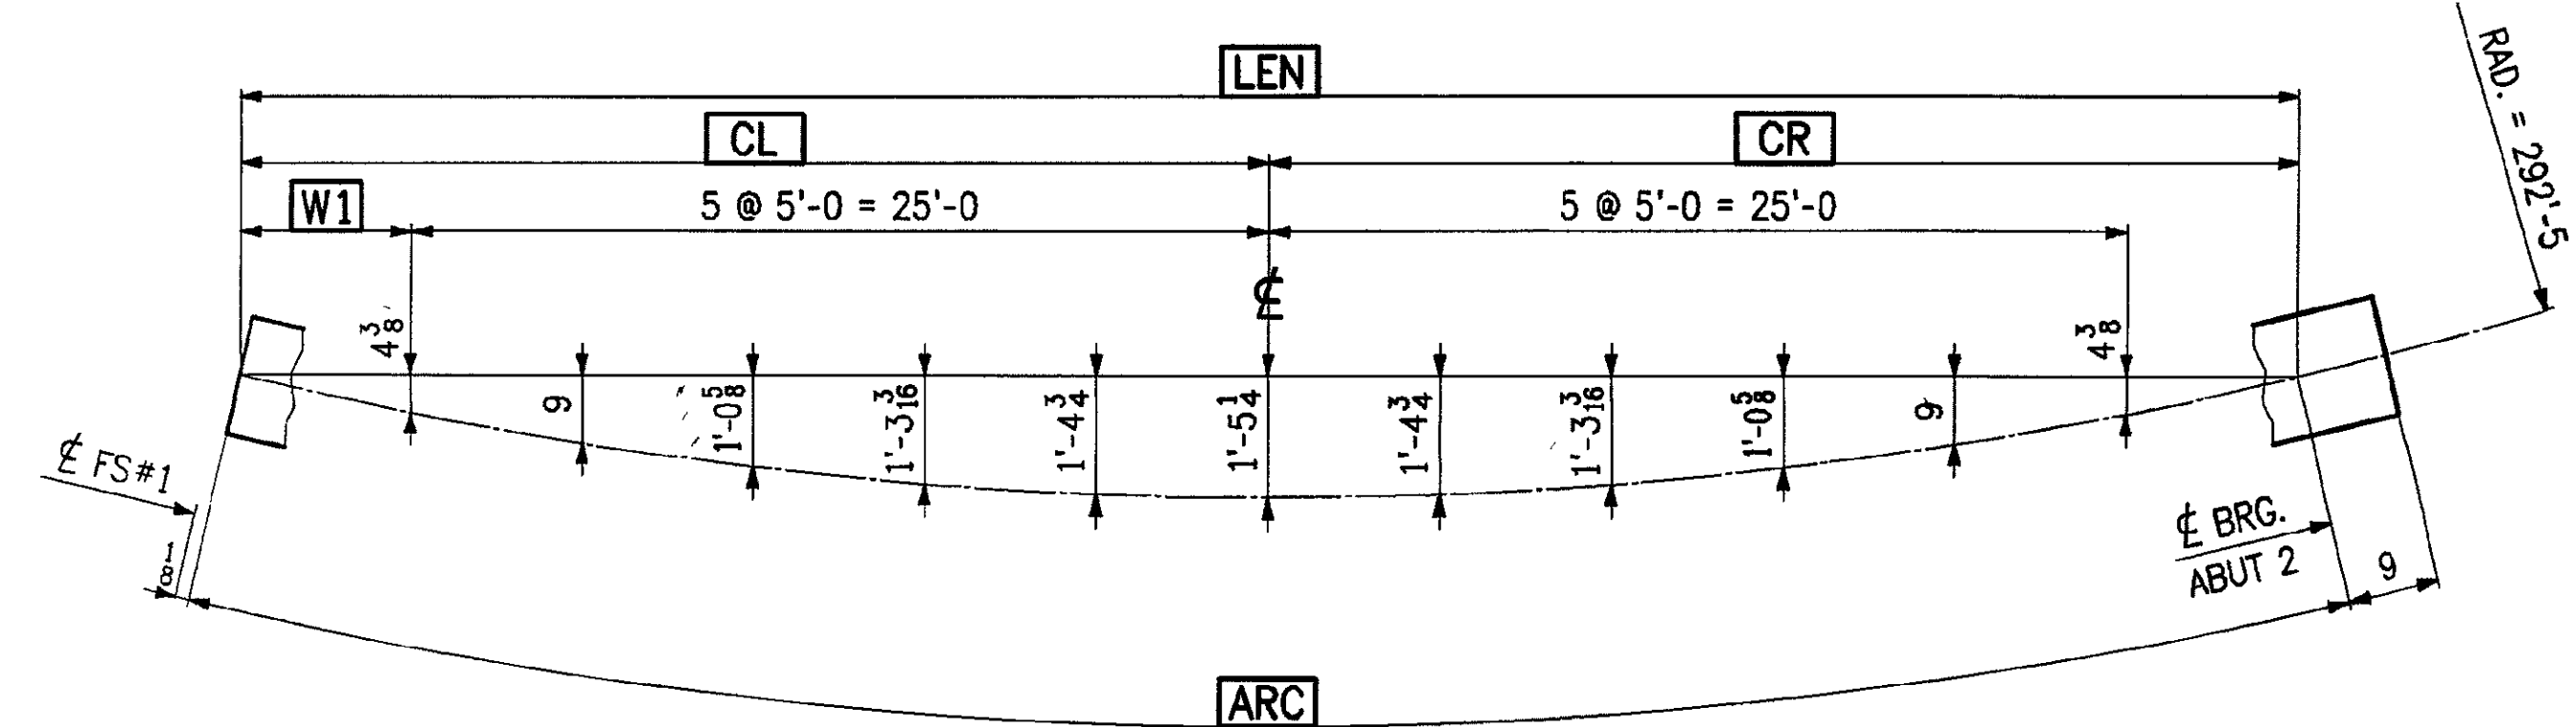


WEB CUTTING DIAGRAM FOR 18G2B

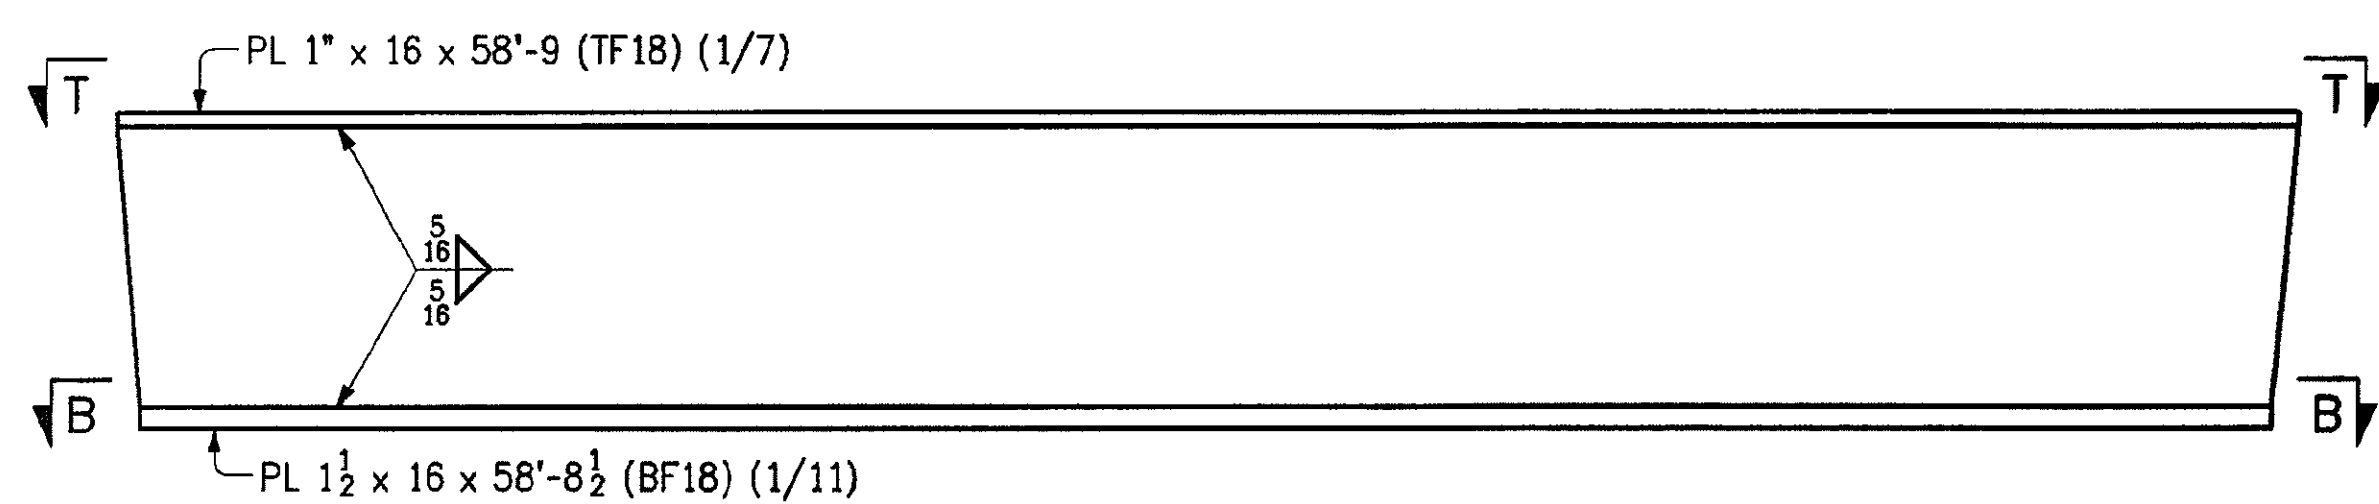

| LOCATION | ARC | LEN | CL | CR | W1 |
|-----------|------------|------------|------------|------------|-----------|
| VIEW T-T | 58'-0 | 57'-10 7/8 | 28'-11 1/8 | 28'-11 7/8 | 3'-11 7/8 |
| SECT. B-B | 57'-11 1/2 | 57'-10 3/8 | 28'-11 3/8 | 28'-11 3/8 | 3'-11 3/8 |

NOTES:

1. FOR GENERAL NOTES, SEE DWG. GN1
2. ALL MATERIAL SHALL BE M270-50W (CVN).

| | |
|---------------------------|--|
| Accepted | |
| Accepted as Noted | |
| Accepted Noted Resubmit | |
| Rejected, Revise Resubmit | |
| Rejected - Unacceptable | |

Checking is only for conformance with the design concept of the Project and compliance with the information given in the Contract Documents. The Engineer assumes no liability for errors or omissions that may be contained herein. The Contractor, by approving and submitting these documents, verifies their accuracy as stipulated on the Contractor's Shop Drawing Stamp.

DATE: 7/17/09
 BY: [Signature]
 DUBOIS AND KING

RECEIVED
 OK'D BY: [Signature] OK'D BY: [Signature]
 JUN 18 2009
 APPROVED BY: [Signature]
 BY: [Signature] DATE: 7/19/09

| REVISIONS | | | PRINT RECORD | | |
|-----------|------|-------------|--------------|-----|--------|
| NO | DATE | DESCRIPTION | DATE | QTY | ISSUED |
| | | | 6-15 | E | Appr. |

MEGQUIER & JONES INC.
 STRUCTURAL STEEL SINCE 1895
 1156 BROADWAY
 SOUTH PORTLAND, MAINE 04106

| | | | |
|-------------|--|---|-------------------------|
| PAINT | HOLES U N | WELD U N | Q C REVIEW |
| PROJECT | TH NO.1 OVER THE GIHON RIVER PROJECT NO. BHO 1448 (29) BRIDGE NO. 5 TOWN OF JOHNSON, VERMONT | | DATE 6-4-09 |
| DESCRIPTION | CAMBER DIAGRAMS | | DRAWN BY RLK 5-27-08 |
| ARCH | N/A | ENGR VERMONT AGENCY OF TRANSPORTATION | CHK'D BY EDL |
| CUSTOMER | S.D. IRELAND CONCRETE CONSTRUCTION CORP. | | JOB NO J-81 |
| | | | SHT NO 7 |