
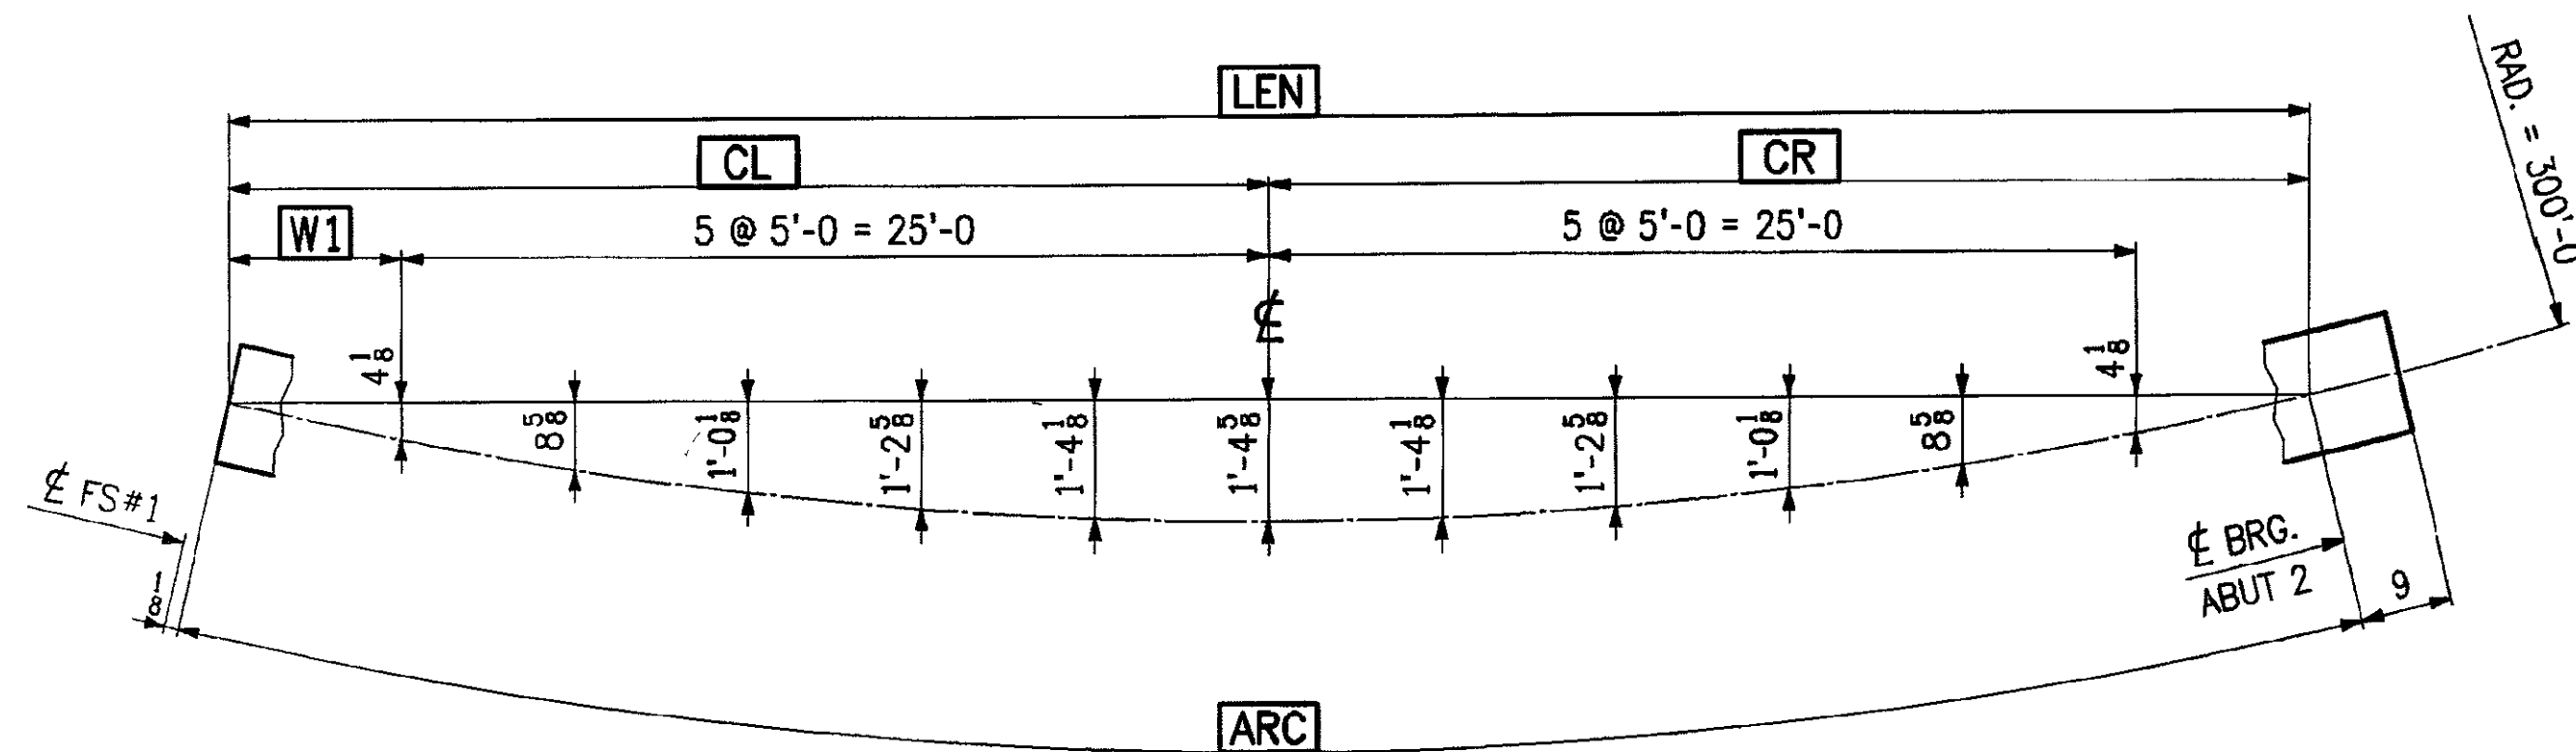


WEB CUTTING DIAGRAM FOR 19G3B

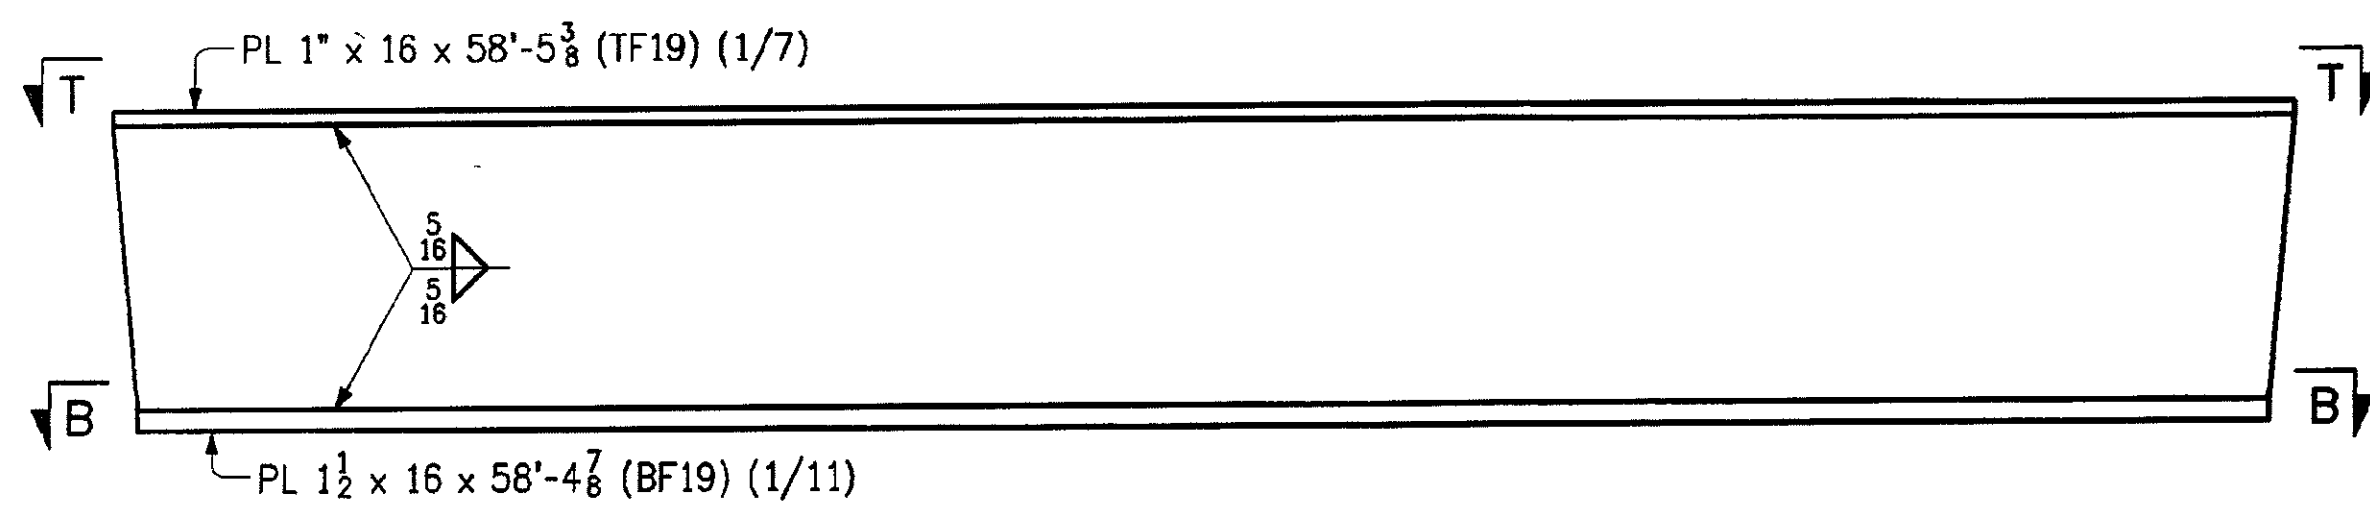

LOCATION	ARC	LEN	CL	CR	W1
VIEW T-T	57'-8 3/8	57'-7 5/8	28'-9 5/8	28'-9 11/8	3'-9 5/8
SECT. B-B	57'-7 7/8	57'-6 13/8	28'-9 3/8	28'-9 7/8	3'-9 3/8

NOTES:

1. FOR GENERAL NOTES, SEE DWG. GN1.
2. ALL MATERIAL SHALL BE M270-50W (CVN).

Accepted	
Accepted as Noted	
Accepted Noted Resubmit	
Rejected, Revise Resubmit	
Rejected - Unacceptable	
Checking is only for conformance with the design concept of the Project and compliance with the information given in the Contract Documents. The Engineer assumes no liability for errors or omissions that may be contained herein. The Contractor, by approving and submitting these documents, verifies their accuracy as stipulated on the Contractor's Shop Drawing Stamp.	
By: <i>[Signature]</i>	DuBOIS AND KING

RECEIVED
 OK'D BY: *JFL* OK'D BY: *KMH*
 JUN 10 2009
 APPROVED BY: *[Signature]*
 BY: *KMH* DATE: 7/13/09

REVISIONS			PRINT RECORD		
NO	DATE	DESCRIPTION	DATE	QTY	ISSUED
			6-15	E	Appa

MEGQUIER & JONES INC.

STRUCTURAL STEEL SINCE 1895
 1156 BROADWAY
 SOUTH PORTLAND, MAINE 04106

PAINT	HOLES U N	WELD U N	Q C REVIEW
PROJECT	TH NO. 1 OVER THE GIHON RIVER PROJECT NO BHO 1448 (29) BRIDGE NO. 5 TOWN OF JOHNSON, VERMONT		DATE 6-4-09
DESCRIPTION	CAMBER DIAGRAMS		DRAWN BY <i>RLK</i> 5-27-09
ARCH	N/A	ENGR VERMONT AGENCY OF TRANSPORTATION	CHK'D BY <i>GDC</i>
CUSTOMER	S.D. IRELAND CONCRETE CONSTRUCTION CORP		JOB NO J-81
			SHT NO 8