
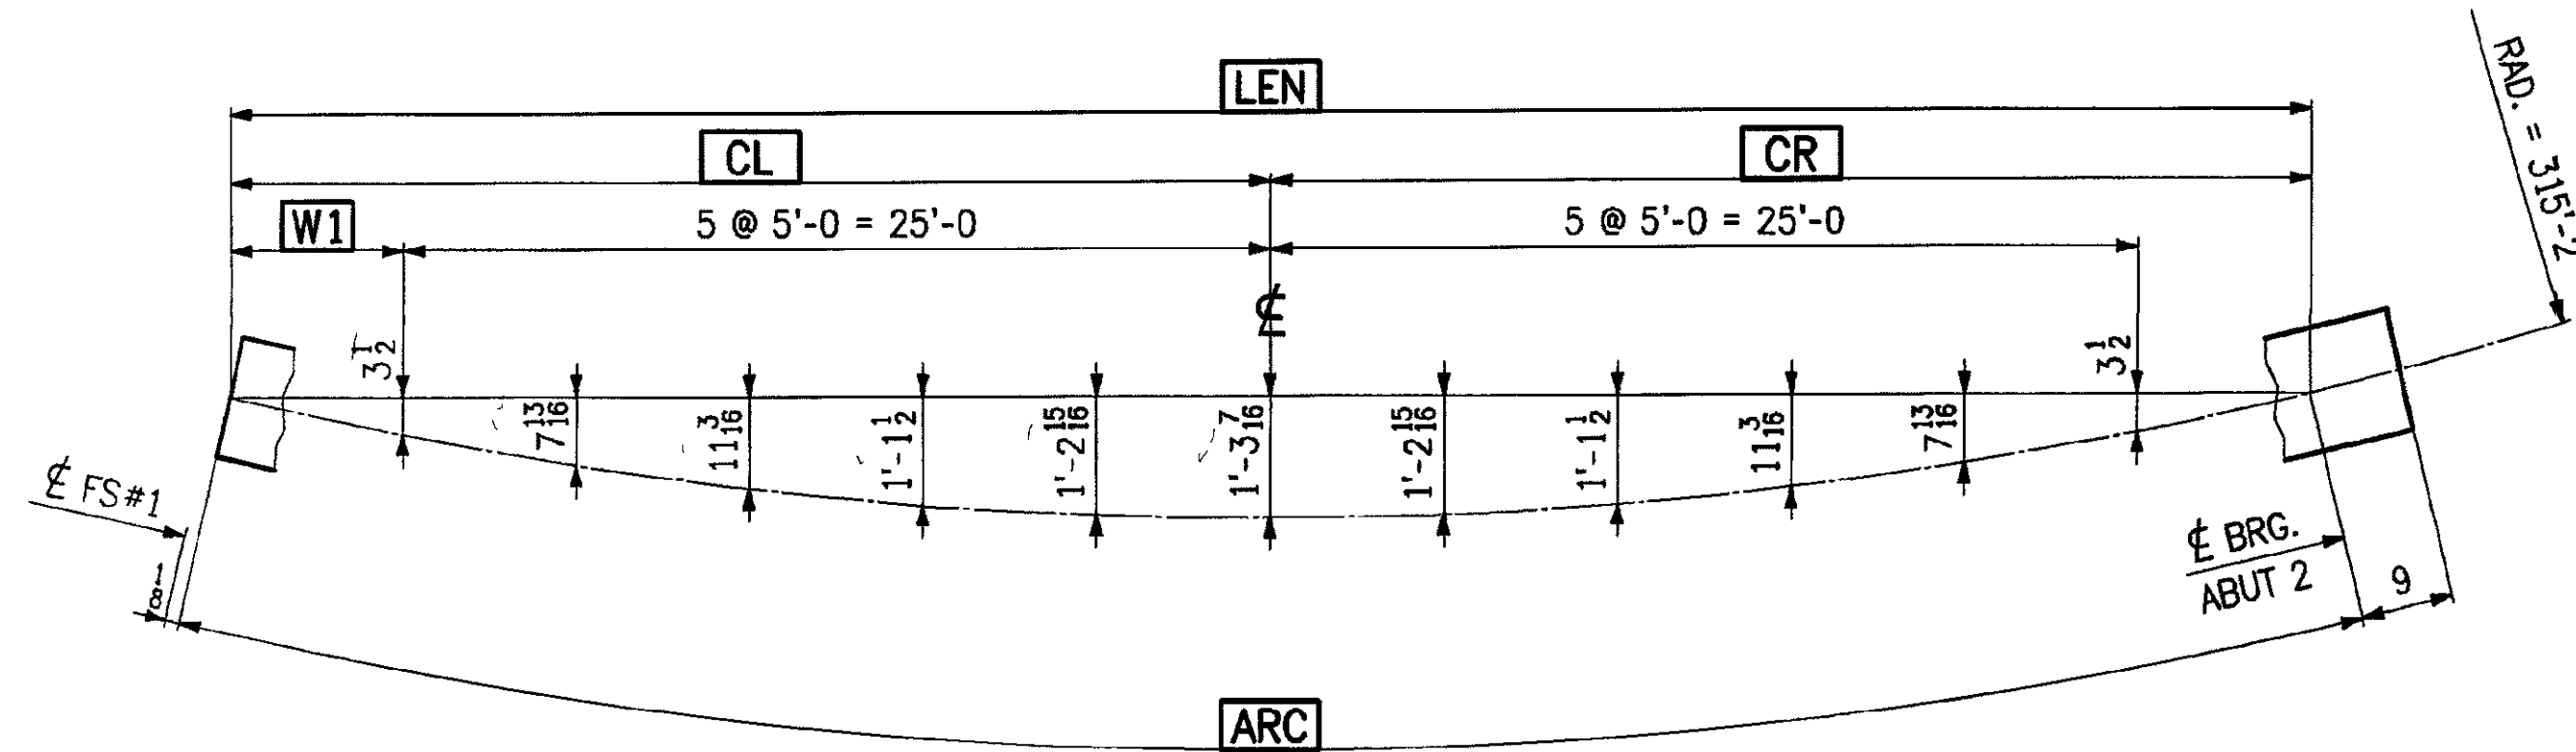


WEB CUTTING DIAGRAM FOR 21G5B

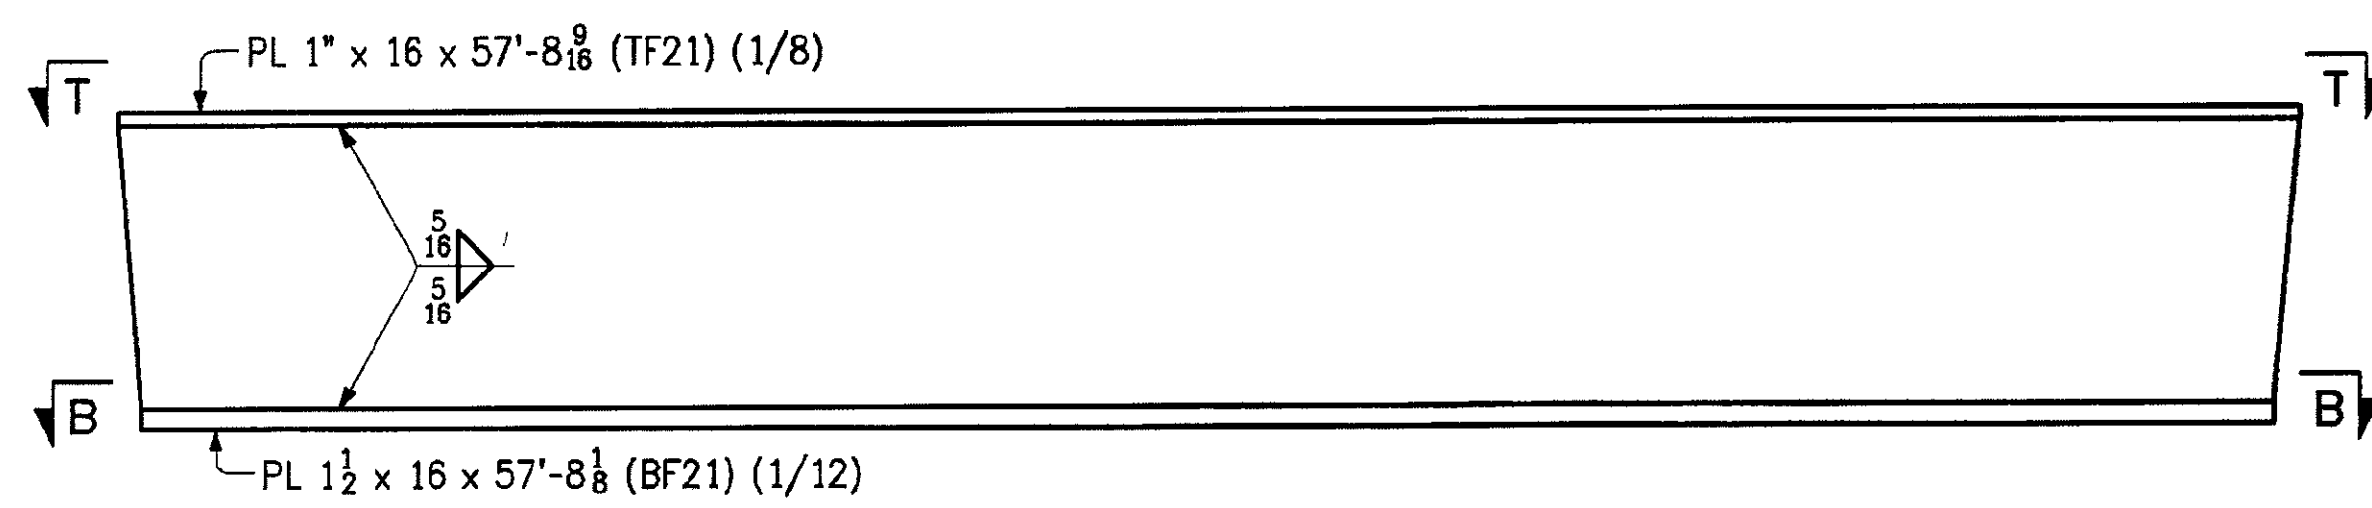

LOCATION	ARC	LEN	CL	CR	W1
VIEW T-T	56'-11 1/8	56'-10 5/8	28'-5 5/16	28'-5 5/16	3'-5 5/16
SECT. B-B	56'-11 1/8	56'-10 3/16	28'-5 1/8	28'-5 1/8	3'-5 1/16

**NOTES:**

- FOR GENERAL NOTES, SEE DWG. GN1.
- ALL MATERIAL SHALL BE M270-50W (CVN).

Accepted	
Accepted as Noted	
Accepted Noted Resubmit	
Rejected, Revise Resubmit	
Rejected - Unacceptable	
Checking is only for conformance with the design concept of the Project and compliance with the information given in the Contract Documents. The Engineer assumes no liability for errors or omissions that may be contained herein. The Contractor, by approving and submitting these documents, verifies their accuracy as stipulated on the Contractor's Shop Drawing Stamp.	
By: <i>[Signature]</i>	DUBOIS AND KING
Date: 7/7/09	

RECEIVED  
 OK'D BY: *[Signature]* OK'D BY: *[Signature]*  
 JUN 18 2009  
 APPROVED: *[Signature]*  
 BY: *[Signature]* DATE: 7/1/09

REVISIONS		PRINT RECORD			
NO	DATE	DESCRIPTION	DATE	QTY	ISSUED
			6-15	E	Appr.
<b>MEGQUIER &amp; JONES INC.</b>					
STRUCTURAL STEEL SINCE 1895					
1156 BROADWAY					
SOUTH PORTLAND, MAINE 04106					
PAINT	HOLES U N	WELD U N	Q C REVIEW		
PROJECT	TH NO.1 OVER THE GIHON RIVER PROJECT NO BHO 1448 (29) BRIDGE NO. 5 TOWN OF JOHNSON, VERMONT			DATE	6-4-09
DESCRIPTION	CAMBER DIAGRAMS			DRAWN BY	RLK 5-27-09
ARCH.	N/A	ENGR	VERMONT AGENCY OF TRANSPORTATION	CHK'D BY	EGC
CUSTOMER	S.D. IRELAND CONCRETE CONSTRUCTION CORP.			JOB NO	J-81
				SHT NO	10