


STATE OF VERMONT AGENCY OF TRANSPORTATION



PROPOSED IMPROVEMENT BRIDGE PROJECT TOWN OF CLARENDON COUNTY OF RUTLAND


BRIDGE NO.15 ON TOWN HIGHWAY NO.3 (MINOR COLLECTOR)

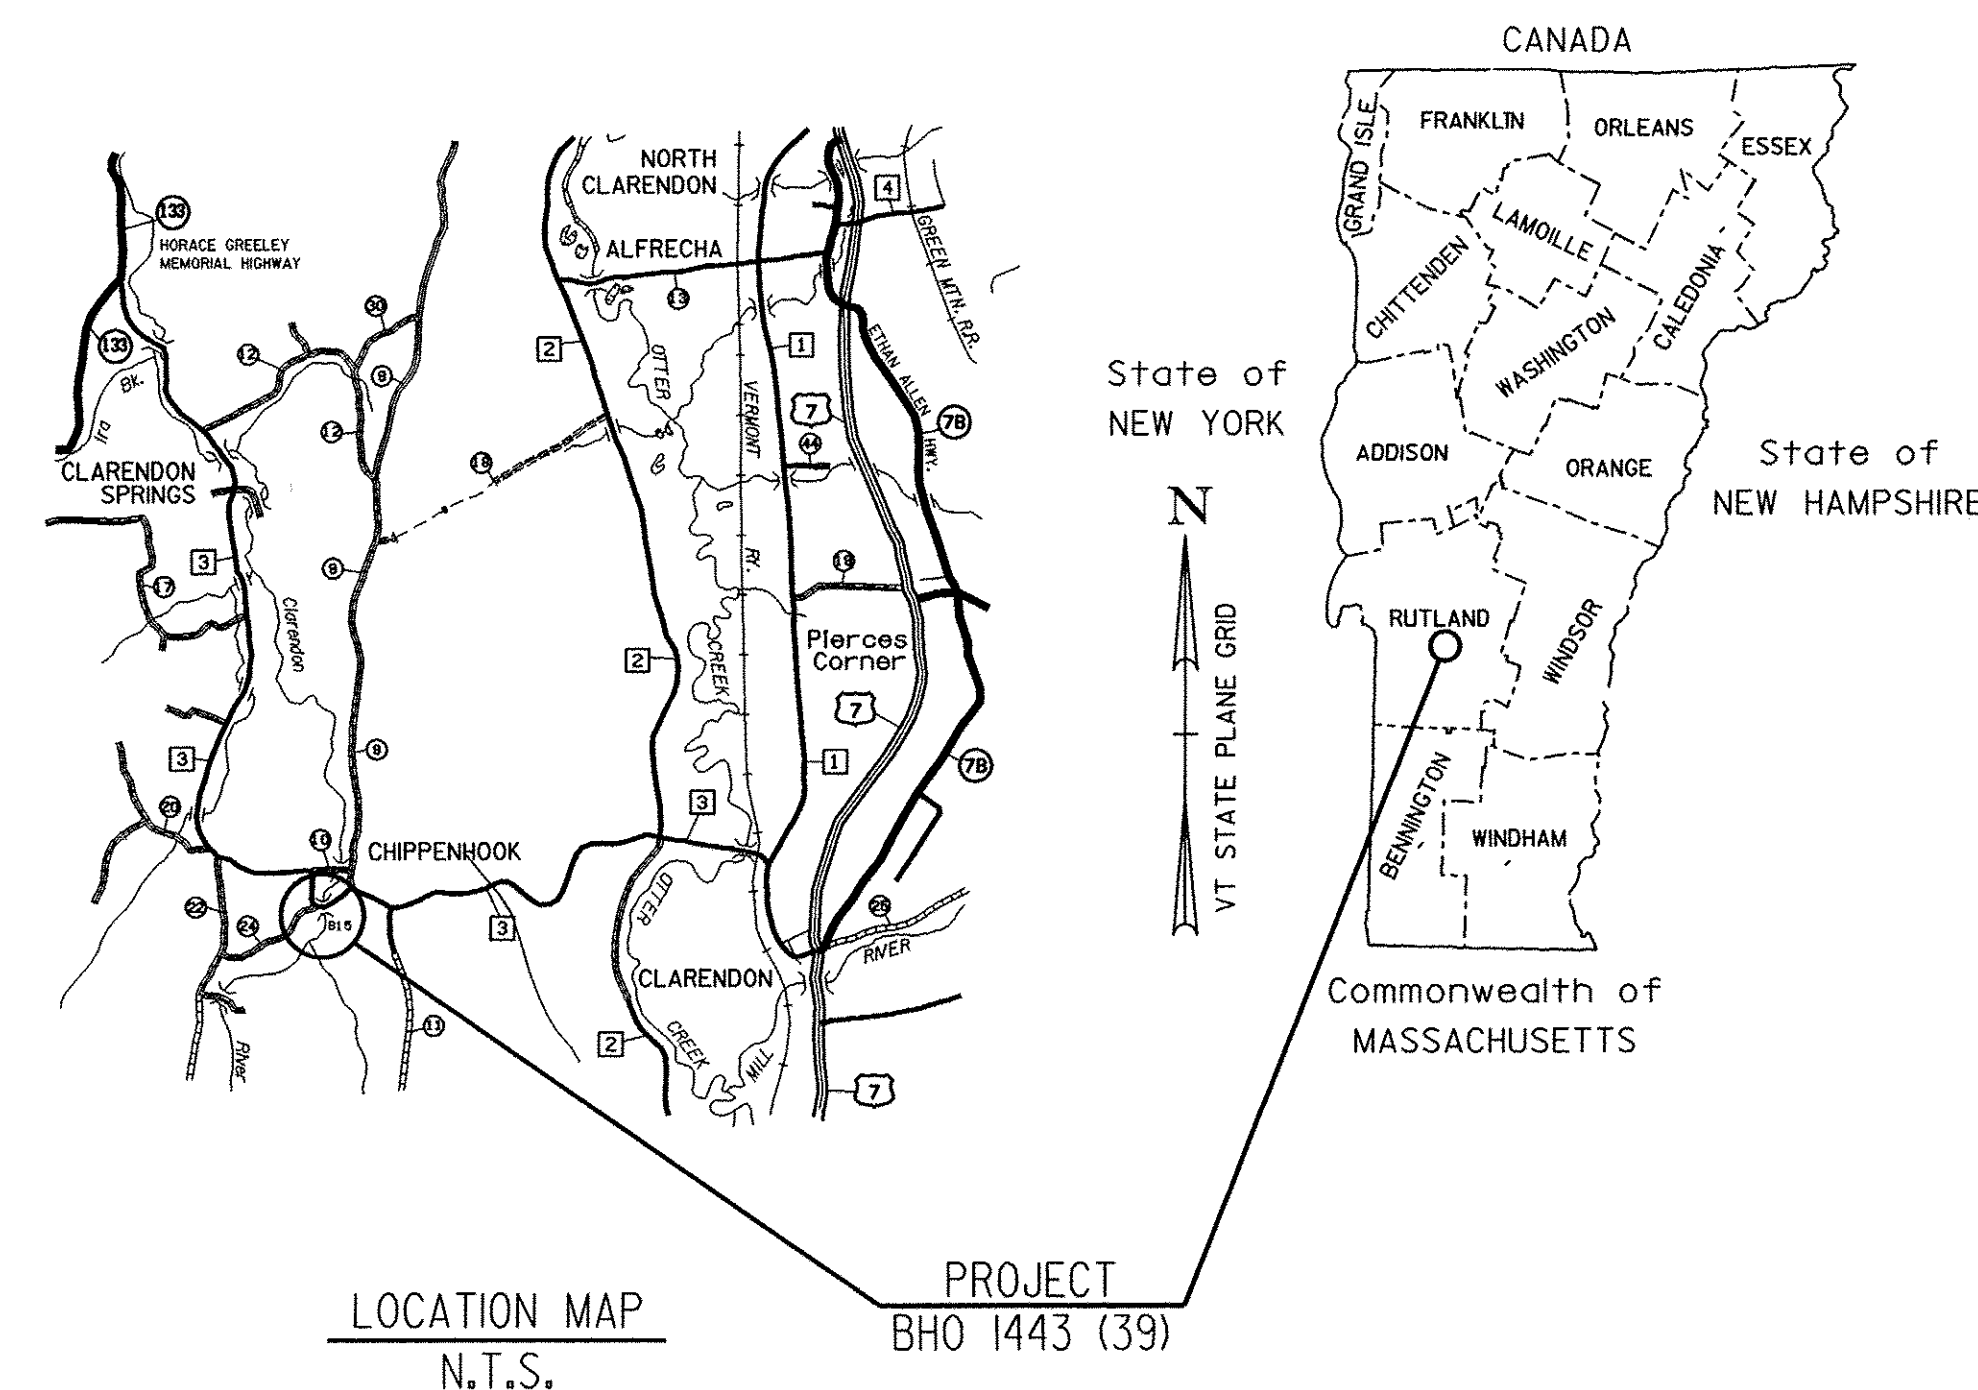

PROJECT LOCATION: BEGINNING AT APPROXIMATELY 2.45 MILES WEST OF THE INTERSECTION OF TOWN HIGHWAY 1 AND TOWN HIGHWAY 3 AND EXTENDING WEST 0.027 MILES.

PROJECT DESCRIPTION: THIS PROJECT INVOLVES THE REMOVAL OF THE EXISTING BRIDGE SUPERSTRUCTURE, REHABILITATION OF EXISTING BRIDGE ABUTMENTS, CONSTRUCTION OF THE NEW BRIDGE SUPERSTRUCTURE AND MINOR APPROACH RECONSTRUCTION.
 LENGTH OF STRUCTURE: 68.77 FEET (0.013 MILES)
 LENGTH OF ROADWAY: 71.41 FEET (0.014 MILES)
 LENGTH OF PROJECT: 140.18 FEET (0.027 MILES)


RECORD PLANS	
CONTRACTOR:	MILLER CONSTRUCTION, INC. - WINDSOR, VT
RESIDENT ENGINEER:	ERIC FOSTER
CONSTRUCTION BEGAN:	SEPTEMBER 22, 2009
CONSTRUCTION COMPLETE:	AUGUST 20, 2010
RECORD PLANS BY:	ERIC FOSTER & AMOS KEMPTON
I HEREBY CERTIFY THAT ALL THE CONSTRUCTION REQUIRED BY THIS SET OF DRAWINGS HAS BEEN ACCOMPLISHED AS INDICATED HEREIN.	
BY	<i>Eric Foster</i> RESIDENT ENGINEER
DATE	12-1-12
NOTE: Any further information concerning final quantities, amounts or other details relative to this project may be found at Central Files in the electronic archives.	

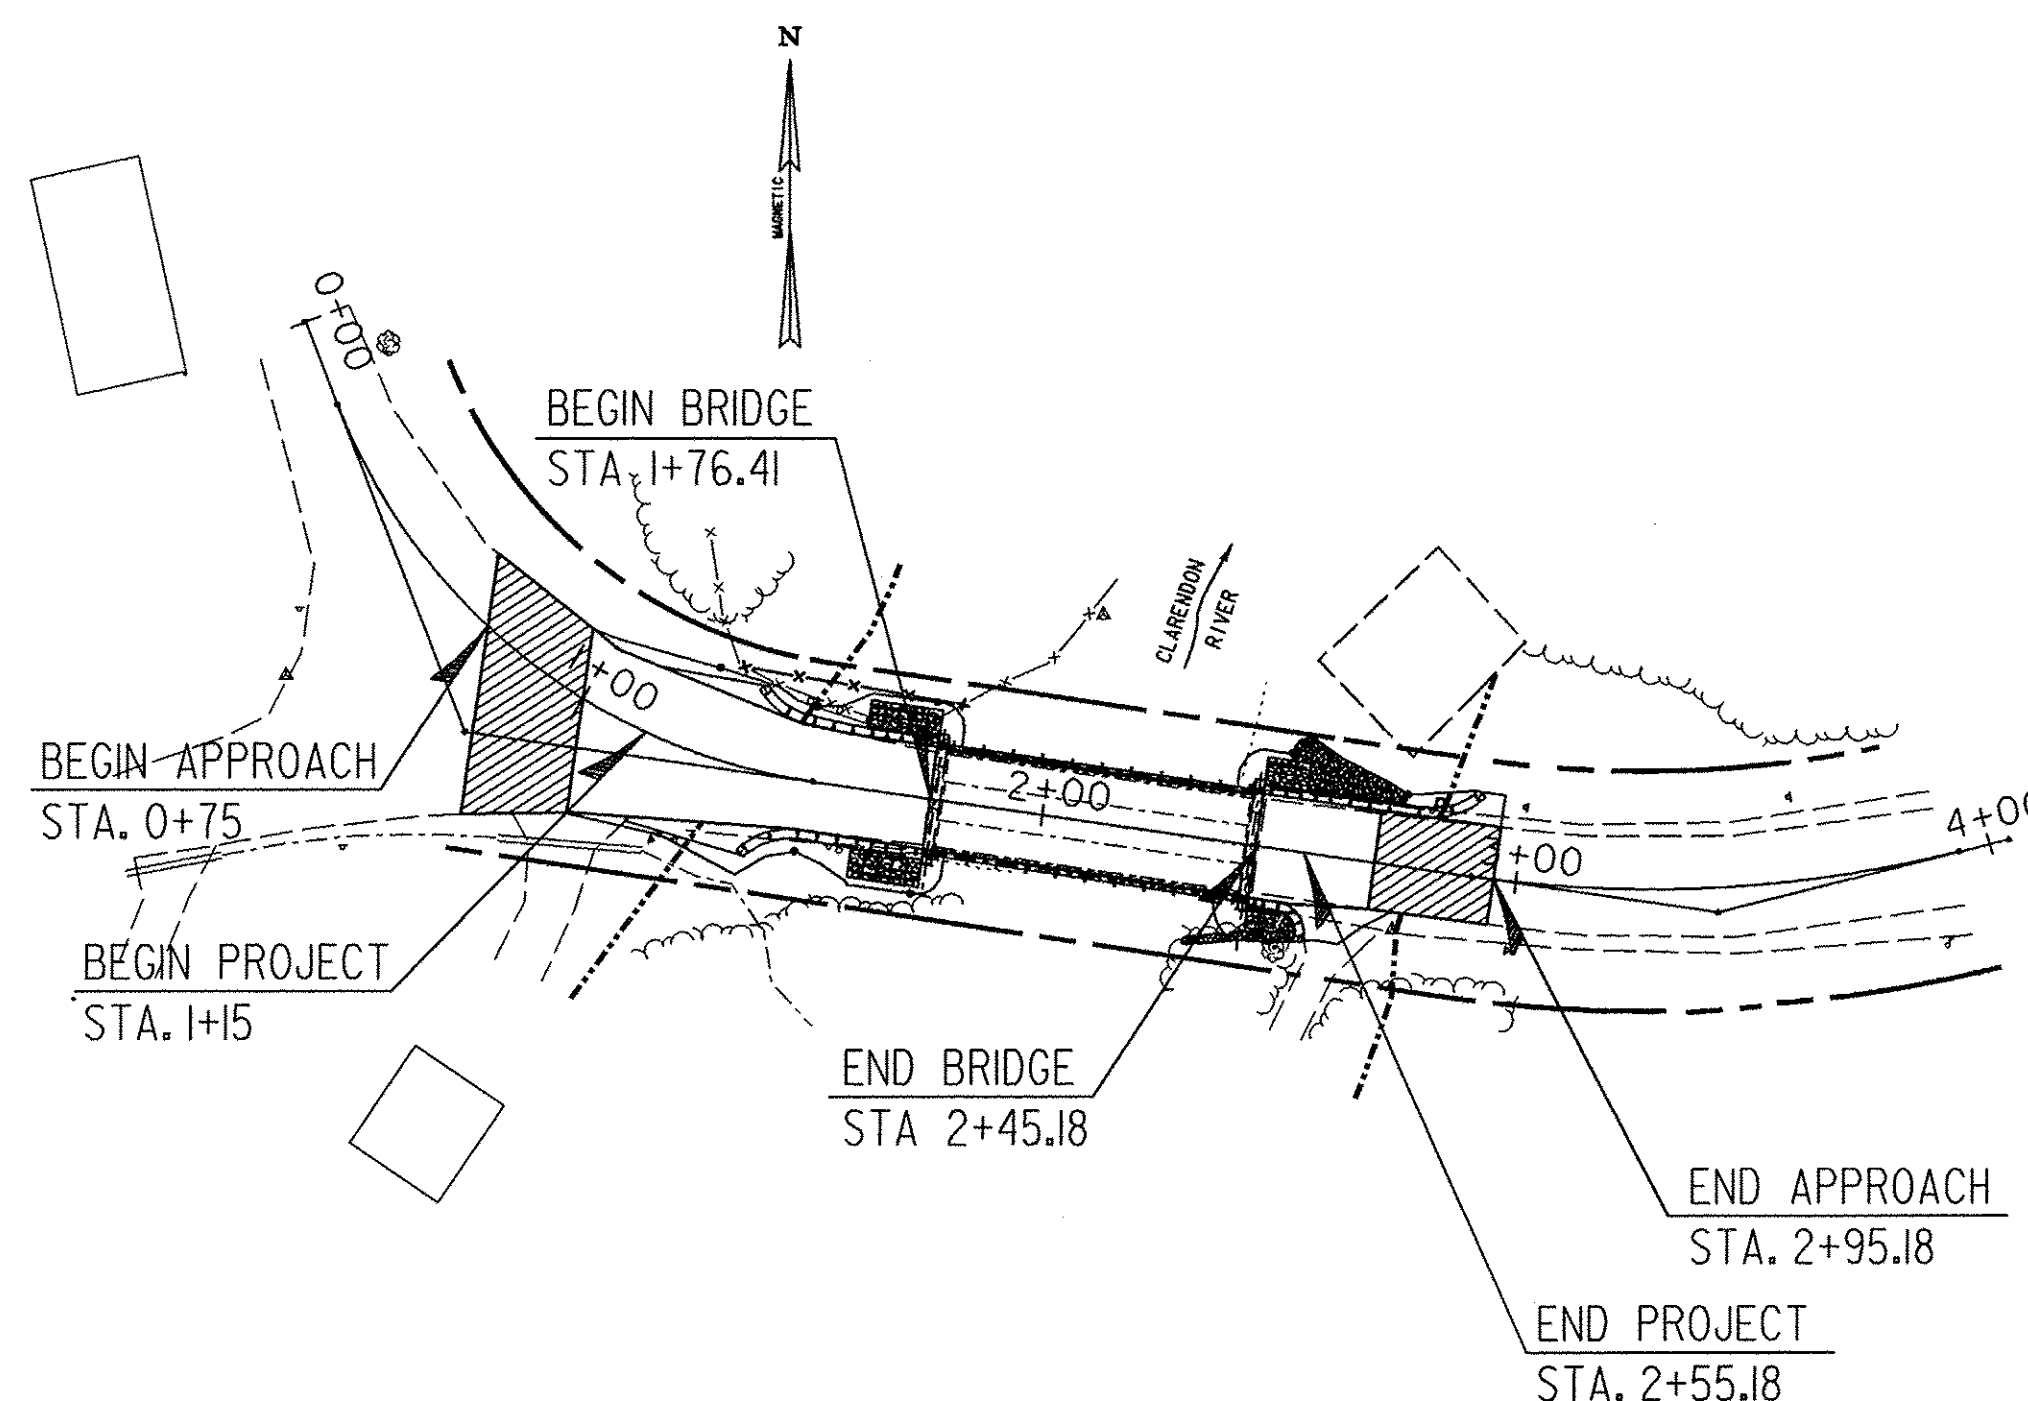

CONVENTIONAL SYMBOLS	
COUNTY LINE	
TOWN LINE	
LIMITS OF ACCESS	
POINT OF ACCESS	
FENCE LINE	
STONE WALL	
TRAVELED WAY	
GUARD RAIL	
RAILROAD	
SURVEY LINE	
CULVERT	
POWER POLE	
TELEPHONE POLE	
TREES	
CONTROL OF ACCESS	
PROPERTY LINE	
R.O.W. TAKING LINE	
SLOPE RIGHTS	
TOP OF CUT	
TOE OF SLOPE	

SURVEYED BY : VERMONT SURVEY CONSULT., INC
 SURVEYED DATE : MAY 16, 2000

DATUM
 VERTICAL NGVD 1988
 HORIZONTAL ASSUMED

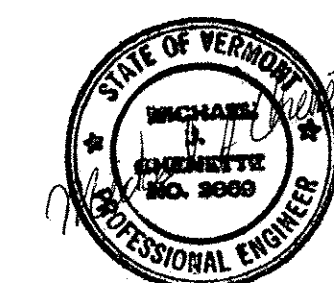

Stantec Consulting Services Inc.
 55 Green Mountain Drive
 South Burlington VT U.S.A.
 05403
 Tel. 802.864.0223
 Fax. 802.864.0165
 www.stantec.com

THESE PLANS ARE SUBJECT TO SUCH ENGINEERING CHANGES AS MAY BE REQUIRED BY THE FEDERAL HIGHWAY ADMINISTRATION OR THE DIRECTOR OF PROGRAM DEVELOPMENT.
 CONSTRUCTION IS TO BE CARRIED ON IN ACCORDANCE WITH THESE PLANS AND THE STANDARD SPECIFICATIONS FOR CONSTRUCTION DATED 2006, AS APPROVED BY THE FEDERAL HIGHWAY ADMINISTRATION ON JUNE 15, 2006 FOR USE ON THIS PROJECT, INCLUDING ALL SUBSEQUENT REVISIONS AND SUCH REVISED SPECIFICATIONS AND SPECIAL PROVISIONS AS ARE INCORPORATED IN THESE PLANS.

DIRECTOR OF PROGRAM DEVELOPMENT
 APPROVED *Richard Jehant* DATE 7-16-09
 PROJECT MANAGER : MARTHA EVANS-MONGEON
 PROJECT NAME : CLARENDON
 PROJECT NUMBER : BHO 1443 (39)
 SHEET 1 OF 24 SHEETS