


TRAVERSE TIES

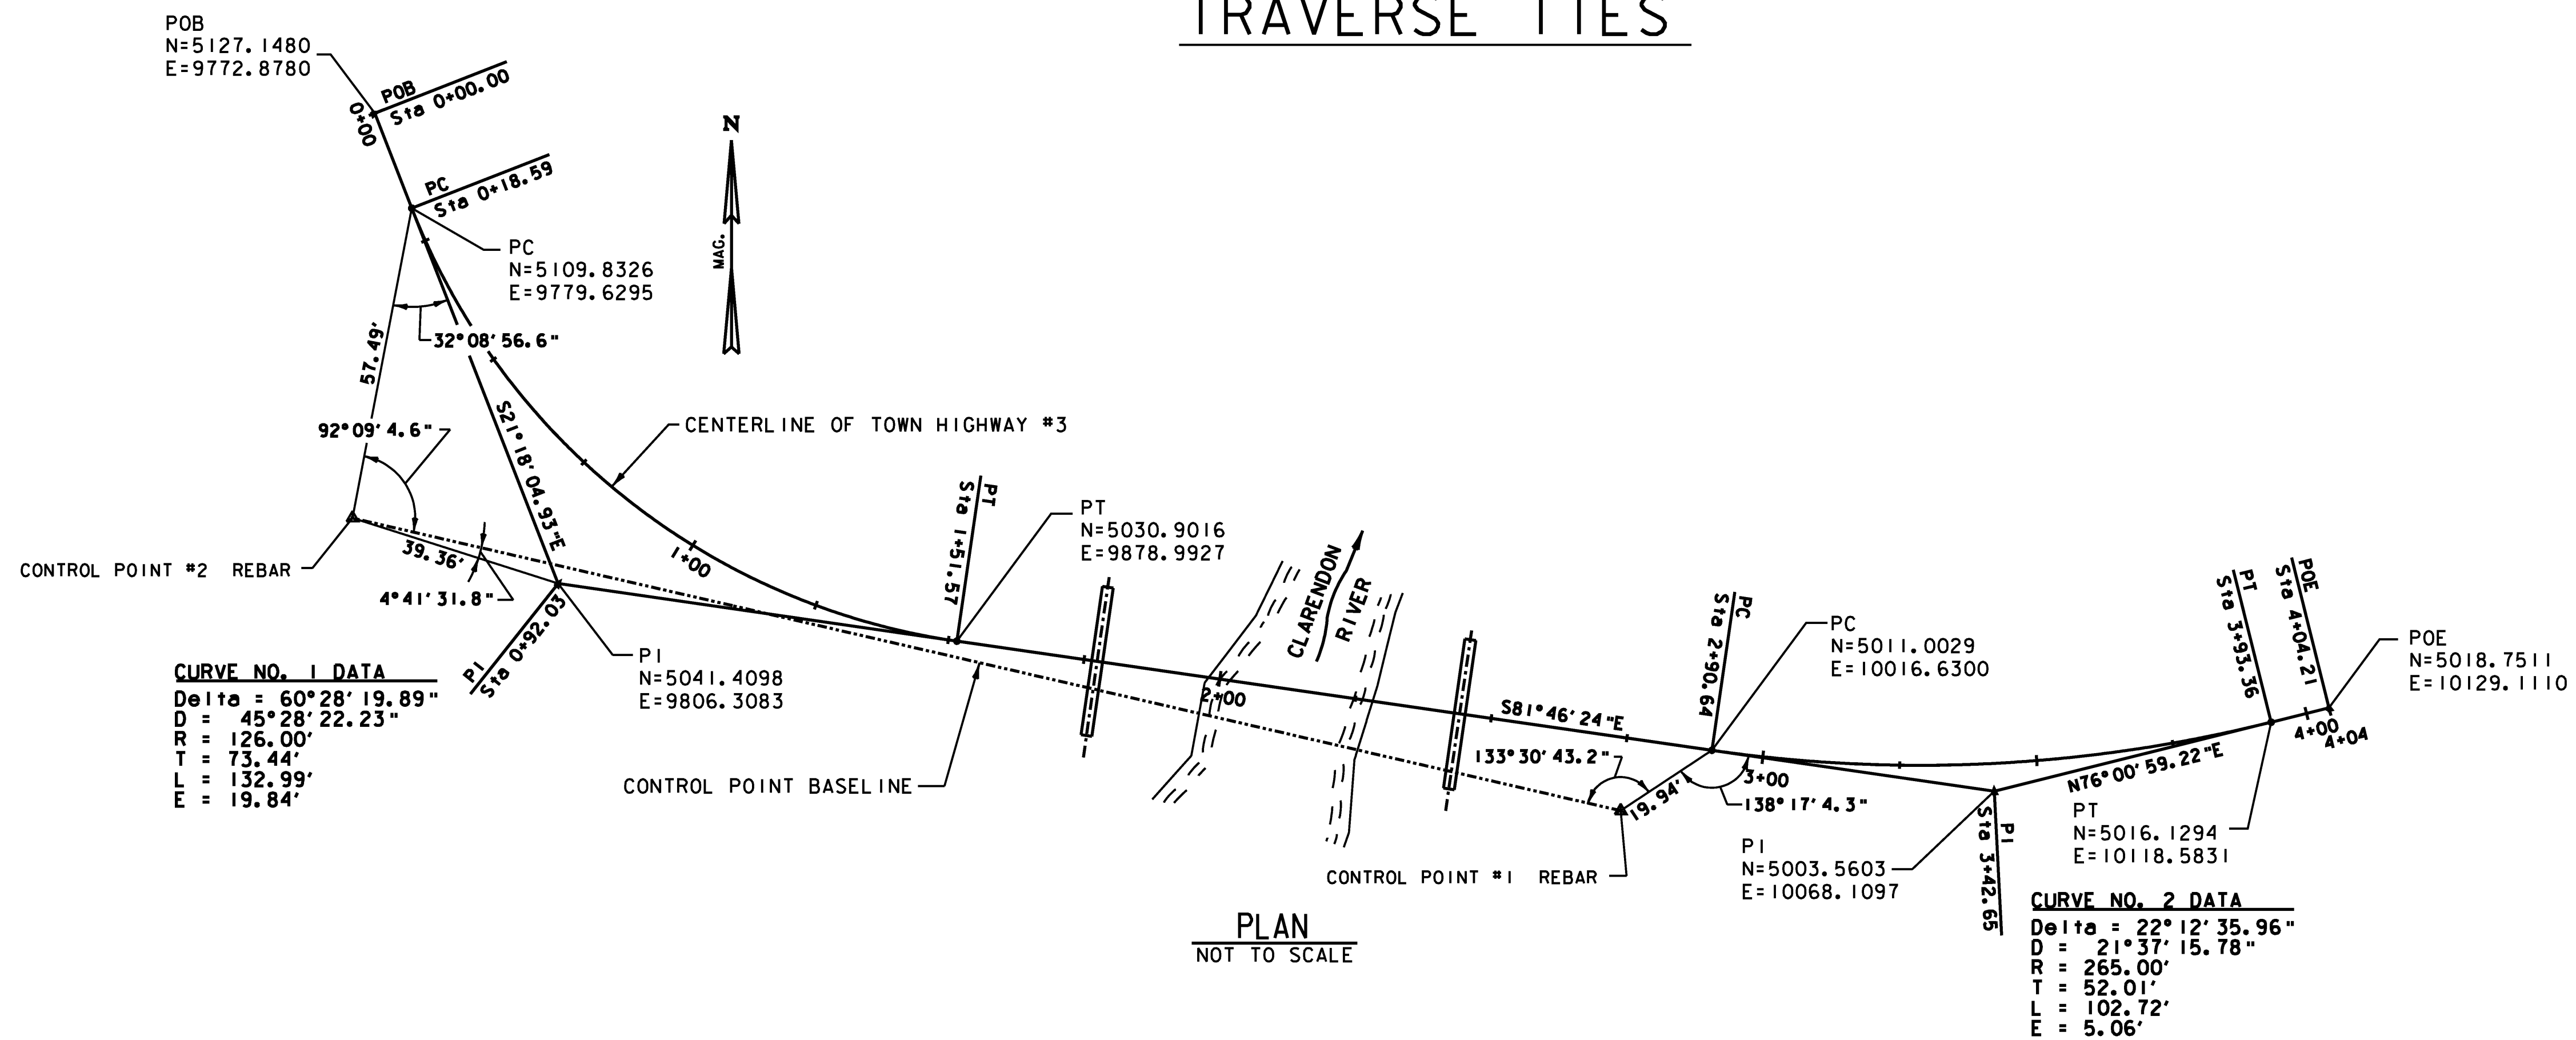

ALIGNMENT COORDINATES

SURVEYED BY : VERMONT SURVEY CONSULT., INC  
SURVEYED DATE : MAY 16, 2000

DATUM  
VERTICAL NGVD 1988  
HORIZONTAL ASSUMED



PROJECT NAME: CLARENDON  
PROJECT NUMBER: BHO 1443 (39)

FILE NAME: ...Drawing\08-clar-ties.dgn PLOT DATE: 7/2/2009  
PROJECT LEADER: MJC DRAWN BY: AET  
DESIGNED BY: SEB CHECKED BY: MJC  
TIE SHEET SHEET 8 OF 24