


SITE PLAN

SCALE 1" = 10'-0"

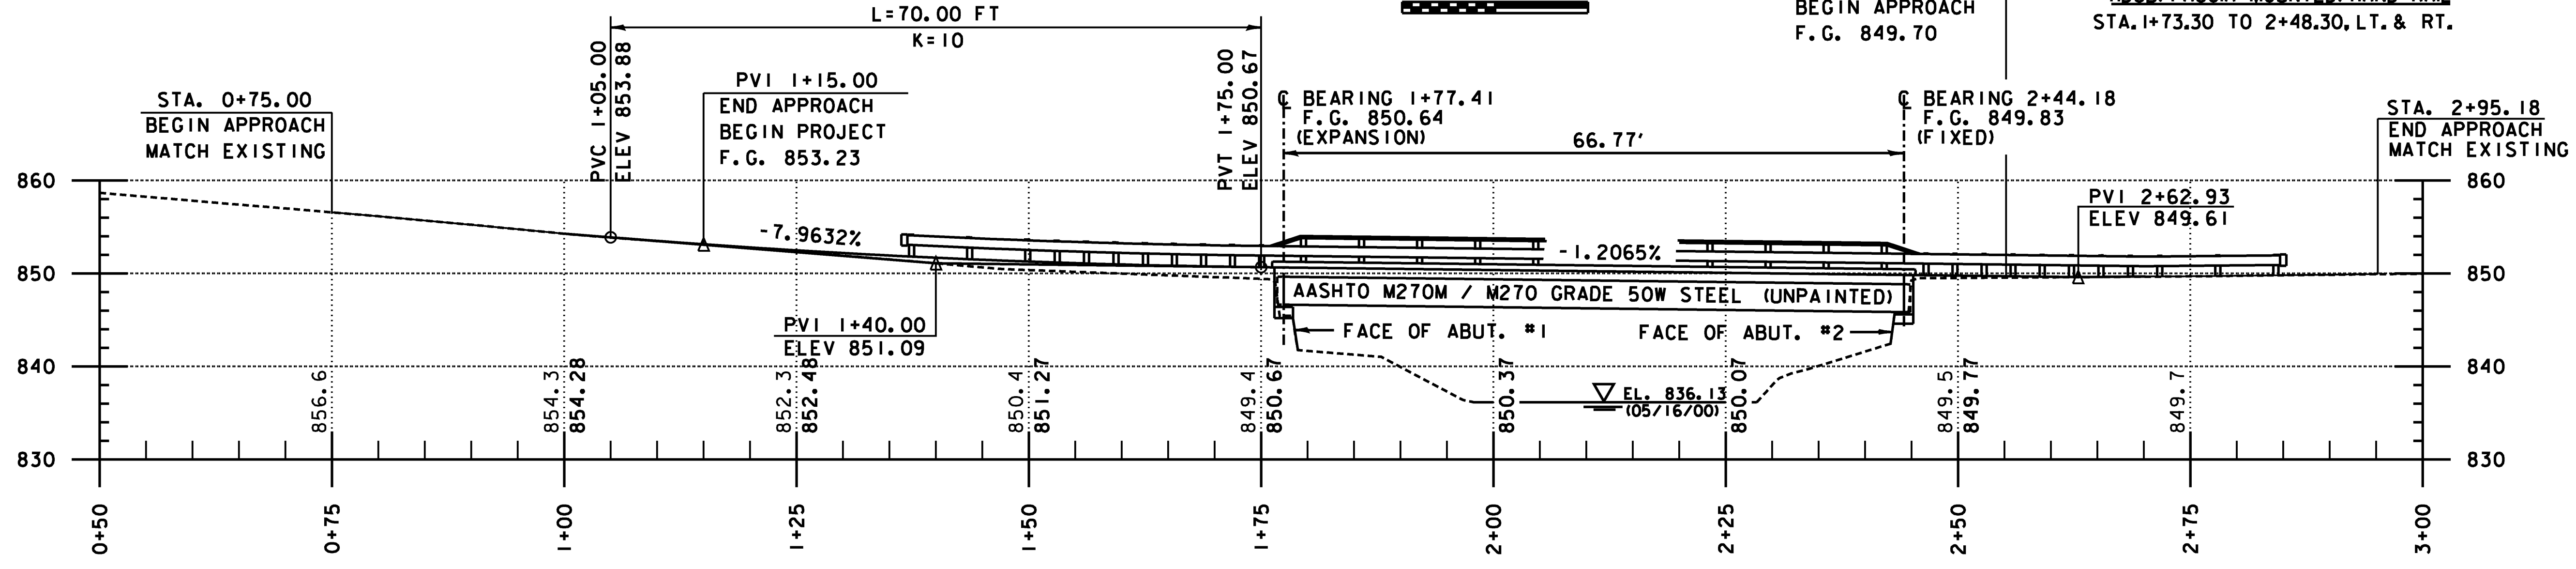

PROJECT NAME: CLARENDON
PROJECT NUMBER: BHO 1443 (39)

FILE NAME: ...Drawing\09-clar-bdr.dgn
PROJECT LEADER: MJC
DESIGNED BY: SEB
SITE PLAN AND PROFILE

PLOT DATE: 7/23/2009
DRAWN BY: AET
CHECKED BY: MJC
SHEET 9 OF 24