


PLAN VIEW

SIDE VIEW

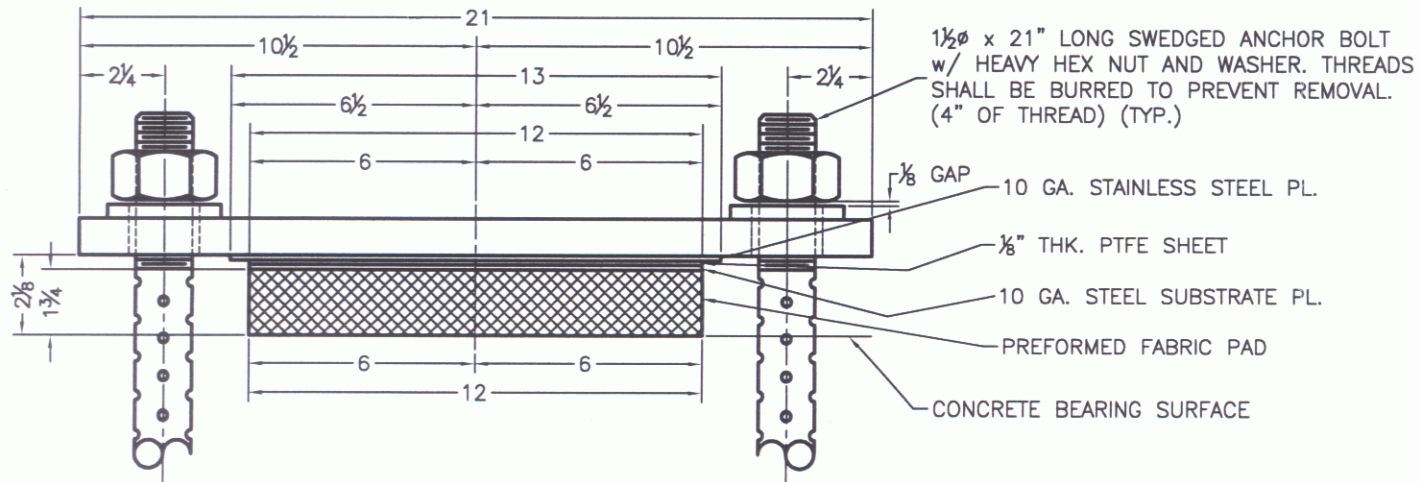

ELEVATION VIEW

ABUTMENT NO. 1  
QTY REQ'D = 4 ASSY.  
ITEM NO. 531.10

8

7

6

5

4