


08:05:45 AM
06/13/03
M:\187378_vt_rail\sharon_crossing\dm\sh16.dgn

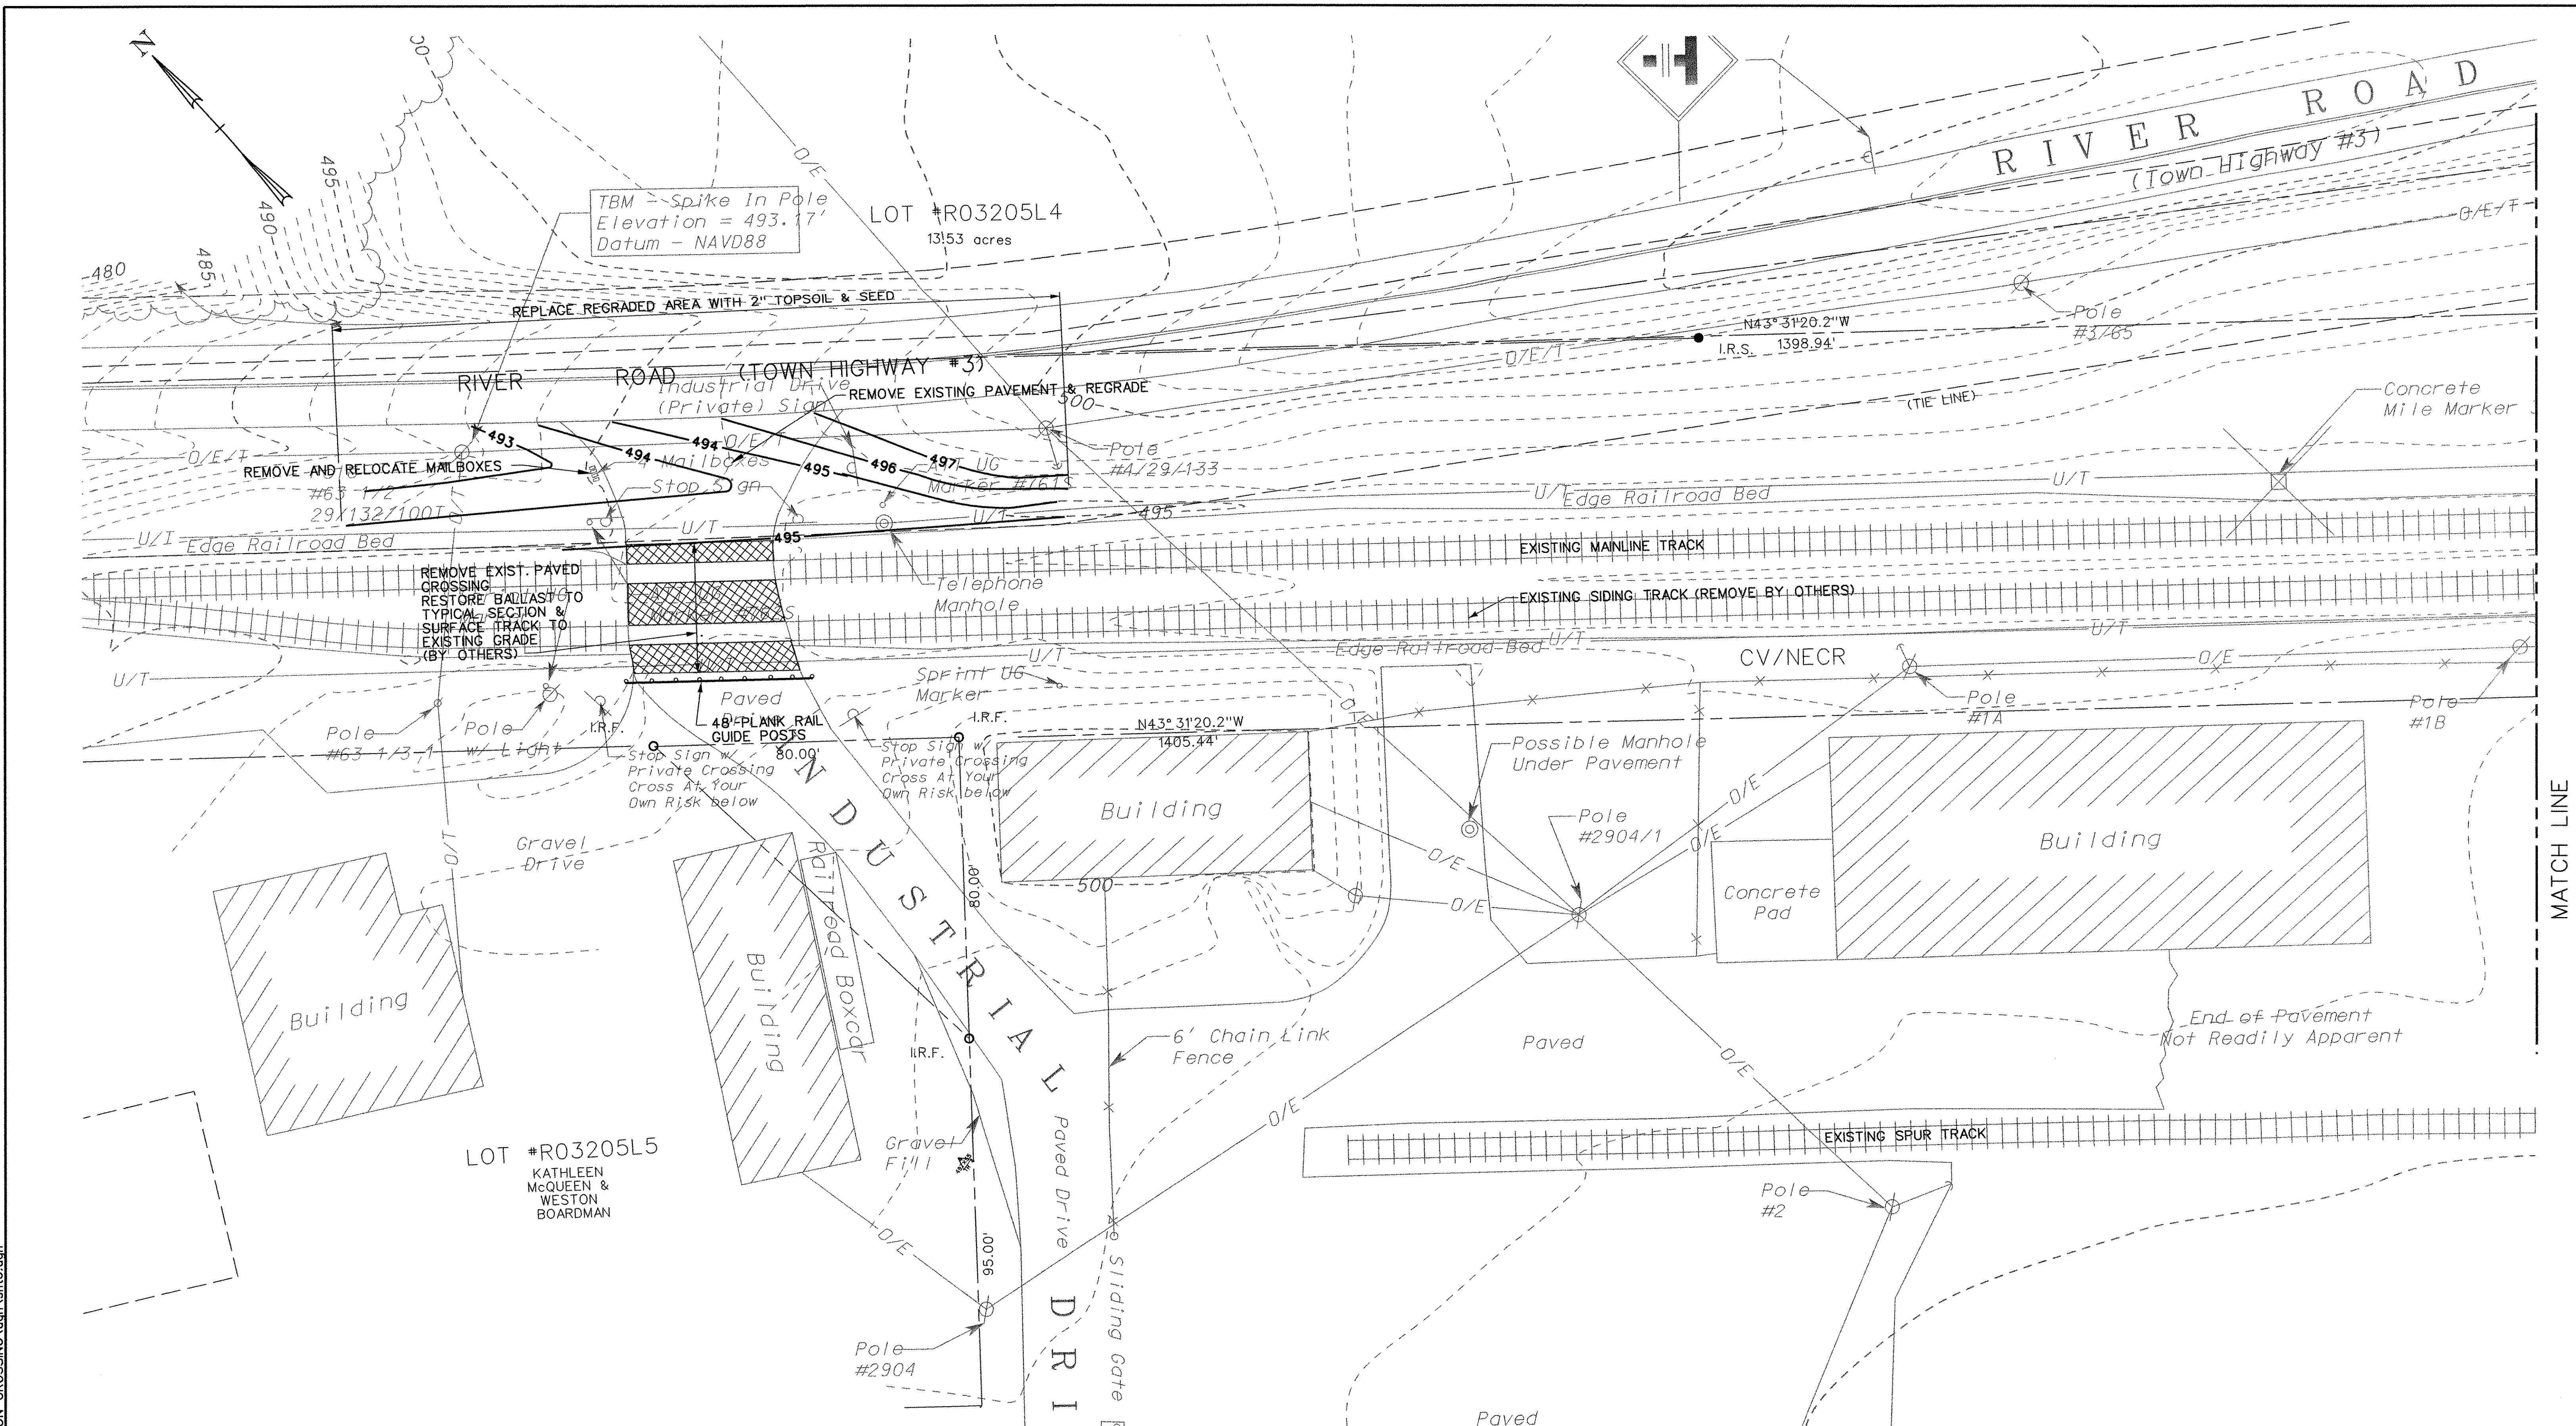


TBM - Spike In Pole
Elevation = 493.17'
Datum - NAVD88

LOT #R03205L4
13153 acres

LOT #R03205L5
KATHLEEN
MCQUEEN &
WESTON
BOARDMAN

DATUM
VERTICAL NAVD88 ± 0.5 FT.
HORIZONTAL SPC 1983

ORIGINAL PREPARED:		
DATE	REVISIONS	BY

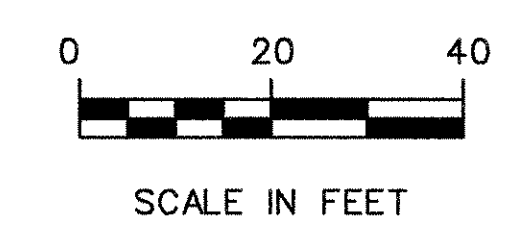

PLAN LAYOUT - SHEET 1 OF 3

PROJECT NAME: SHARON GRADE CROSSING
PROJECT NUMBER: STP2034 (13)S
FILE NAME: SHT6.DGN
PROJECT LEADER: R. O'BLENIS
DESIGNED BY: C. GLOVER
PLOT DATE: 06/13/03
DRAWN BY: J. DEROSIER
CHECKED BY: R. ORO
SHEET 6 OF 35