


CURVE DATA CV. NO. 1	CURVE DATA CV. NO. 2	CURVE DATA CV. NO. 3
Δ = 30°-00'-00"	Δ = 25°-44'-53.99"	Δ = 20°-00'-00"
R = 260.00'	R = 260.00'	R = 200.00'
T = 69.67'	T = 59.43'	T = 35.27'
L = 136.14'	L = 116.84'	L = 69.81'
E = 9.17'	E = 6.70'	E = 3.09'

DATUM	
VERTICAL	NAVD88 ± 0.5 FT.
HORIZONTAL	SPC 1983

ORIGINAL PREPARED:		
DATE	REVISIONS	BY

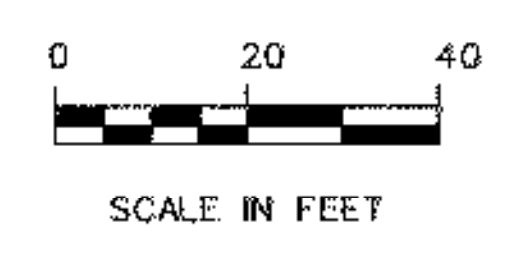

PLAN LAYOUT - SHEET 3 OF 3

PROJECT NAME: SHARON GRADE CROSSING	
PROJECT NUMBER: STP2034 (13)S	
FILE NAME: SHT8.DGN	PLOT DATE: 06/13/03
PROJECT LEADER: R. O'BLENIS	DRAWN BY: J. DEROSIER
DESIGNED BY: C. GLOVER	CHECKED BY: R. ORO
SHEET 8 OF 35	

06/13/03 PM
 M:\182737a_vt.cdl\mra\SHARON_CROSSING.dgn\SHTS.dgn