



09:07:58 AM
06/13/03
M:\187379_vt_rail\inda\SHARON_CROSSING.dgn_sht12.dgn

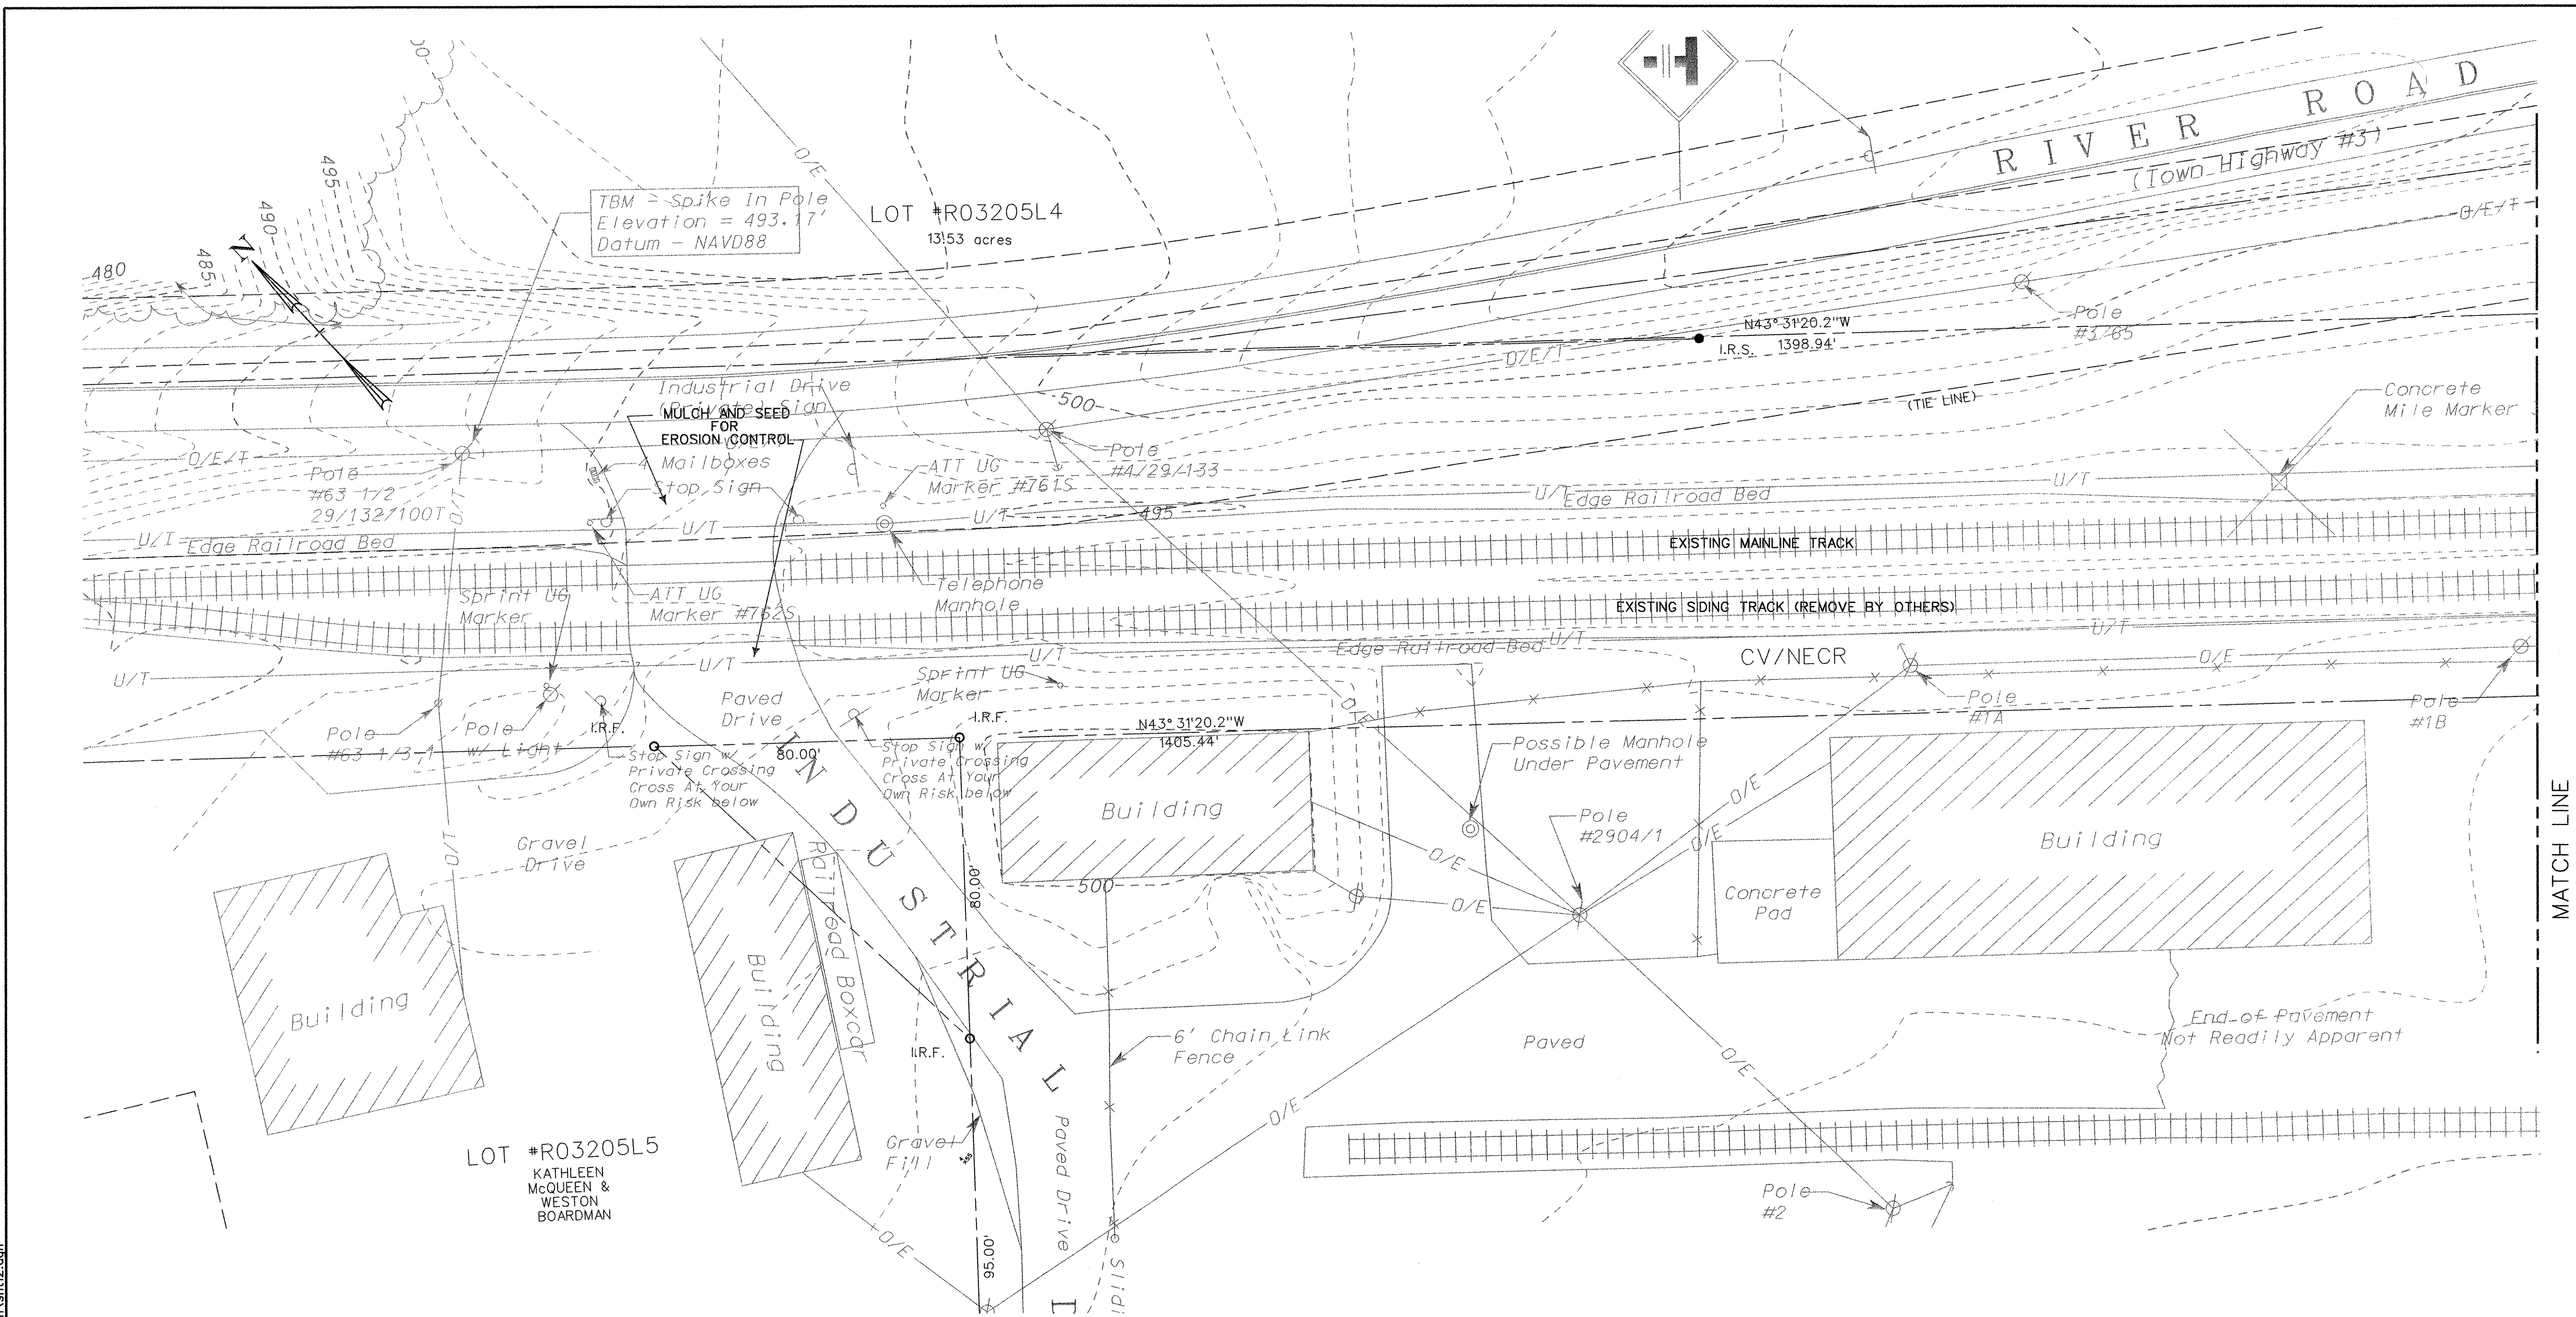

DATUM	
VERTICAL	NAVD88 ± 0.5 FT.
HORIZONTAL	SPC 1983

ORIGINAL PREPARED:		
DATE	REVISIONS	BY

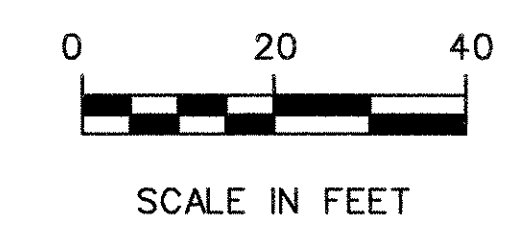

EROSION & SEDIMENT CONTROL PLAN			
SHEET 1 OF 3			
PROJECT NAME:	SHARON GRADE CROSSING		
PROJECT NUMBER:	STP2034 (13)S		
FILE NAME:	SHT12.DGN	PLOT DATE:	06/13/03
PROJECT LEADER:	R. O'BLENIS	DRAWN BY:	J. DEROSIER
DESIGNED BY:	C. GLOVER	CHECKED BY:	R. ORO
		SHEET 12 OF 35	