



STABILIZED CONSTRUCTION ENTRANCE

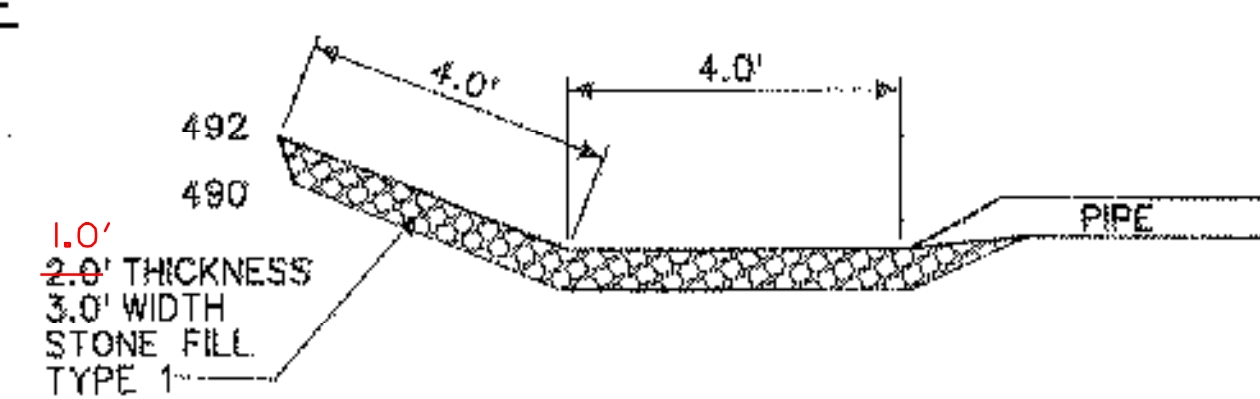

INLET DETAIL
STA. 19+25 LEFT

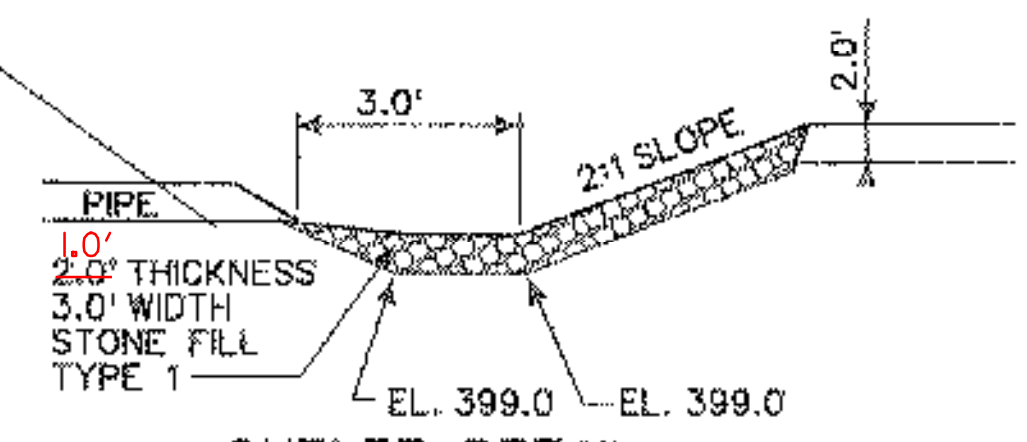

OUTLET DETAIL
STA. 19+25 RIGHT



SCALE IN FEET

DATUM

VERTICAL	NAVD88 ± 0.5 FT.
HORIZONTAL	SPC 1983

ORIGINAL PREPARED:		
DATE	REVISIONS	BY

**EROSION & SEDIMENT CONTROL PLAN
SHEET 2 OF 3**

PROJECT NAME:	SHARON GRADE CROSSING	
PROJECT NUMBER:	STP2034 (13)S	
FILE NAME:	SHT13.DGN	PLOT DATE: 06/13/03
PROJECT LEADER:	R. O'BLENIS	DRAWN BY: J. DEROSIER
DESIGNED BY:	C. GLOVER	CHECKED BY: R. ORO
		SHEET 13 OF 35