



M:\Projects\17_03_03\17_03_03\17_03_03\SHARON_CROSSING\dm\sh120.dgn
 06/13/03
 11:17:38 AM

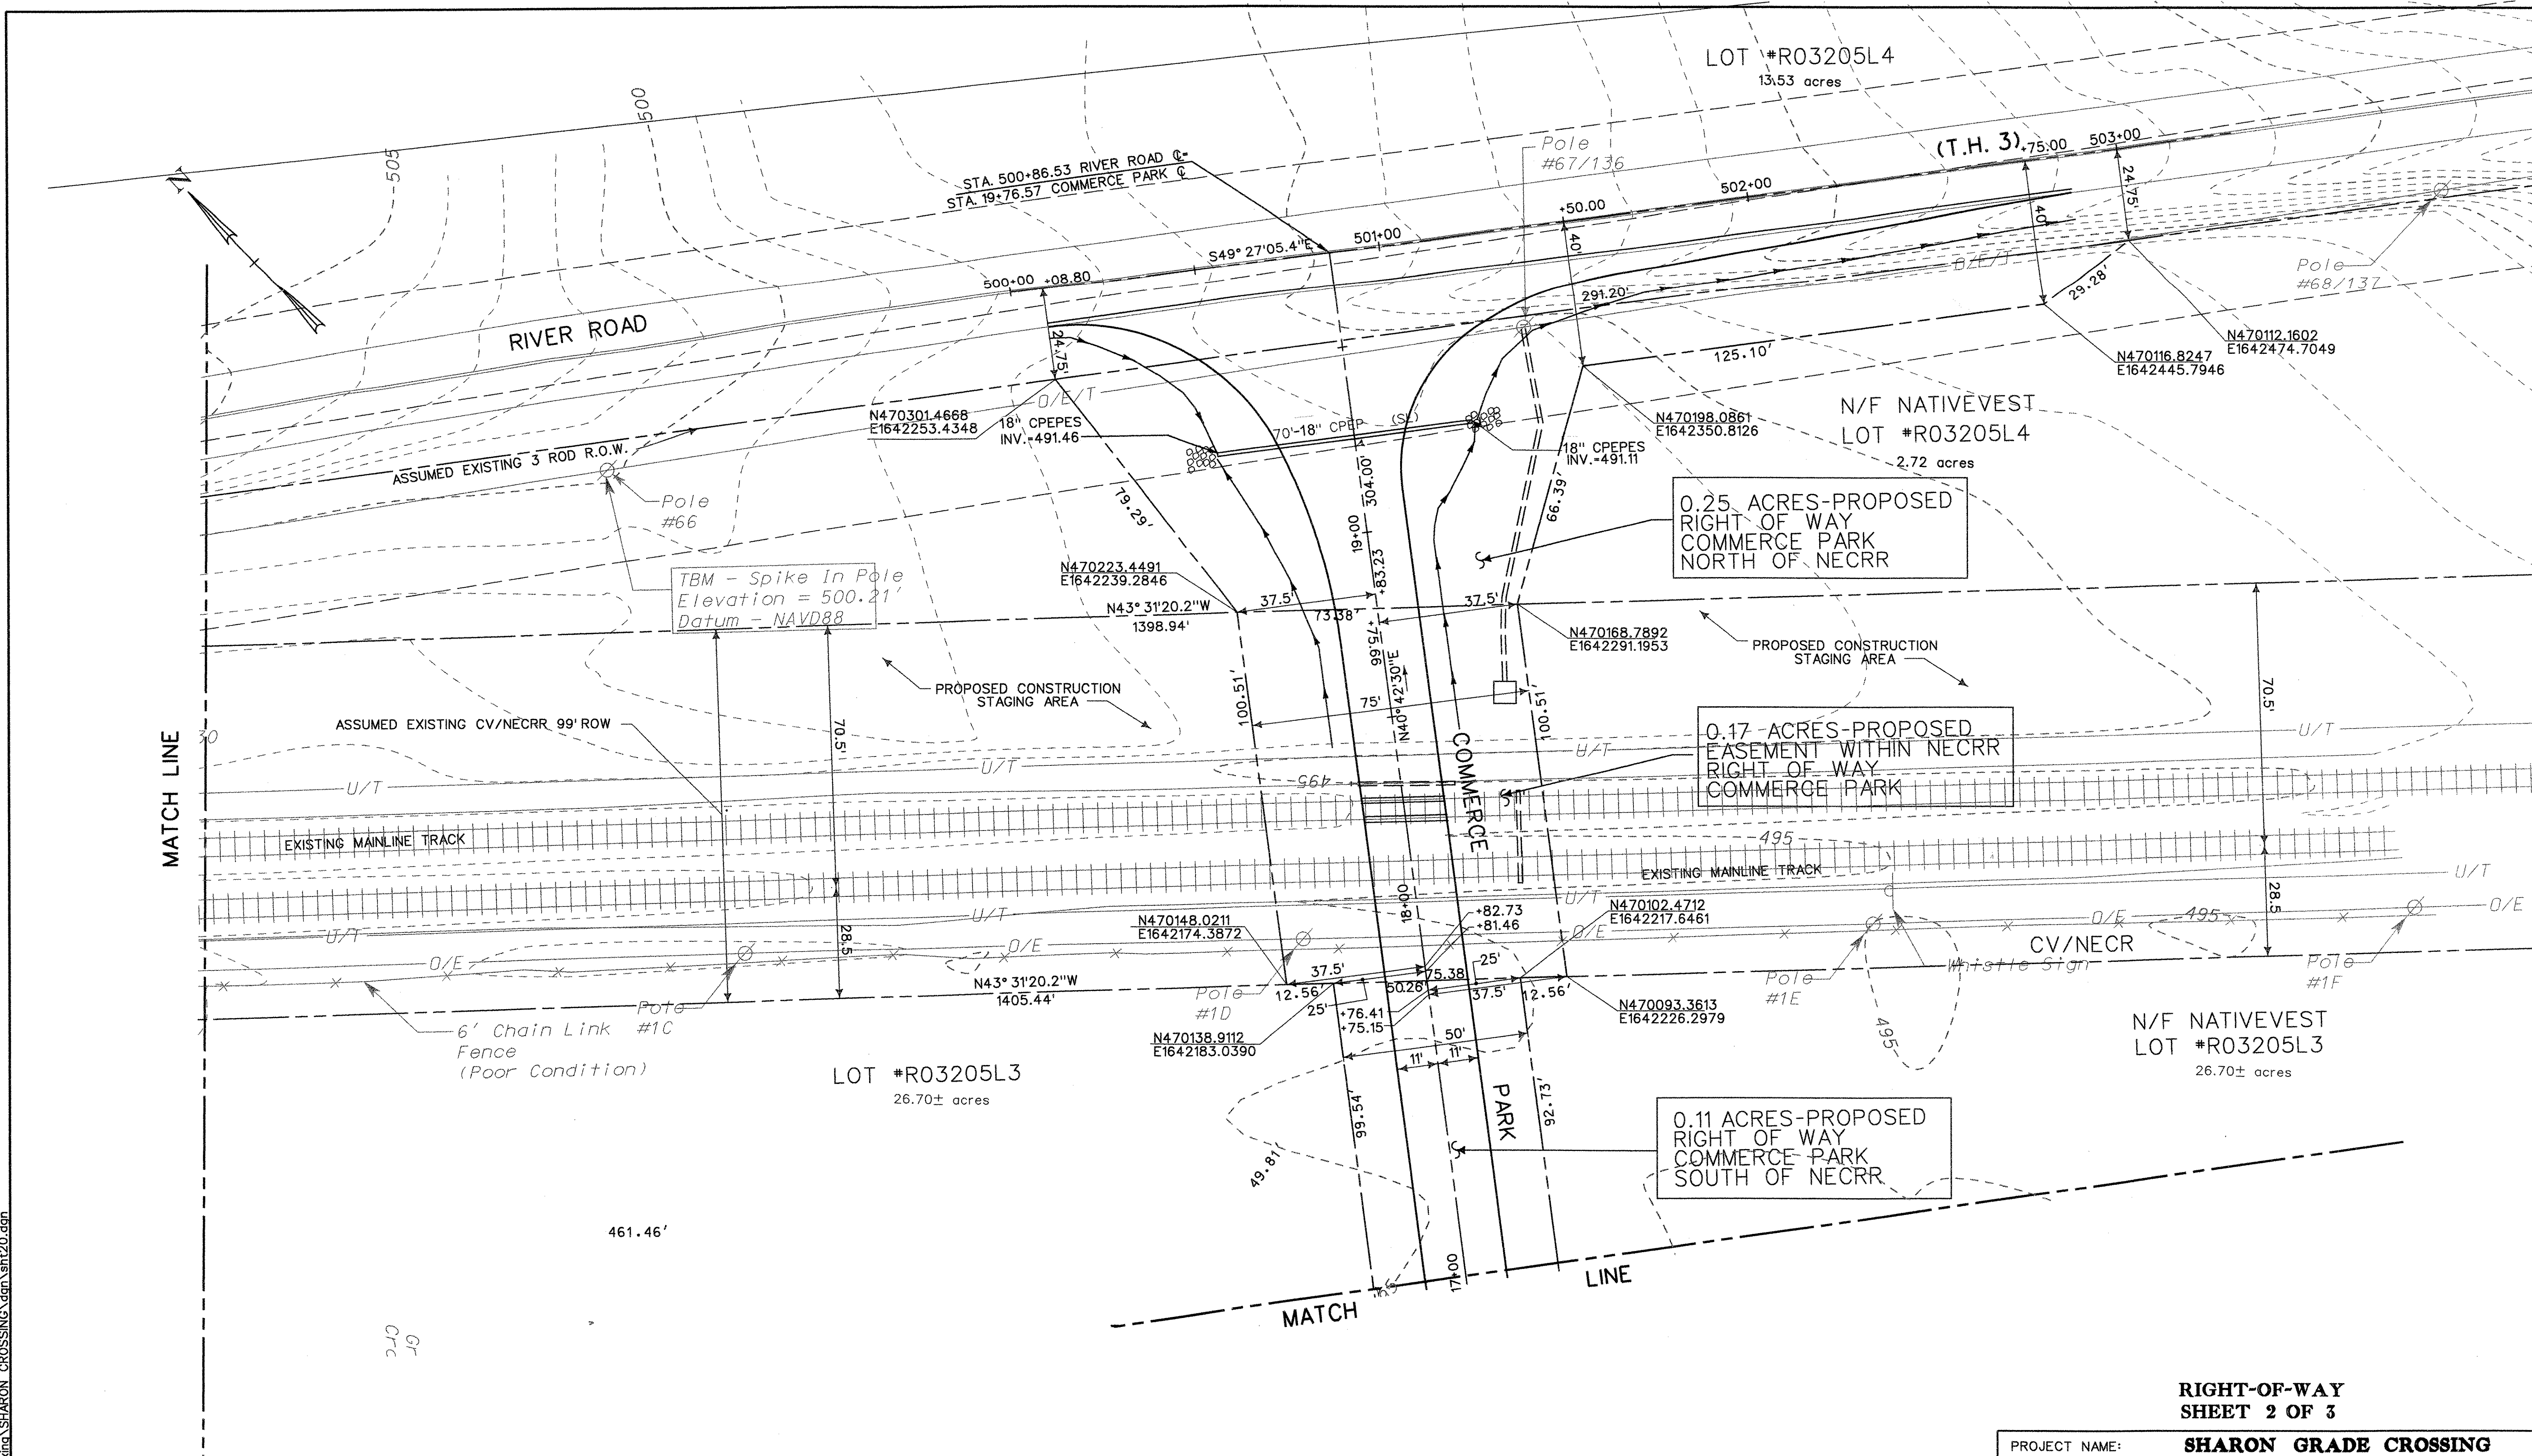

DATUM
 VERTICAL NAVD88 ± 0.5 FT.
 HORIZONTAL SPC 1983

ORIGINAL PREPARED:		
DATE	REVISIONS	BY

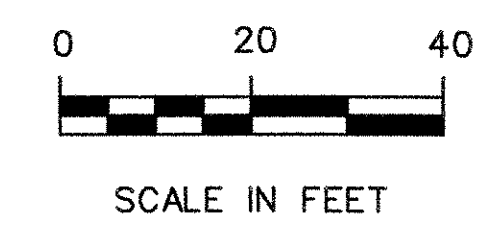

RIGHT-OF-WAY SHEET 2 OF 3

PROJECT NAME:	SHARON GRADE CROSSING	
PROJECT NUMBER:	STP2034 (13)S	
FILE NAME:	SHT20.DGN	PLOT DATE: 06/13/03
PROJECT LEADER:	R. O'BLENIS	DRAWN BY: M. MOORE
DESIGNED BY:	C. GLOVER	CHECKED BY: R. ORO
		SHEET 20 OF 35