


CROSS SECTIONS - COMMERCE PARK SHEET 2 OF 2

DATUM
 VERTICAL NAVD88 ± 0.5 FT.
 HORIZONTAL SPC 1983

ORIGINAL PREPARED:		
DATE	REVISIONS	BY

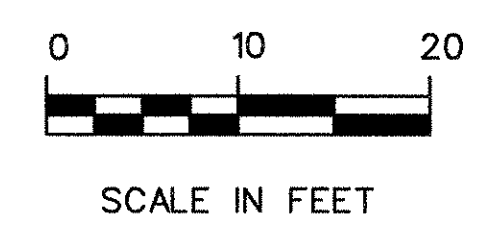

PROJECT NAME: **SHARON GRADE CROSSING**
 PROJECT NUMBER: STP2034 (13)S
 FILE NAME: SHT23.DGN
 PROJECT LEADER: R. O'BLENIS
 DESIGNED BY: C. GLOVER
 PLOT DATE: 06/13/03
 DRAWN BY: J. DEROSIER
 CHECKED BY: R. ORO
 SHEET 23 OF 35

U:\1114 AM 06/13/03 M:\18737s_v1_rail\sharon_crossing\sharon_sht23.dgn